
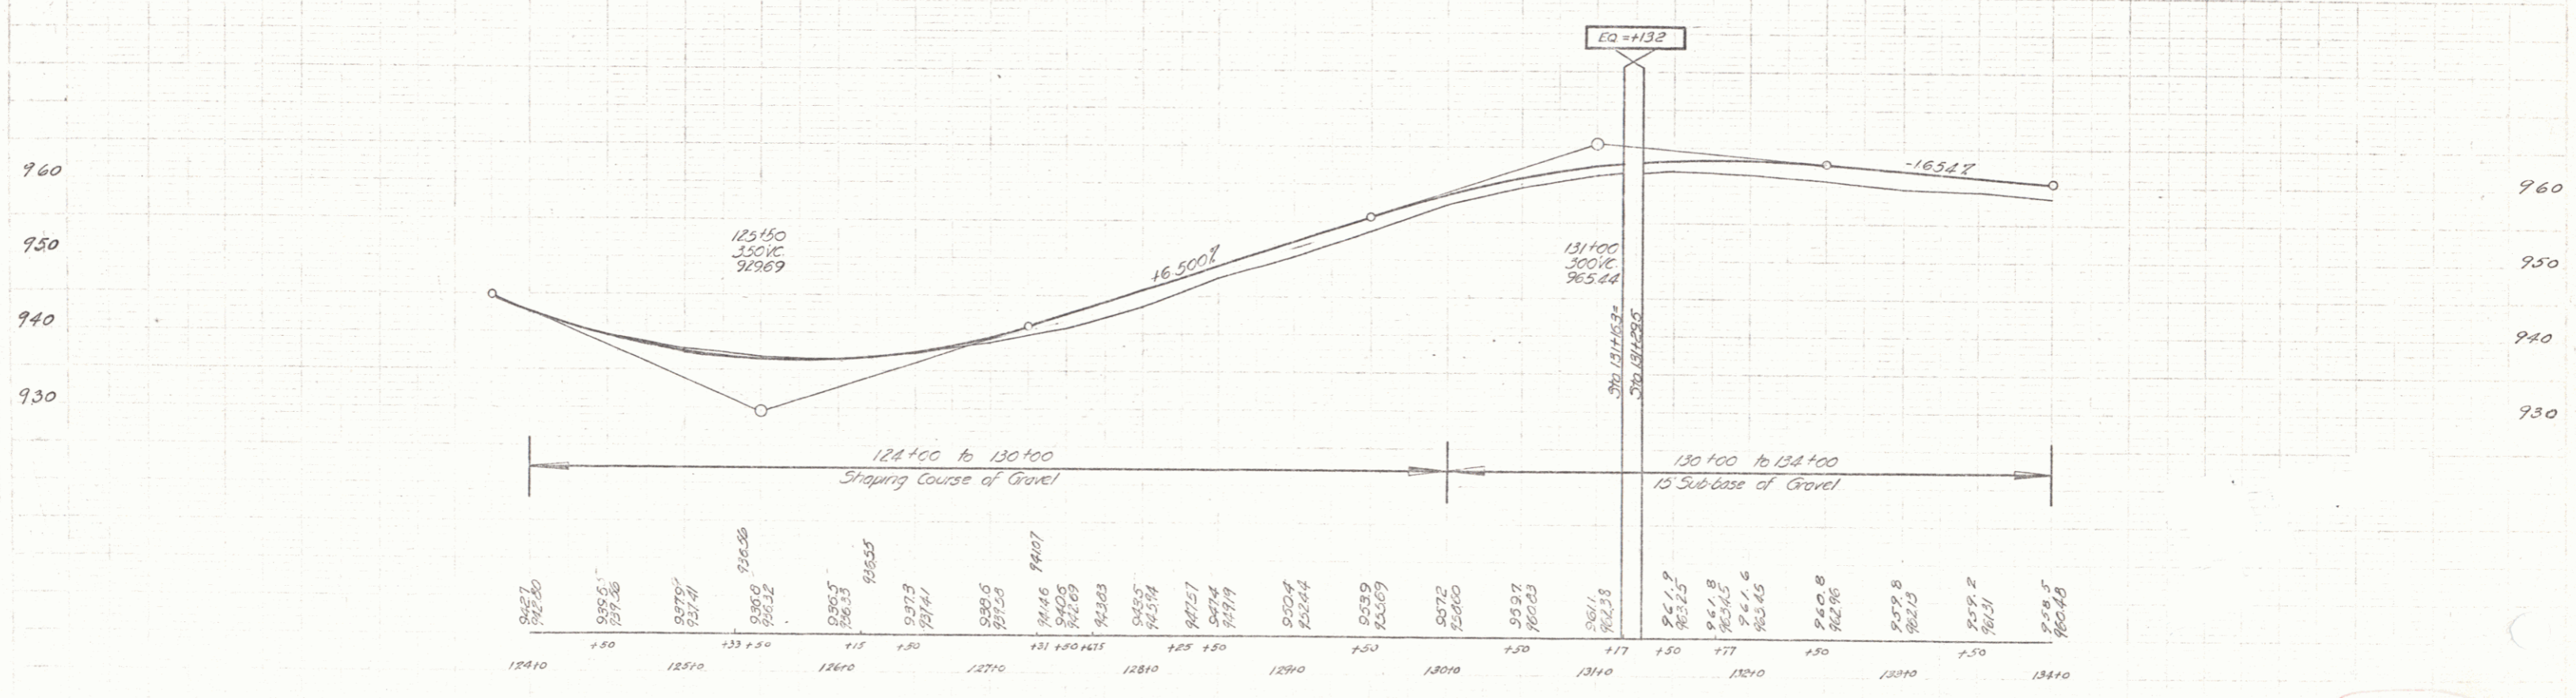


PAUL BILSON, Surveyor
H. F. GALLAGHER & SONS
TRACED H. F. GALLAGHER & SONS

PAUL BILSON, Surveyor
H. F. GALLAGHER & SONS
TRACED H. F. GALLAGHER & SONS

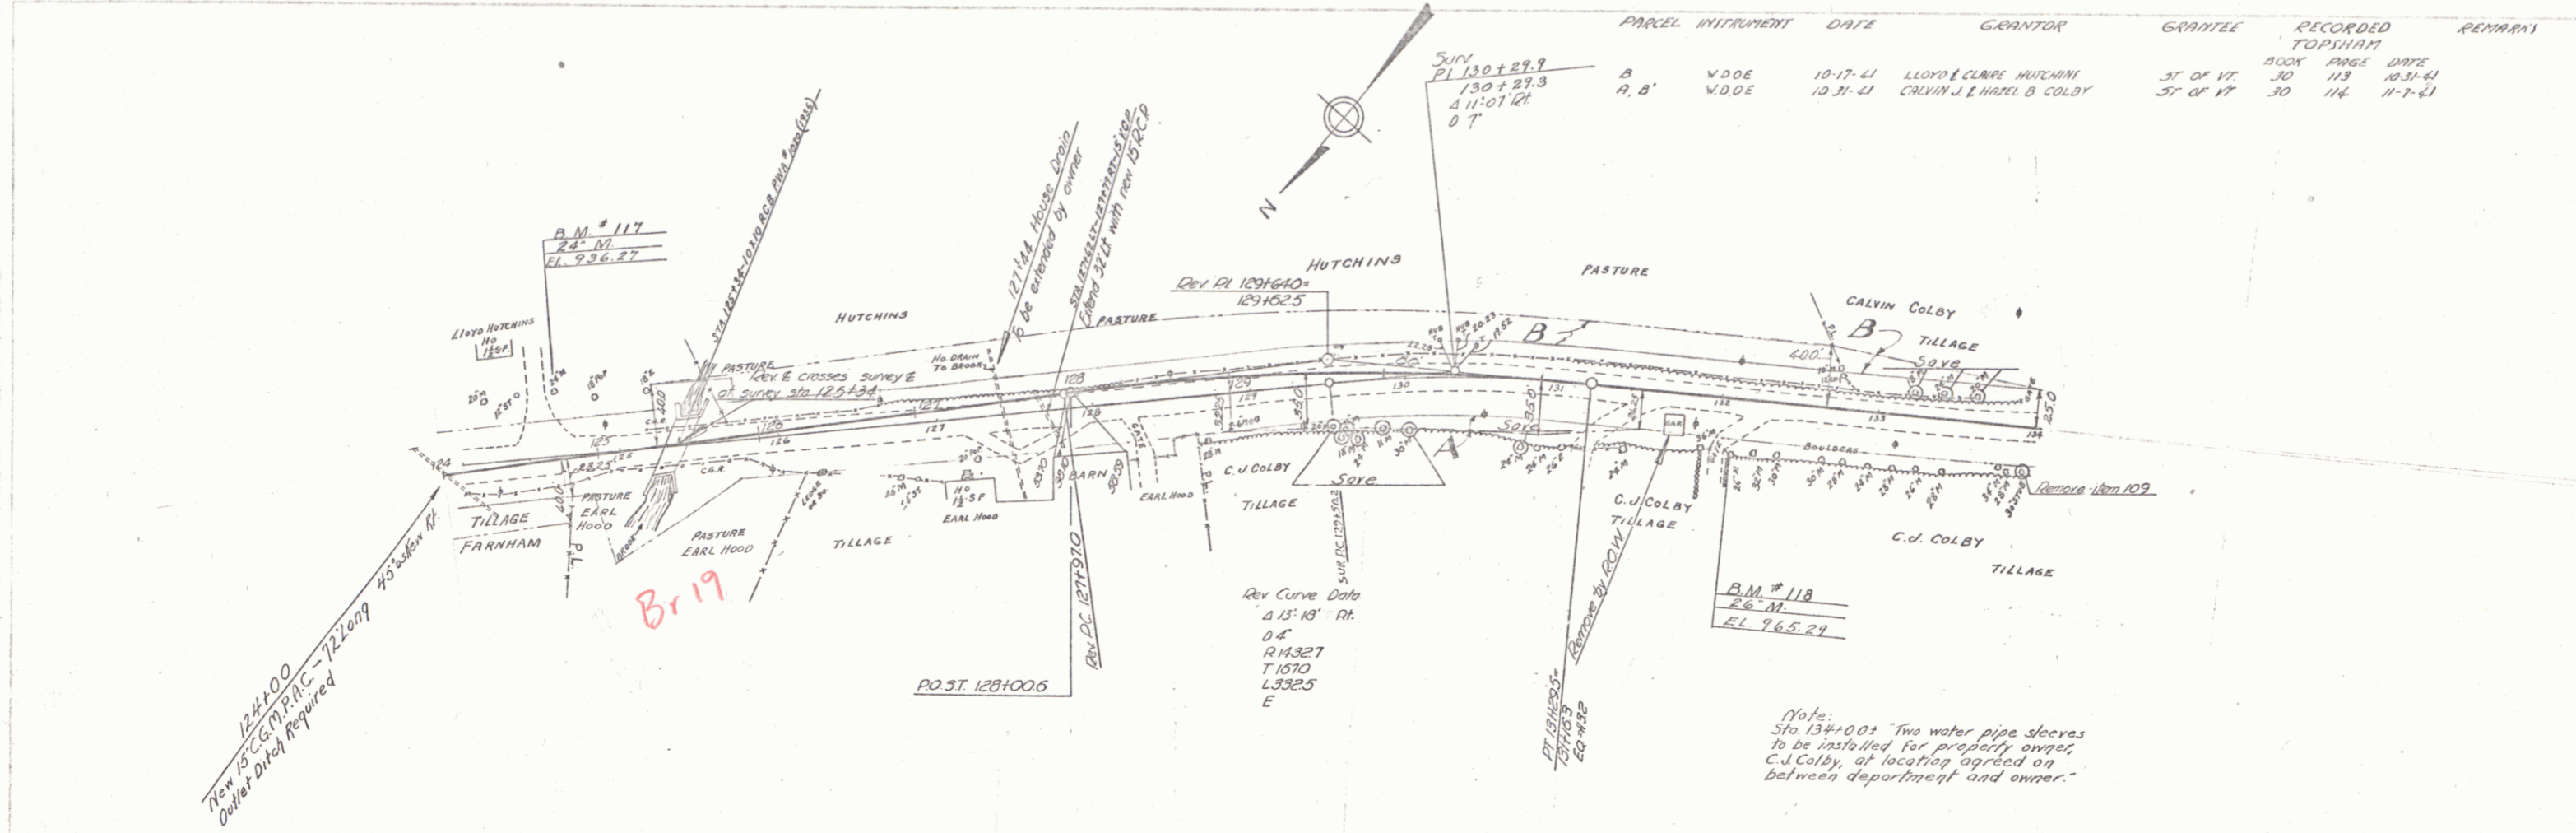

B.M. #117 SPIKE IN ROOT 24" M. 40' LT. STA 124+62 ELEV 936.27
 B.M. #118 SPIKE IN ROOT 26" M. 31' RT. STA 132+06 ELEV 965.29

TOPSHAM
 SERIES No 107A
 SHEET 7 OF 34