

INDEX OF SHEETS

SHEET NO.	1	TITLE PAGE
"	"	2 TYPICAL CROSS-SECTION OF IMPROVEMENT
"	"	3 PLAN AND PROFILE STA 0+50 TO 4+00
"	"	4 S.T.B. 20-30' SPAN 15° SKEW WITH GRAVEL
"	"	5 S.B. 2 TYPICAL DETAILS
"	"	6 S.B. 3 SKEW ENDS
"	"	7 S.B. 5 CABLE RAIL
"	"	8 S.A.R. 14' HEIGHT T BEAM 15° SKEW
"	"	9 S.A.R. 14' HEIGHT T BEAM SQUARE
"	"	10-11 CROSS SECTIONS
"	"	12 S19 STANDARD STRUCTURES

FED. ROAD DIST. NO.	STATE	FED. AID PROJ. NO.	FISCAL YEAR	SHEET NO.	TOTAL SHEETS
9	VT.	RR 13A	1928	1	10



STATE OF VERMONT
 STATE HIGHWAY DEPARTMENT
 PLAN AND PROFILE OF PROPOSED
 STATE HIGHWAY
 FEDERAL AID PROJECT

TOPSHAM

WAITS RIVER BRIDGE OVER WAITS RIVER
 LOCATED IN WEST TOPSHAM VILLAGE
 LENGTH 350 FEET = 0.066 MILES

LAYOUT
 SEE SHEET 3

SCALES
 PLAN 1" = 20 FT
 VERT 1" = 20 FT
 HORIZ. 1" = 20 FT
 SECTIONS 1" = 5 FT

This project to be constructed in accordance with Standard Specifications on file with the U.S. Bureau of Public Roads, Approved 7/1/26.

Structures on this project to be constructed in accordance with details given on Standard Structure Sheets, Series Nos. S17-15-19

DISTRICT No. 7
 BRIDGE No. 21
 TOPSHAM

RIGHT-OF-WAY DIVISION
 TOWN FILE
 PERPETUAL
 Town of UT 25
 (To Be Returned To R.O.W. Division)
 MP 5.128 - 5.061
 Br 20

APPROVED: June 30 1928
H. E. Sargent
 CHIEF ENGINEER

SUBMITTED BY ORDER OF THE STATE HIGHWAY BOARD

S. B. Palmer
 COMMISSIONER OF HIGHWAYS

RECOMMENDED
 DISTRICT ENGINEER
 BUREAU OF PUBLIC ROADS

RECOMMENDED FOR APPROVAL
 CHIEF ENGINEER
 BUREAU OF PUBLIC ROADS

APPROVED
 DIRECTOR - BUREAU OF PUBLIC ROADS

SERIES F, No. 79-A FILED
 SHEET 1 OF 10

CONVENTIONAL SIGNS

COUNTY LINE	_____	GROUND ELEVATION	BATHY LINE
TOWN LINE	_____	GRADE ELEVATION	GRADE LINE
FENCE LINE	_____		
STONE WALL	_____		
UNFENCED PROPERTY	_____		
GUARD RAIL	_____		
TRAVELED WAY	_____		
RAILROAD	_____		
RETAINING WALL	_____		
CENTER LINE	_____		
SURVEY LINE	_____		
CULVERT	_____		
DROP INLET	_____		
TROLLEY POLE	_____		
POWER POLE	_____		
TELEPHONE POLE	_____		
TREES	_____		
HEDGE	_____		

CURVE DATA

DEFLECTION ANGLE	Δ
DEGREE OF CURVE	D
RADIUS OF CURVE	R
TANGENT DISTANCE	T
LENGTH OF CURVE	L
EXTERNAL DISTANCE	E
POINT OF INTERSECTION	P. I.
POINT OF CURVE	P. C.
POINT OF TANGENT	P. T.
POINT ON TANGENT	P. O. T.

Proj # : FR19A
 Plan # : DOR312


DIST. # 7 PLANS

CABLE GUARD RAIL REQUIRED
 LEFT
 Sta. 1+76 to Sta. 4+00 = 224 Lin. Ft.
 RIGHT
 Sta. 1+76 to Sta. 2+64 = 88 Lin. Ft.
 Total: 312 Lin. Ft.

Length of Bridge = 33 Ft. = 0.006 miles
 Length of Approaches = 317 Ft. = 0.60 miles
 Total length of Project = 350 Ft. = 0.66 miles

Gravel Surface Course Flag
 Estimated Quantity 210 Cu Yds.

SHEETS TO BE USED
 Series 37-B 20 No. 30' span 15' skew with gravel
 37-B 20 No. 30' span 15' skew with gravel
 S.A.R. No. 14' Height 7' Clear 15' Skew
 S.A.R. No. 14' Height 7' Clear 15' Skew
 DIST. NO. 7
 DATE 1928 3 10

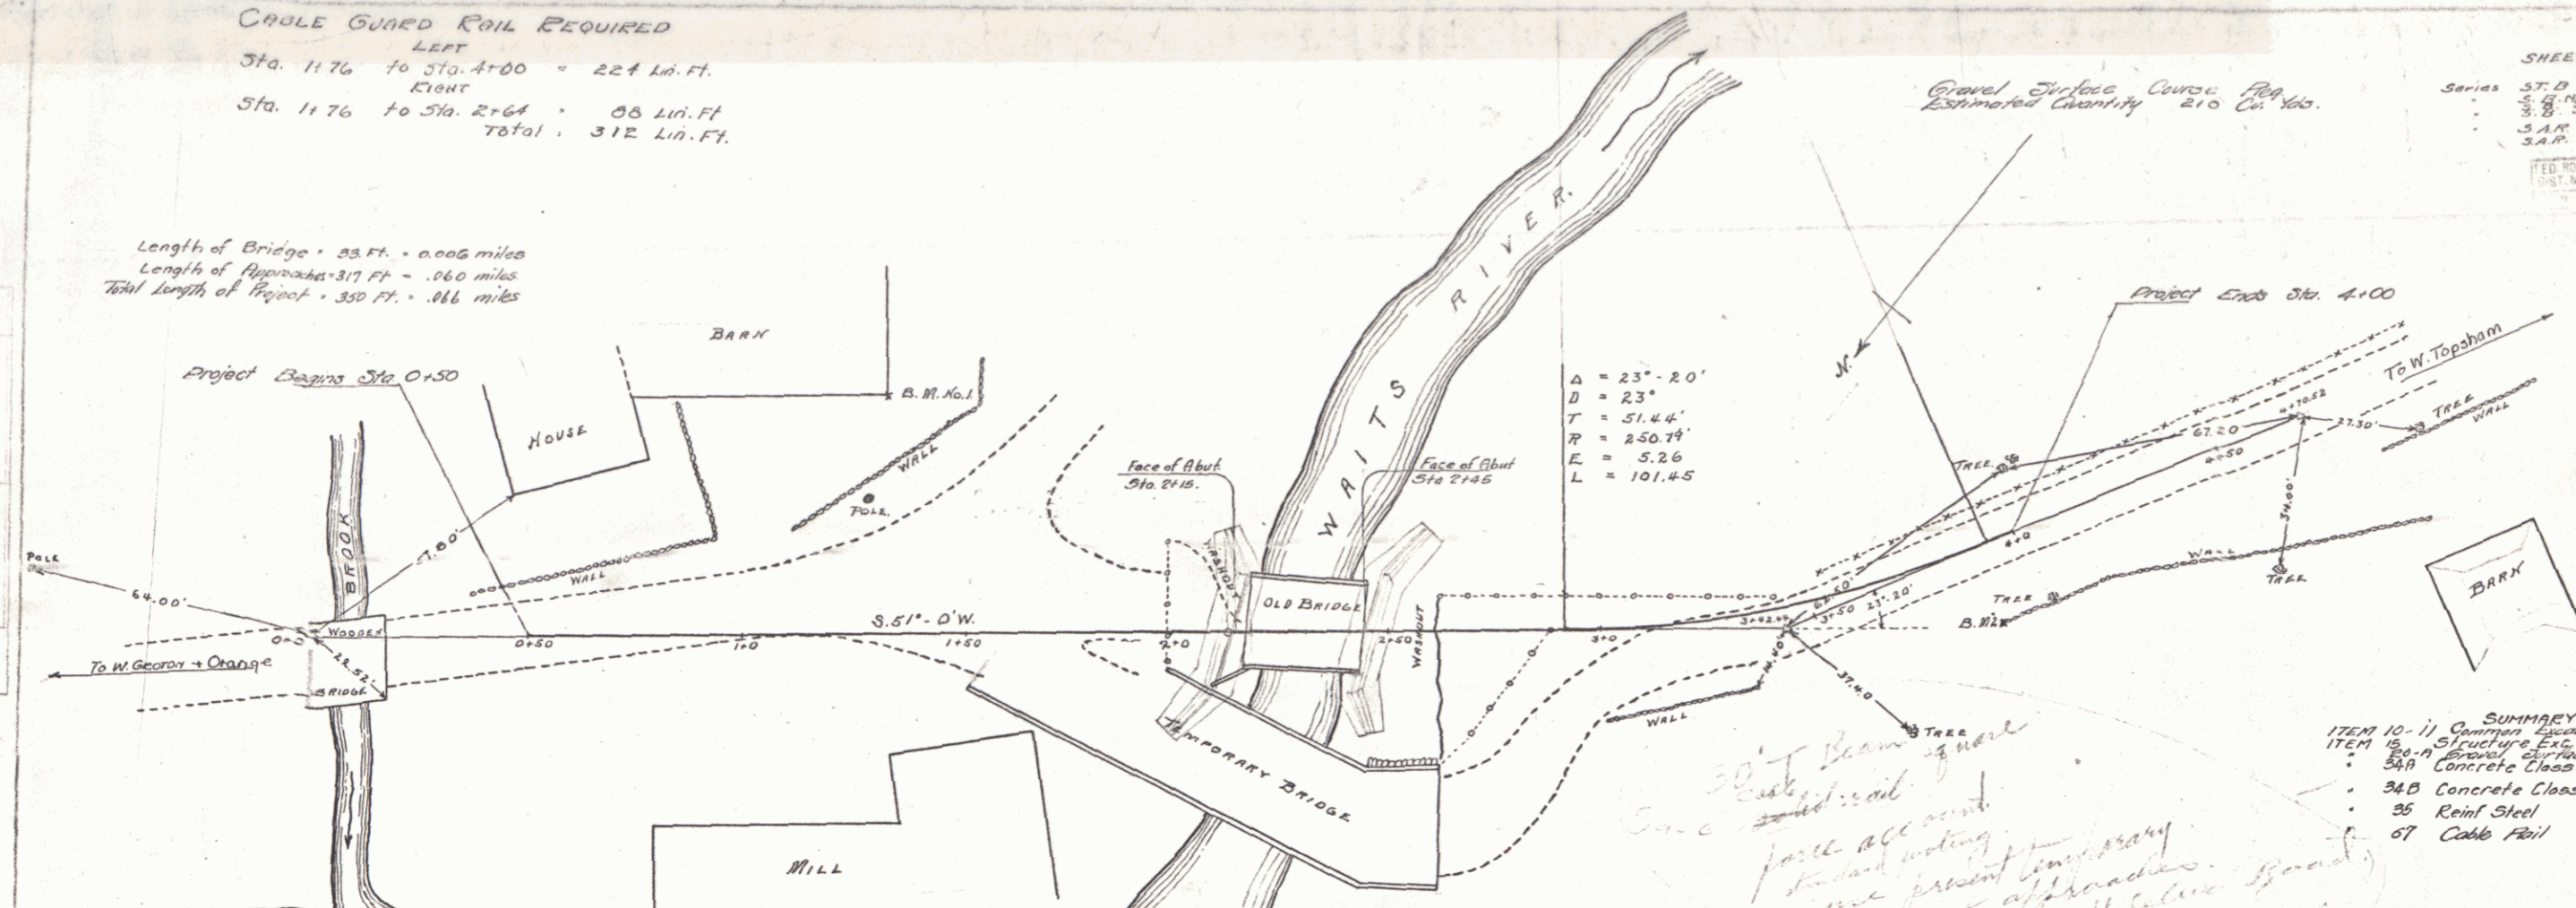


$\Delta = 23^\circ - 20'$
 $D = 23'$
 $T = 51.44'$
 $R = 250.74'$
 $E = 5.26'$
 $L = 101.45'$

SUMMARY OF QUANTITIES

ITEM 10-11	Concrete	cu yds.	710
ITEM 12	Structure Exp.	cu yds.	330
ITEM 13	Gravel Surface Course	" "	210
	Concrete Class A	" "	39
	Concrete Class B	" "	196
	Rein. Steel	lbs.	2,110
	Cable Rail	Lin. Ft.	312

B.M. No. 1. ELEV. 10.00
 PRINT MARK ON B.C. STONE
 CORNER BARN STA. 15 = 38.04
 Project Begins Sta. 0+50

B.M. No. 2. ELEV. 10.10
 PRINT MARK ON B.C. STONE AT
 CORNER OF WALL STA. 1+66 19.0'R.

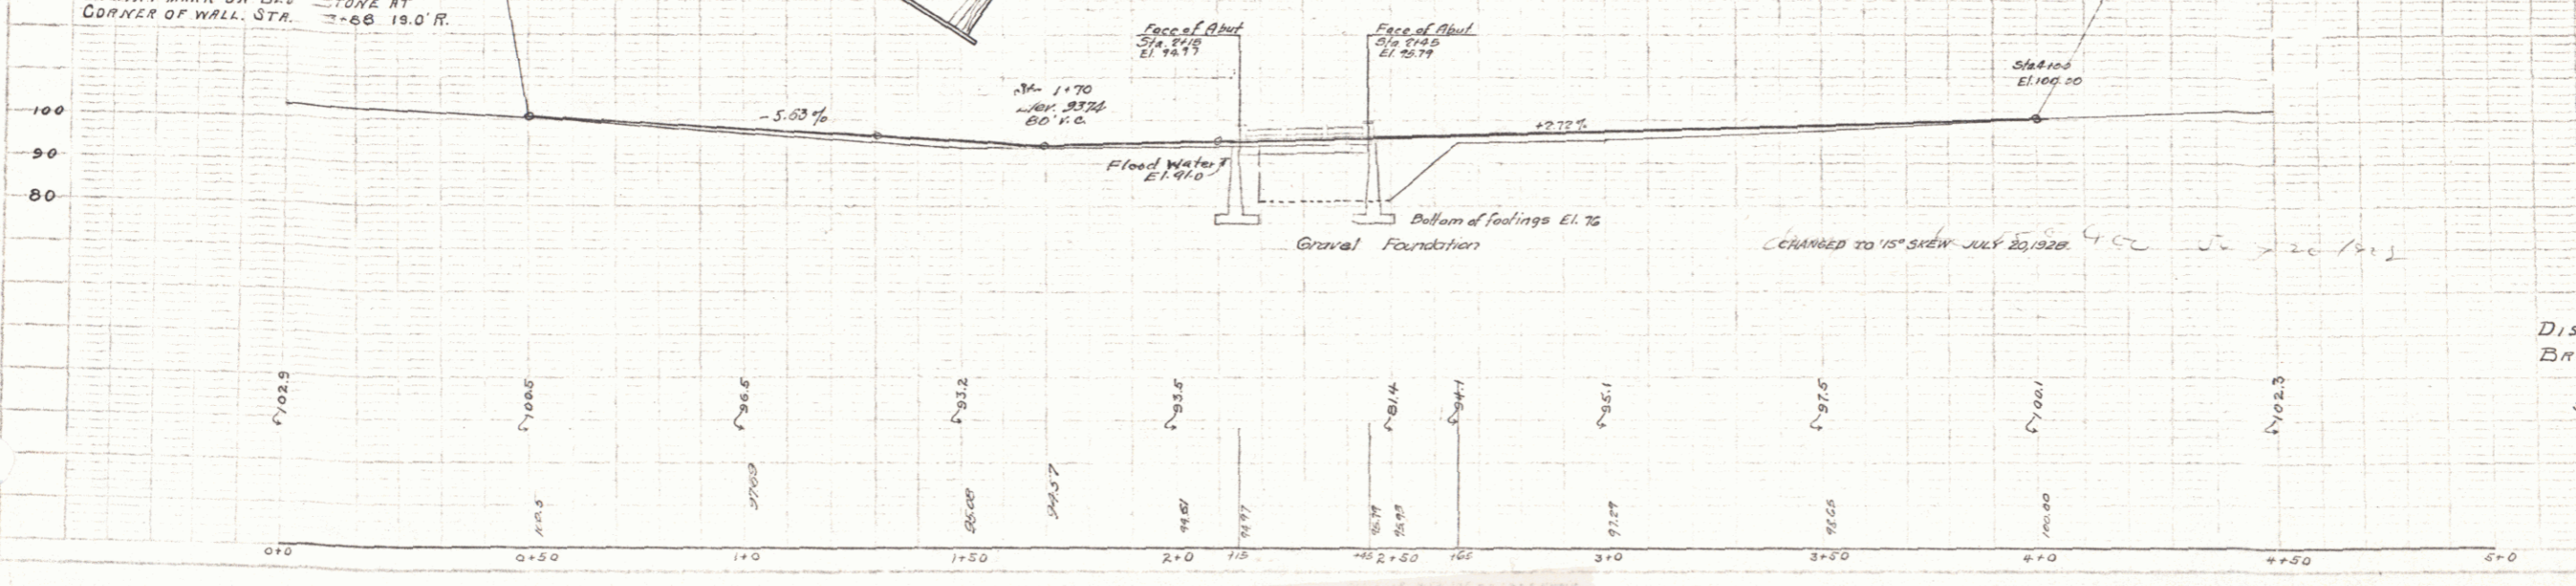

Correct
 G. D. Bishop
 Bridge Engineer

DISTRICT NO. 7
 BRIDGE NO. 21
 TOP-SHAFT
 Scale 1" = 20'
 Vertical 1" = 20'

SHEET 3 OF 10 SHEETS