
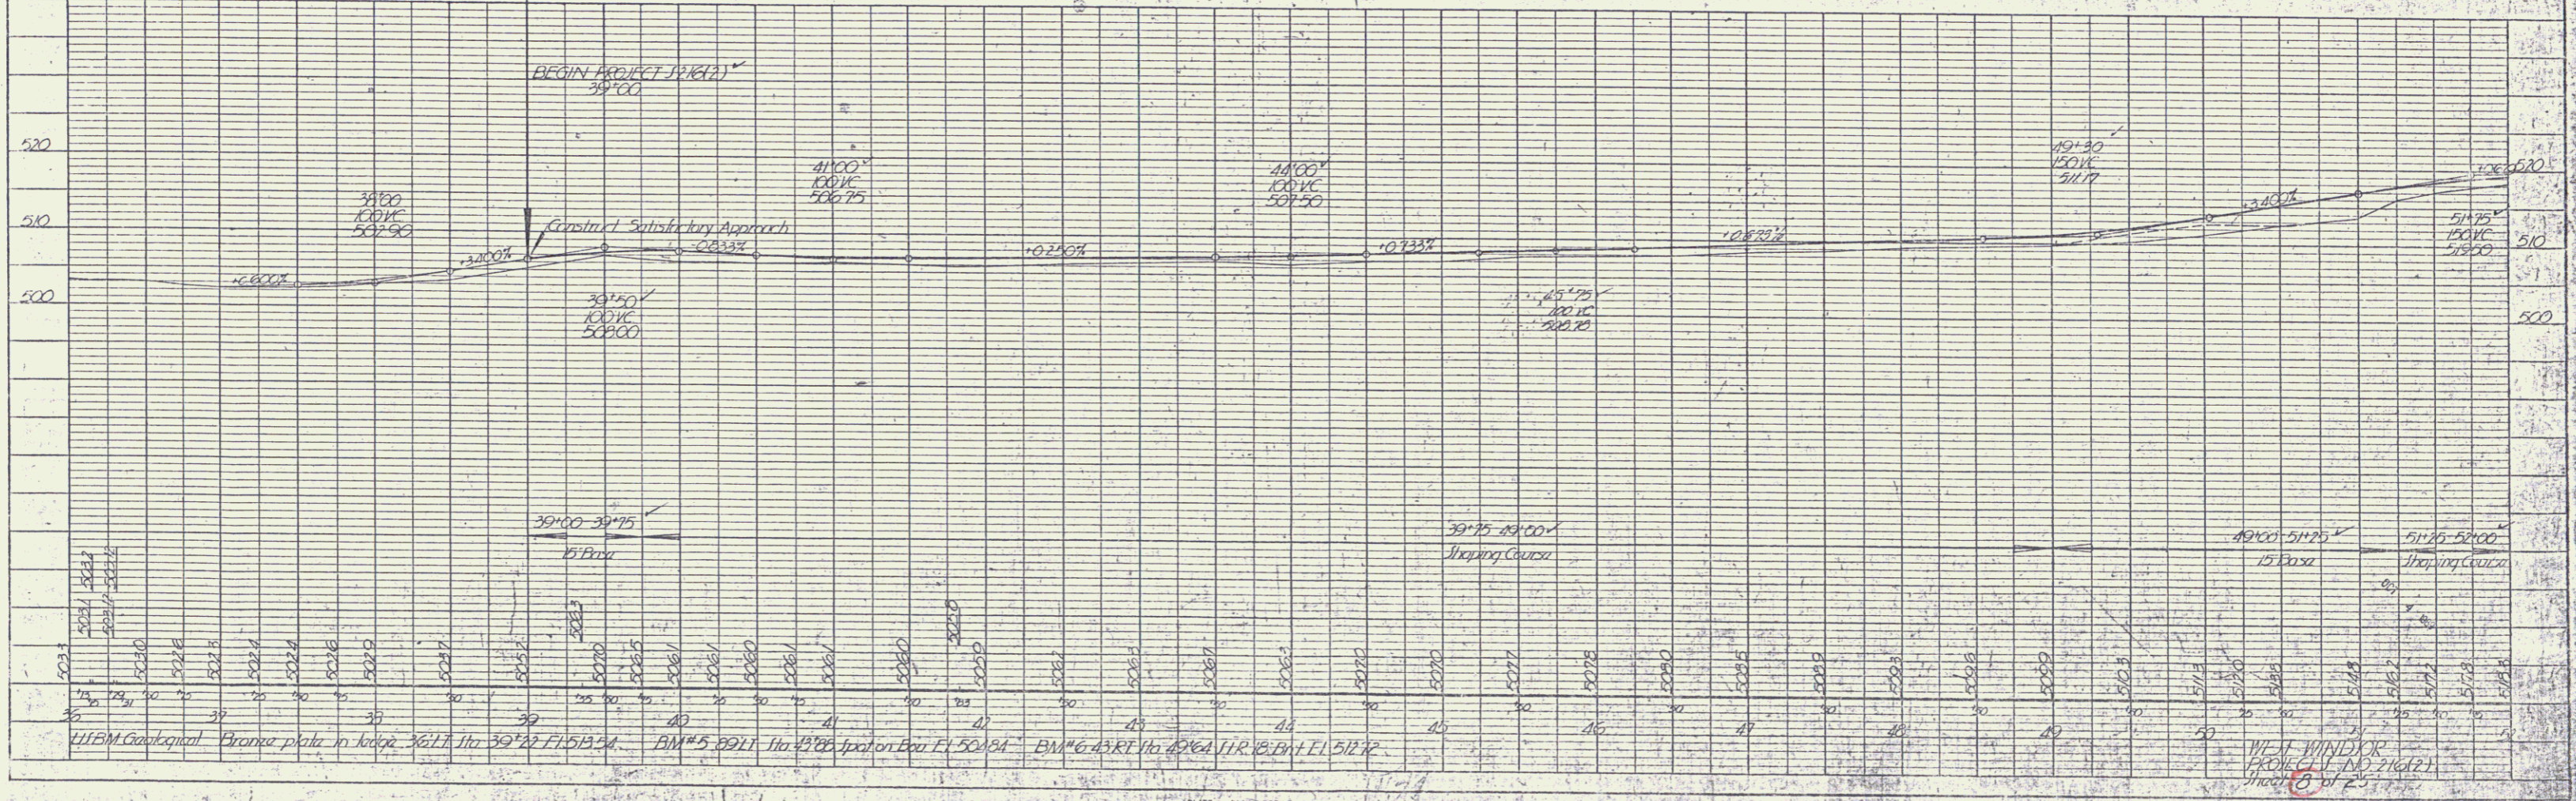


CONSTRUCT DRAWS
 38+90 LT ✓
 39+03 RT ✓
 39+75 RT ✓
 40+75 RT ✓
 41+00 RT ✓
 43+0 LT ✓
 49+0 LT ✓

Approaches
 36+0 to 39+0 Gravel by Town
 Surfaced to class gravel gap.
 49+60 to 50+30 RT
 51+0 to 51+25 RT

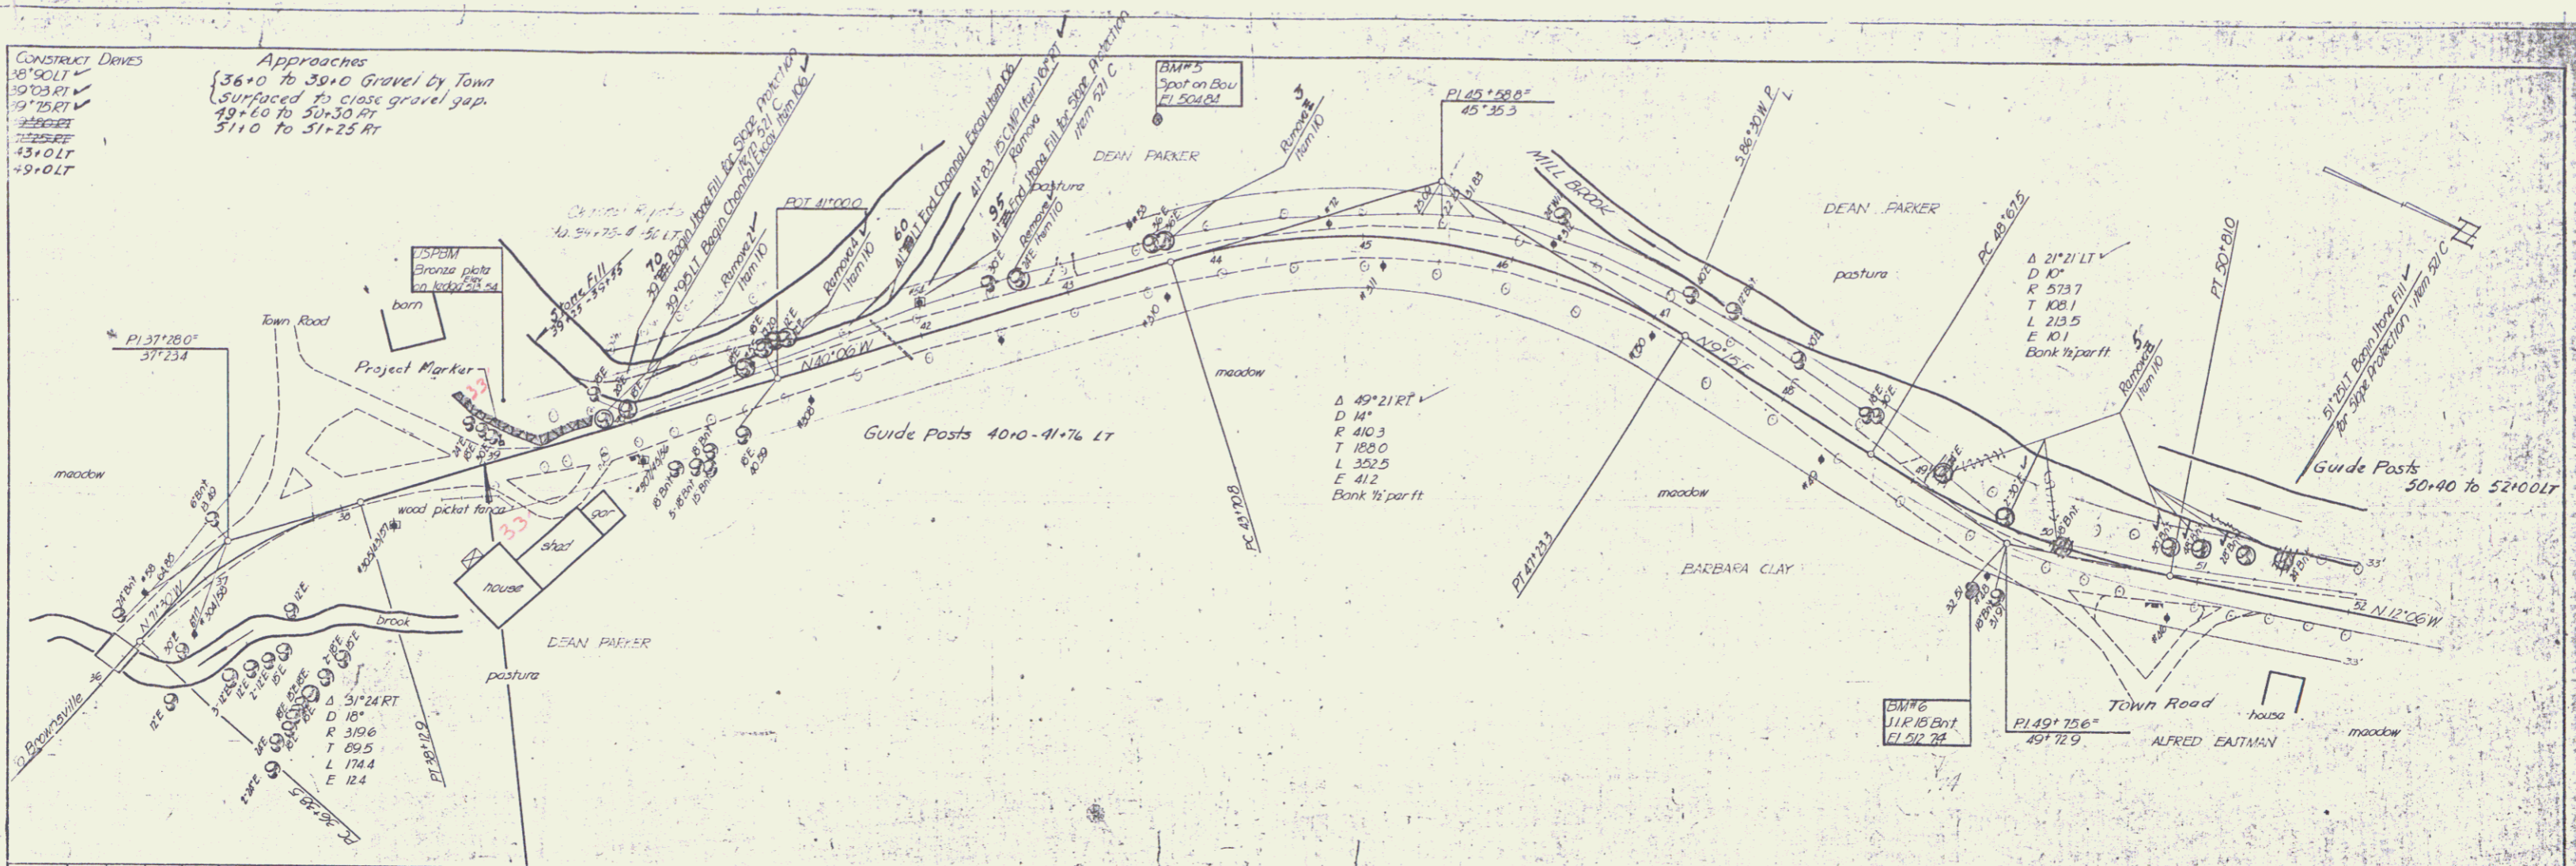

DATE: 11/11/11
 DRAWN BY: J. WINDYKOR
 CHECKED BY: J. WINDYKOR
 IN CHARGE: J. WINDYKOR

DATE: 11/11/11
 DRAWN BY: J. WINDYKOR
 CHECKED BY: J. WINDYKOR
 IN CHARGE: J. WINDYKOR

WBM Geological Bronze plate in Judge 36 LT Sta 39+22 PI 519.54
 BM#5 2011 Sta 43+22 Top on Bou PI 504.84
 BM#6 43 RT Sta 42+64 IIR 18 Bnt PI 512.72
 W.M. WINDYKOR PROJECT NO. 216(2) sheet 10 of 25