

FLAIR
 DRAWN BY: A. HULL
 CHECKED BY: HULL
 DATE: 12/1/73

PROFILE
 DRAWN BY: A. HULL
 CHECKED BY: HULL
 DATE: 12/1/73

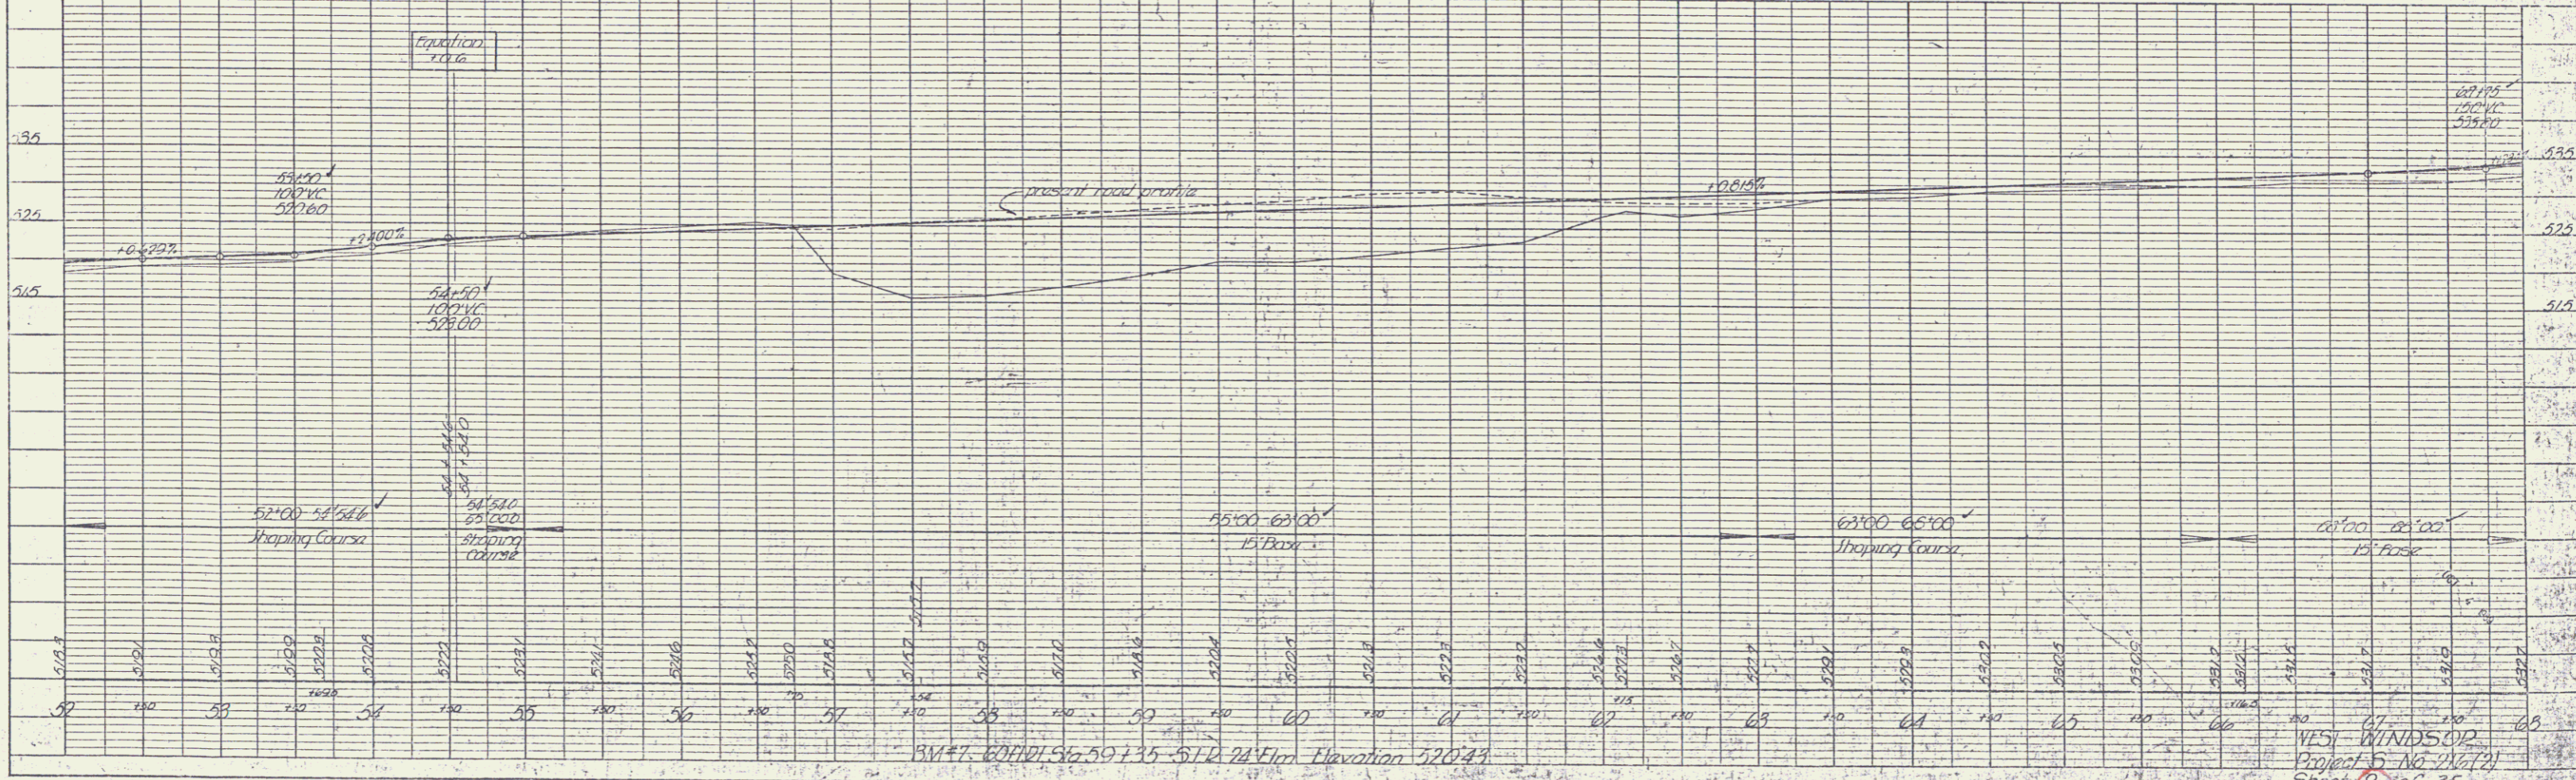
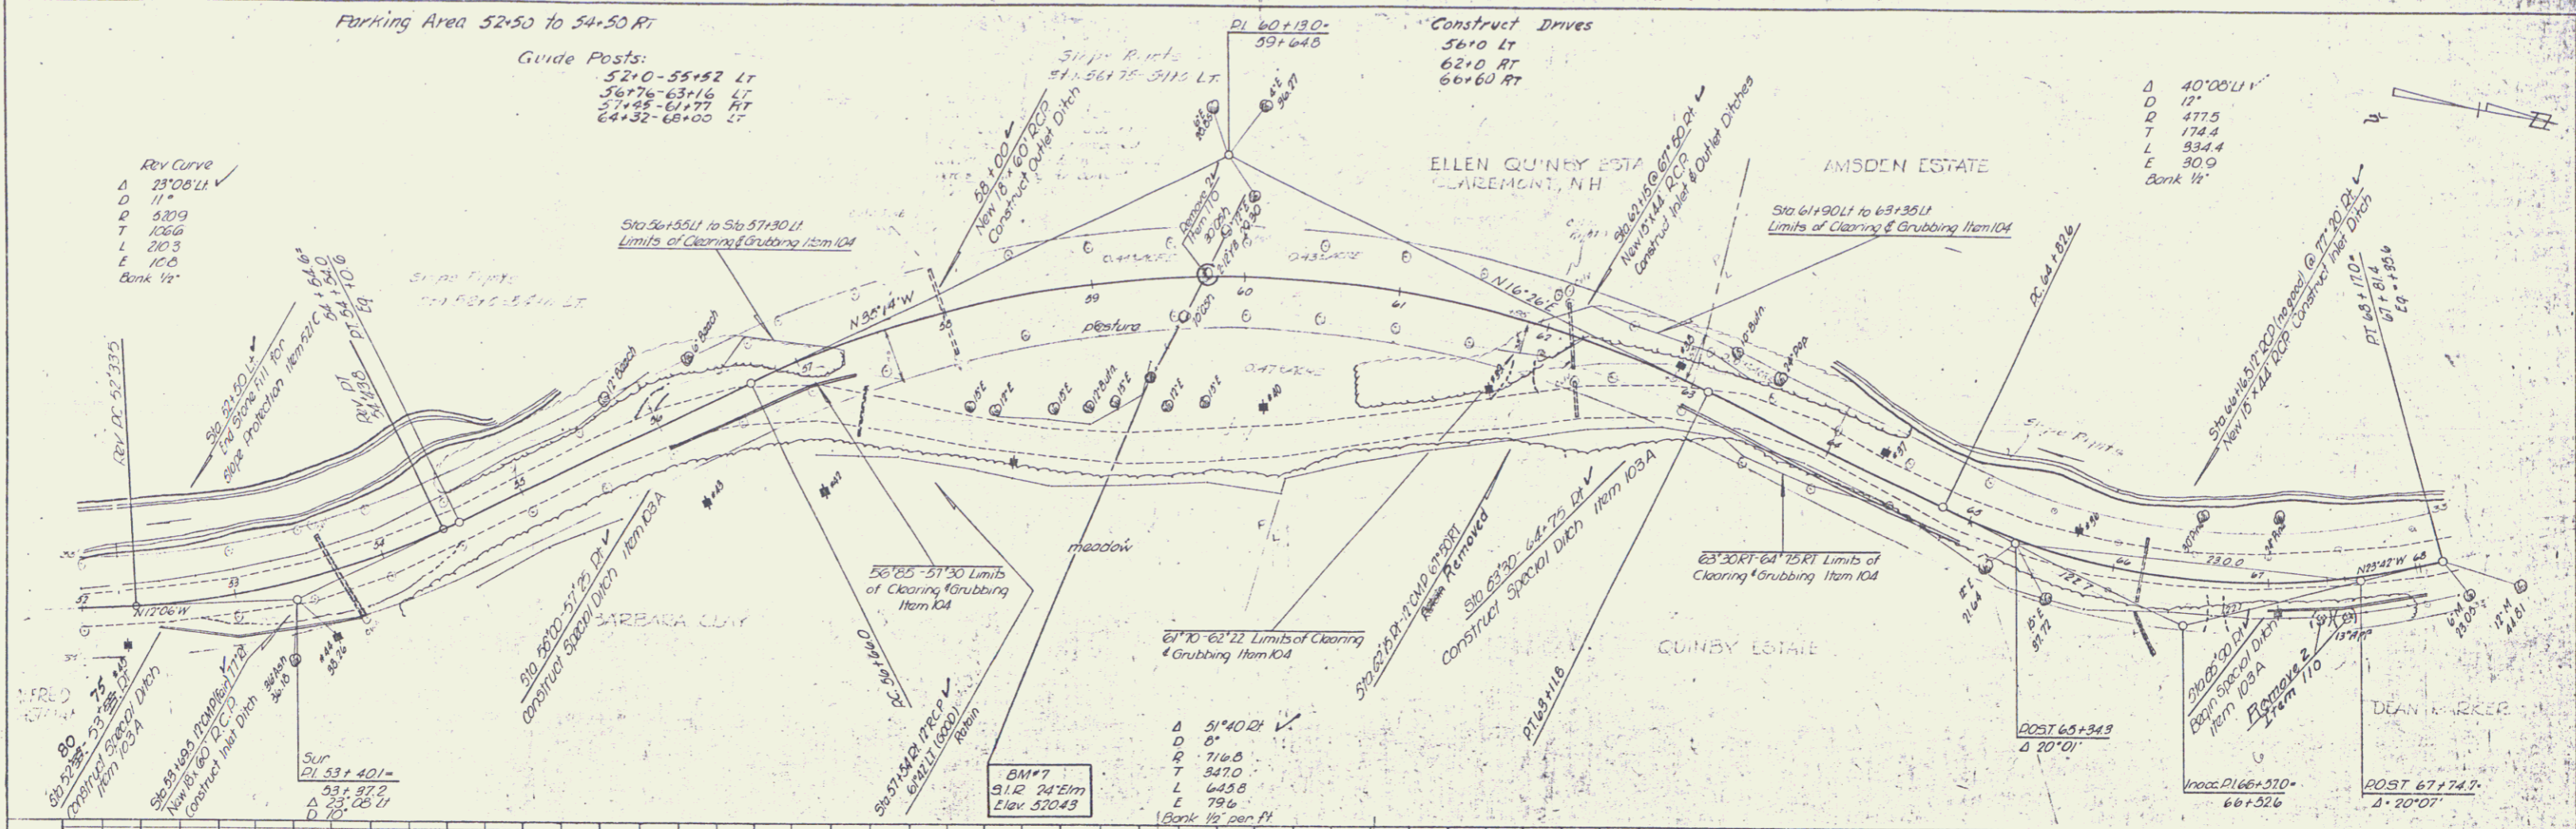


PLATE 1 - PLAN - PROFILE & P&E STANDARD
 HULL & BULL CO. NEW YORK
 P. E. & C. INC. BOSTON
 1973

WEST WINDSOR
 Project 5 NG 200721
 Sheet 9 of 25