


GRANITE CURB	
Lt.	Rt.
4+29-5+47	4+25-4+73
5+61-6+00	4+96-6+00
LT.	RT.
4+29-5+40	4+25-4+78
5+59-6+30	4+04-6+03

ONE COURSE 5" CEMENT CONCRETE
SIDEWALK (5'-0")
LT. 4+29-6+00
RT.

CONSTRUCT DRIVE
LT. 4+28-5+50
RT. 4+05-2+90


CONSTRUCT APPROACH
LT. 4+00

PAVED SHOULDERS
LT. 3+00-6+00
RT. 3+76-6+00

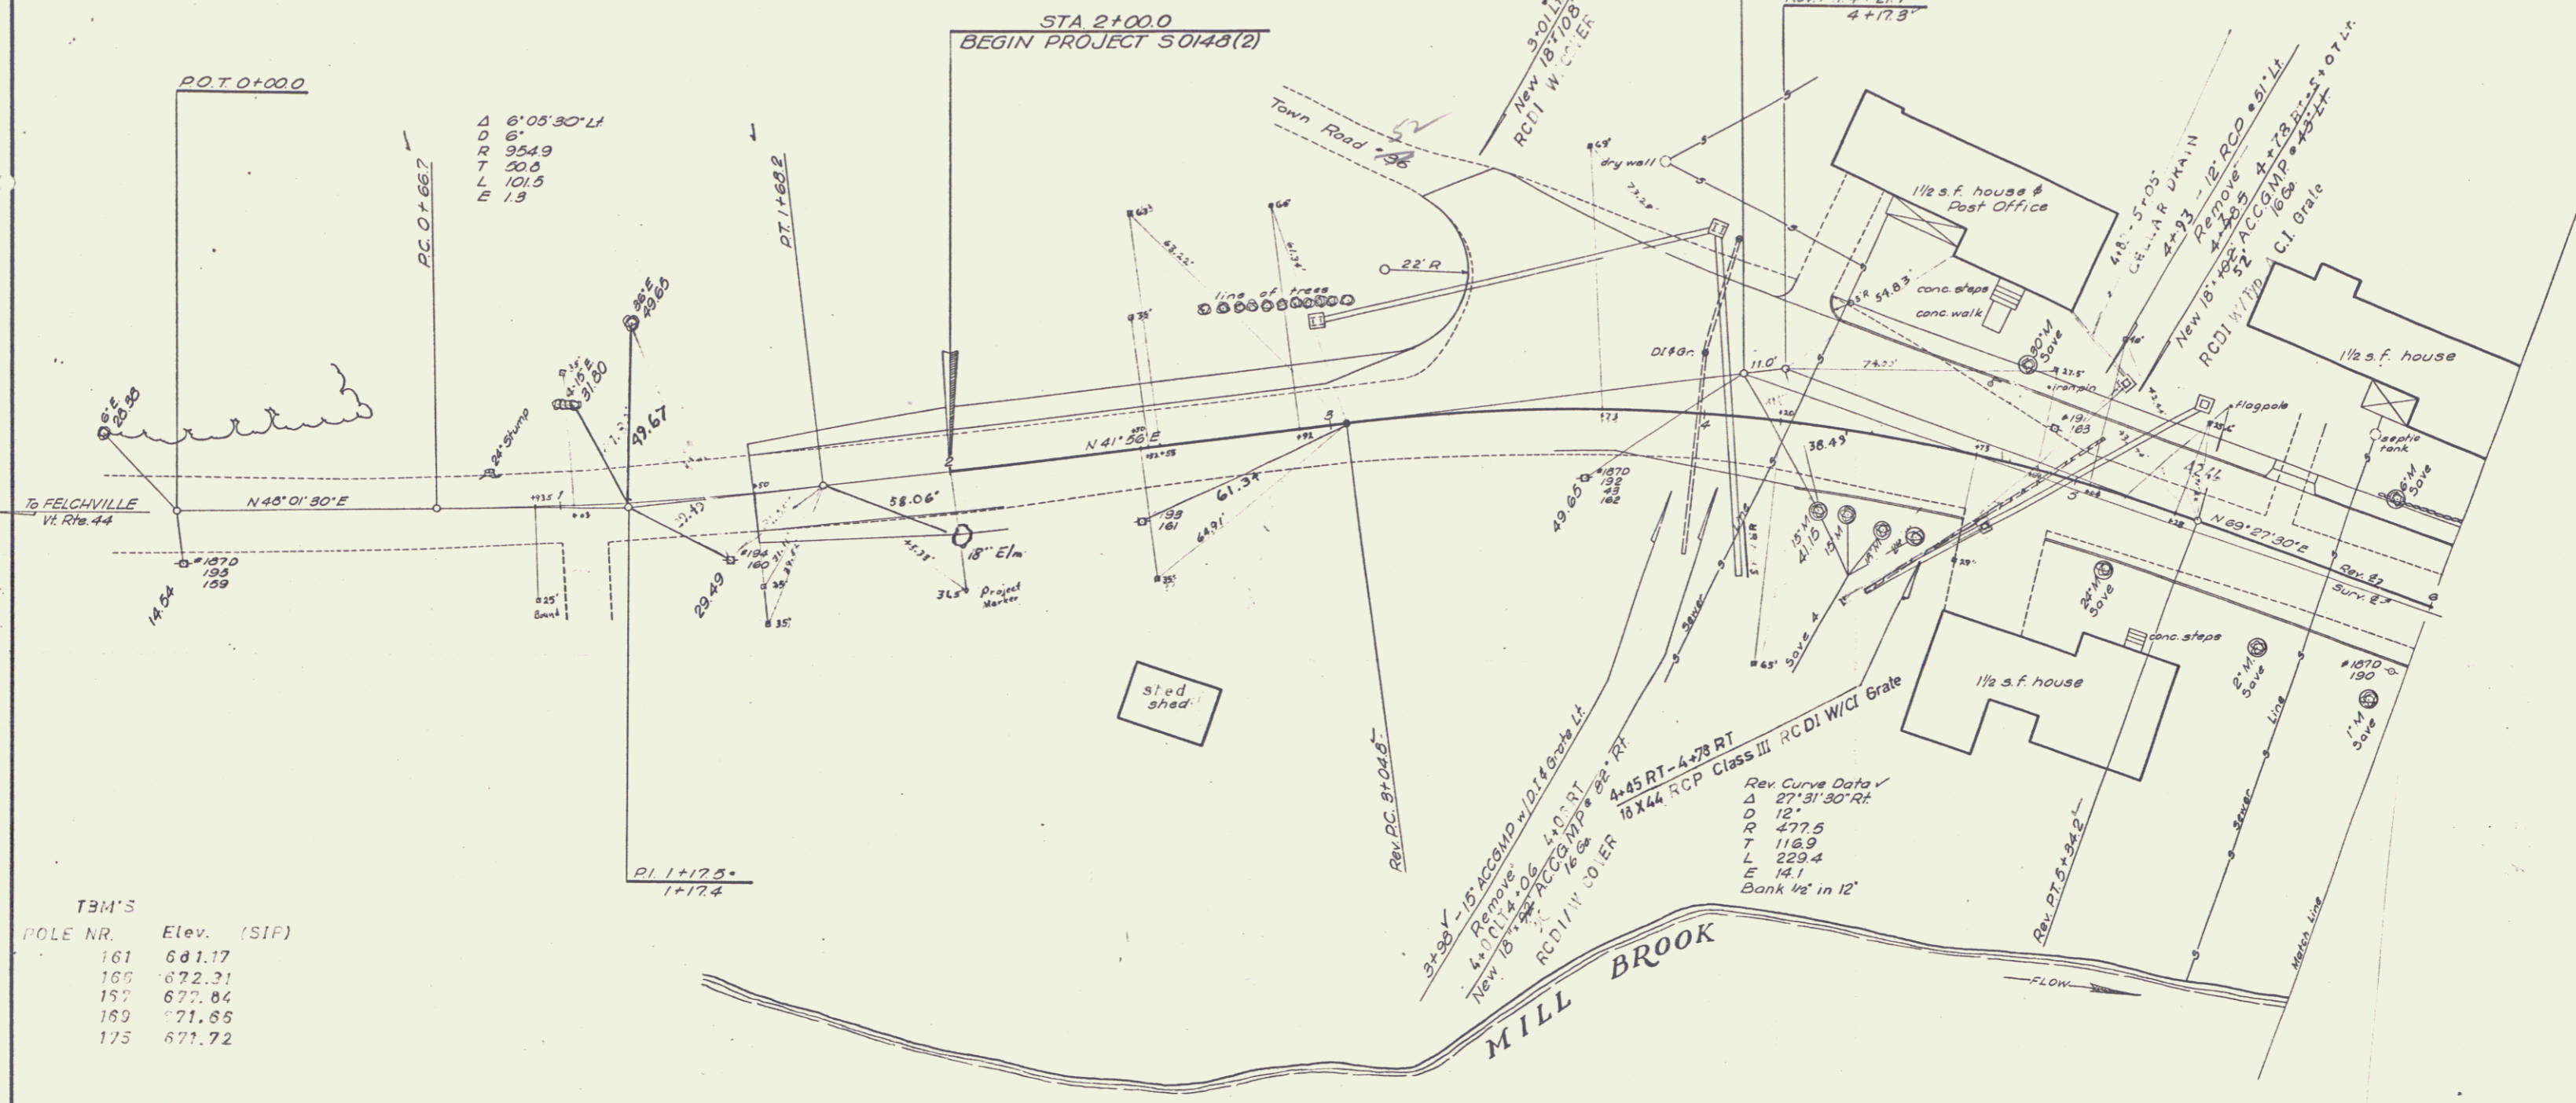

TBM'S

POLE NR.	Elev. (SIP)
161	681.17
166	672.31
157	672.84
169	671.65
173	671.72

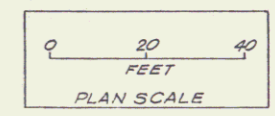

SURVEYED BY Martin DATE 8/82
 DRAWN BY B.R.S. DATE 1/84
 TRACED BY C.E.H. DATE 1/84
 WEST WINDSOR
 PROJ. 3 NO. 0145(2)
 SHEET 2/A OF 47