

ONE COURSE 5" CEMENT CONCRETE
SIDEWALK (5'-0")
LT Rt
6:00-8:63
8:23-9:23 App 1100L
App 100 Rt 10:03-11:26
11:516-12:00

ONE COURSE 8" CEMENT CONCRETE
SIDEWALK (5'-0")
LT Rt
8:63-9:28

GRANITE CURB
LT Rt
6:00-6:29 6:00-6:13
6:29-8:23 6:33-6:32
8:23-8:67 6:76-8:06
8:31-9:23 App 1100L
App 100 Rt 10:03-11:26
11:516-12:00

PAVED SHOULDER
LT Rt
8:00-11:26
11:516-12:00


TWO CABLE GUARD RAIL
LT Rt
11:026-11:26
11:516-11:26

REMOVAL AND DISPOSAL OF
PRESENT GUARD RAIL
11:12-11:20

DEMOLITION AND REMOVAL
OF BUILDING
LT Rt
9:00 (1)

CONSTRUCT DRIVE
LT Rt
6:00 6:17
8:35 6:38
9:75 6:11

CONSTRUCT APPROACH
LT Rt
6:27

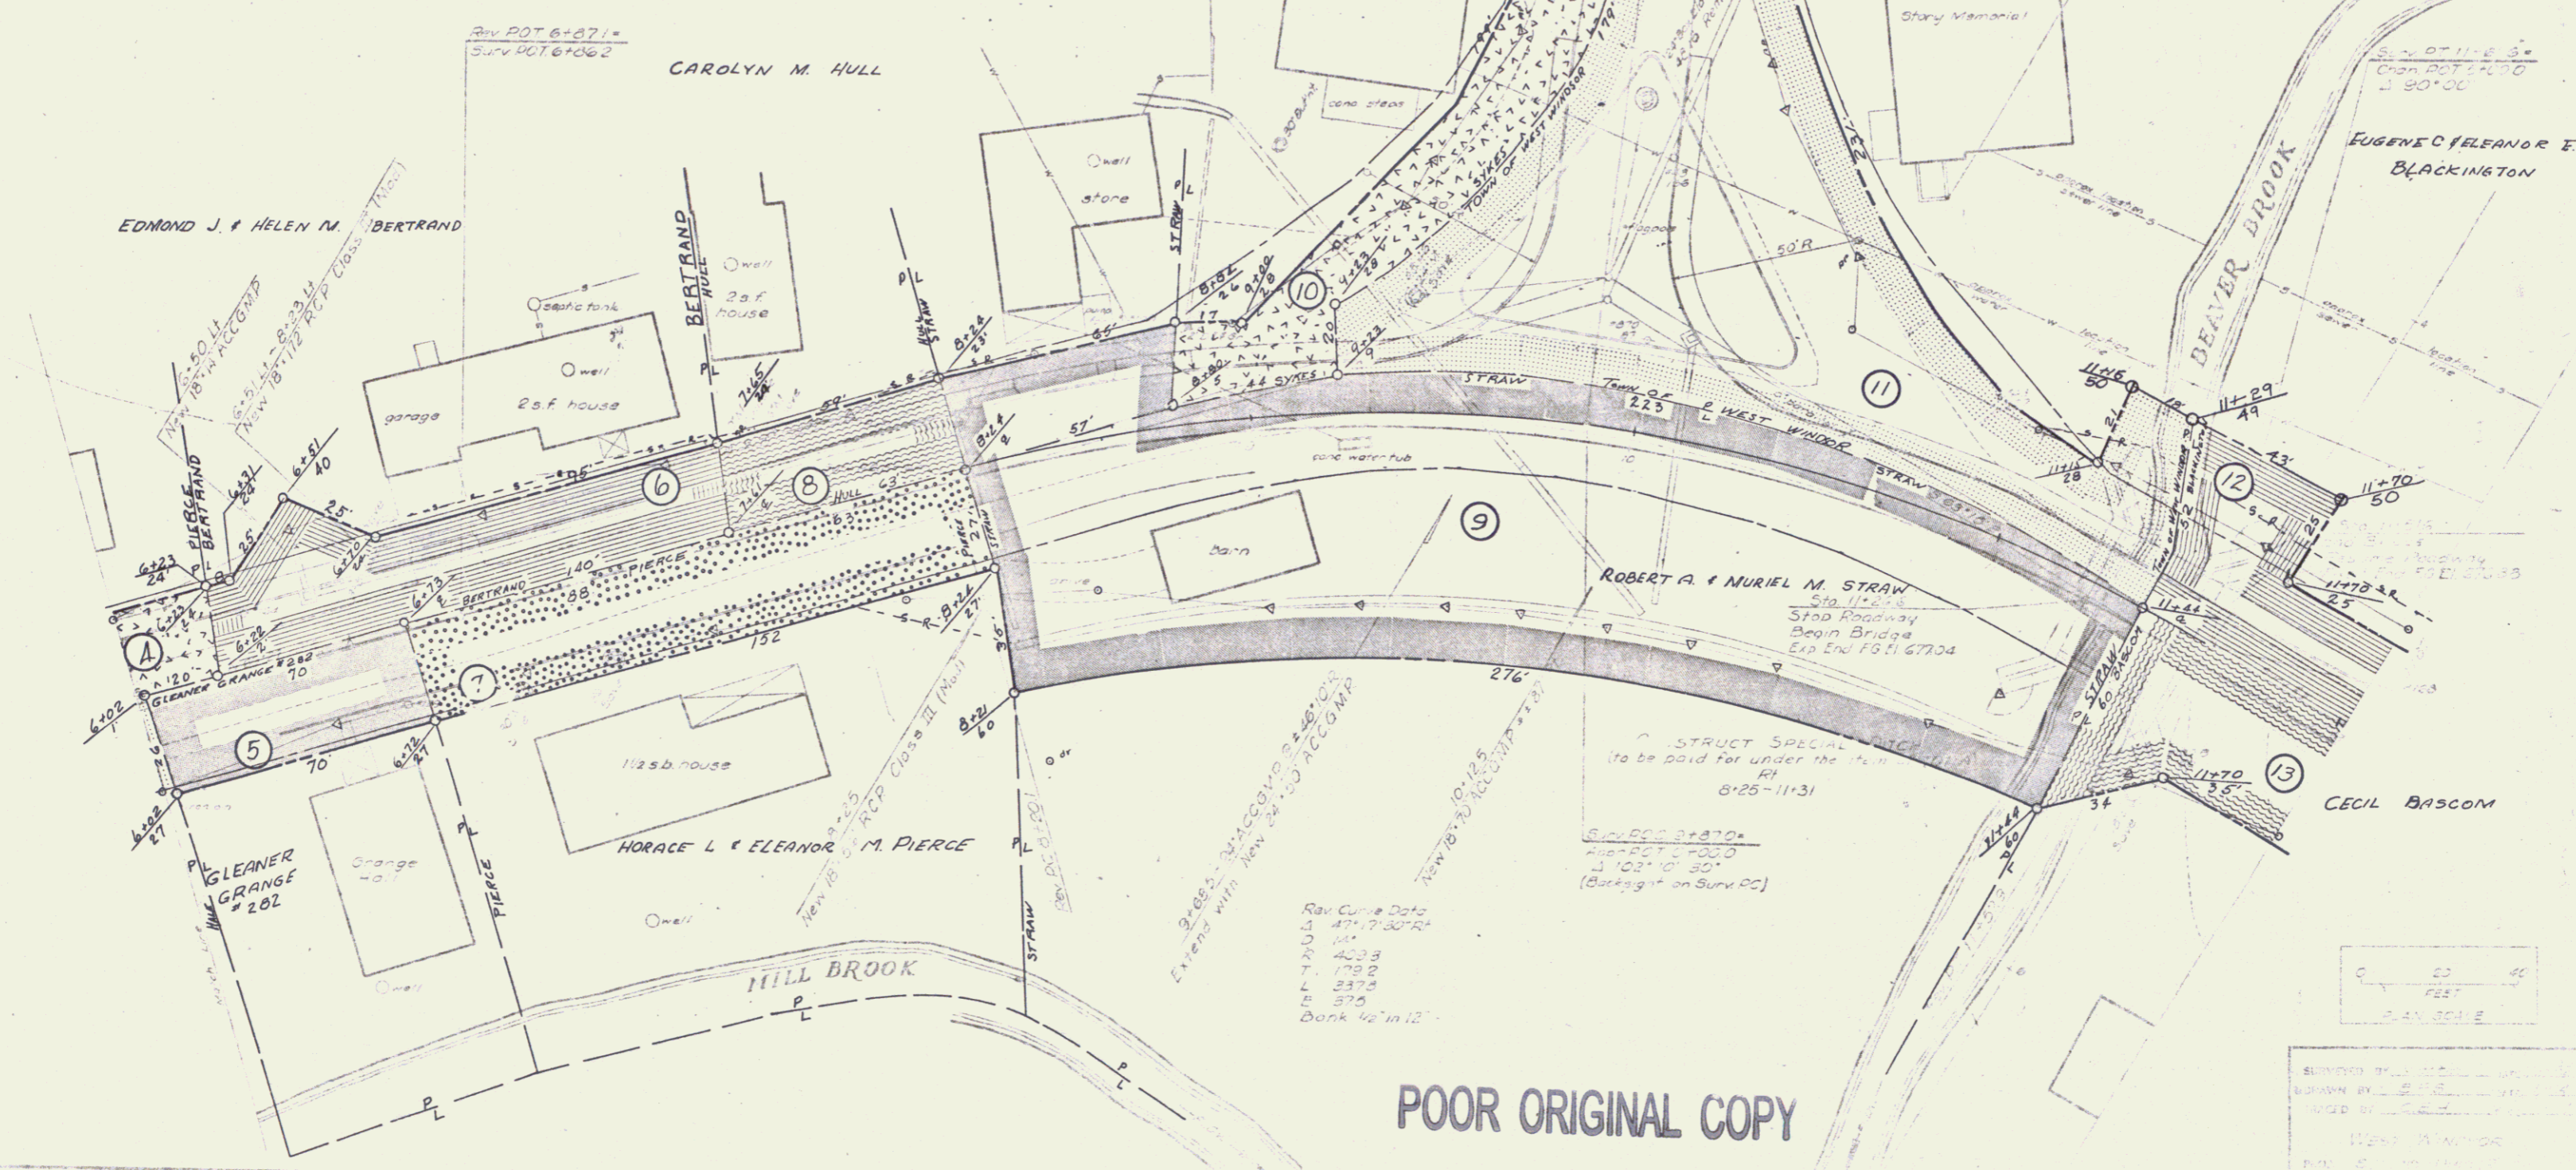

POOR ORIGINAL COPY

Scale: 1" = 40' FEET
SHEET 20-C
WEST WINDSOR
4