

ONE COURSE 5" CEMENT CONCRETE
SIDEWALK (5'-0")
LT RT
6'-00" - 6'-43" 6'-00" - 6'-43"
6'-43" - 7'-13" 6'-43" - 7'-13"
7'-13" - 10'-03" 7'-13" - 10'-03"
10'-03" - 11'-56" 10'-03" - 11'-56"
11'-56" - 12'-00" 11'-56" - 12'-00"

ONE COURSE 8" CEMENT CONCRETE
SIDEWALK (5'-0")
LT RT
8'-43" - 9'-88"

GRANITE CURB
LT RT
6'-00" - 6'-79" 6'-00" - 6'-79"
6'-79" - 8'-23" 6'-79" - 8'-23"
8'-23" - 8'-67" 8'-23" - 8'-67"
8'-67" - 9'-73" 8'-67" - 9'-73"
9'-73" - 11'-25" 9'-73" - 11'-25"
11'-25" - 12'-00" 11'-25" - 12'-00"

PAVED SHOULDER
LT RT
8'-00" - 11'-56" 8'-00" - 11'-56"
11'-56" - 12'-00" 11'-56" - 12'-00"


TWO CABLE GUARD RAIL
LT RT
11'-026" - 11'-266" 11'-026" - 11'-266"
11'-516" - 11'-756" 11'-516" - 11'-756"

REMOVAL AND DISPOSAL OF
PRESENT GUARD RAIL
RT
11'-12" - 11'-20"


DEMOLITION AND REMOVAL
OF BUILDING
RT
9'-00" (1)

CONSTRUCT DRIVE
LT RT
6'-00" 6'-17"
8'-35" 8'-58"
9'-75" 8'-11"

CONSTRUCT APPROACH
RT
4'-00"

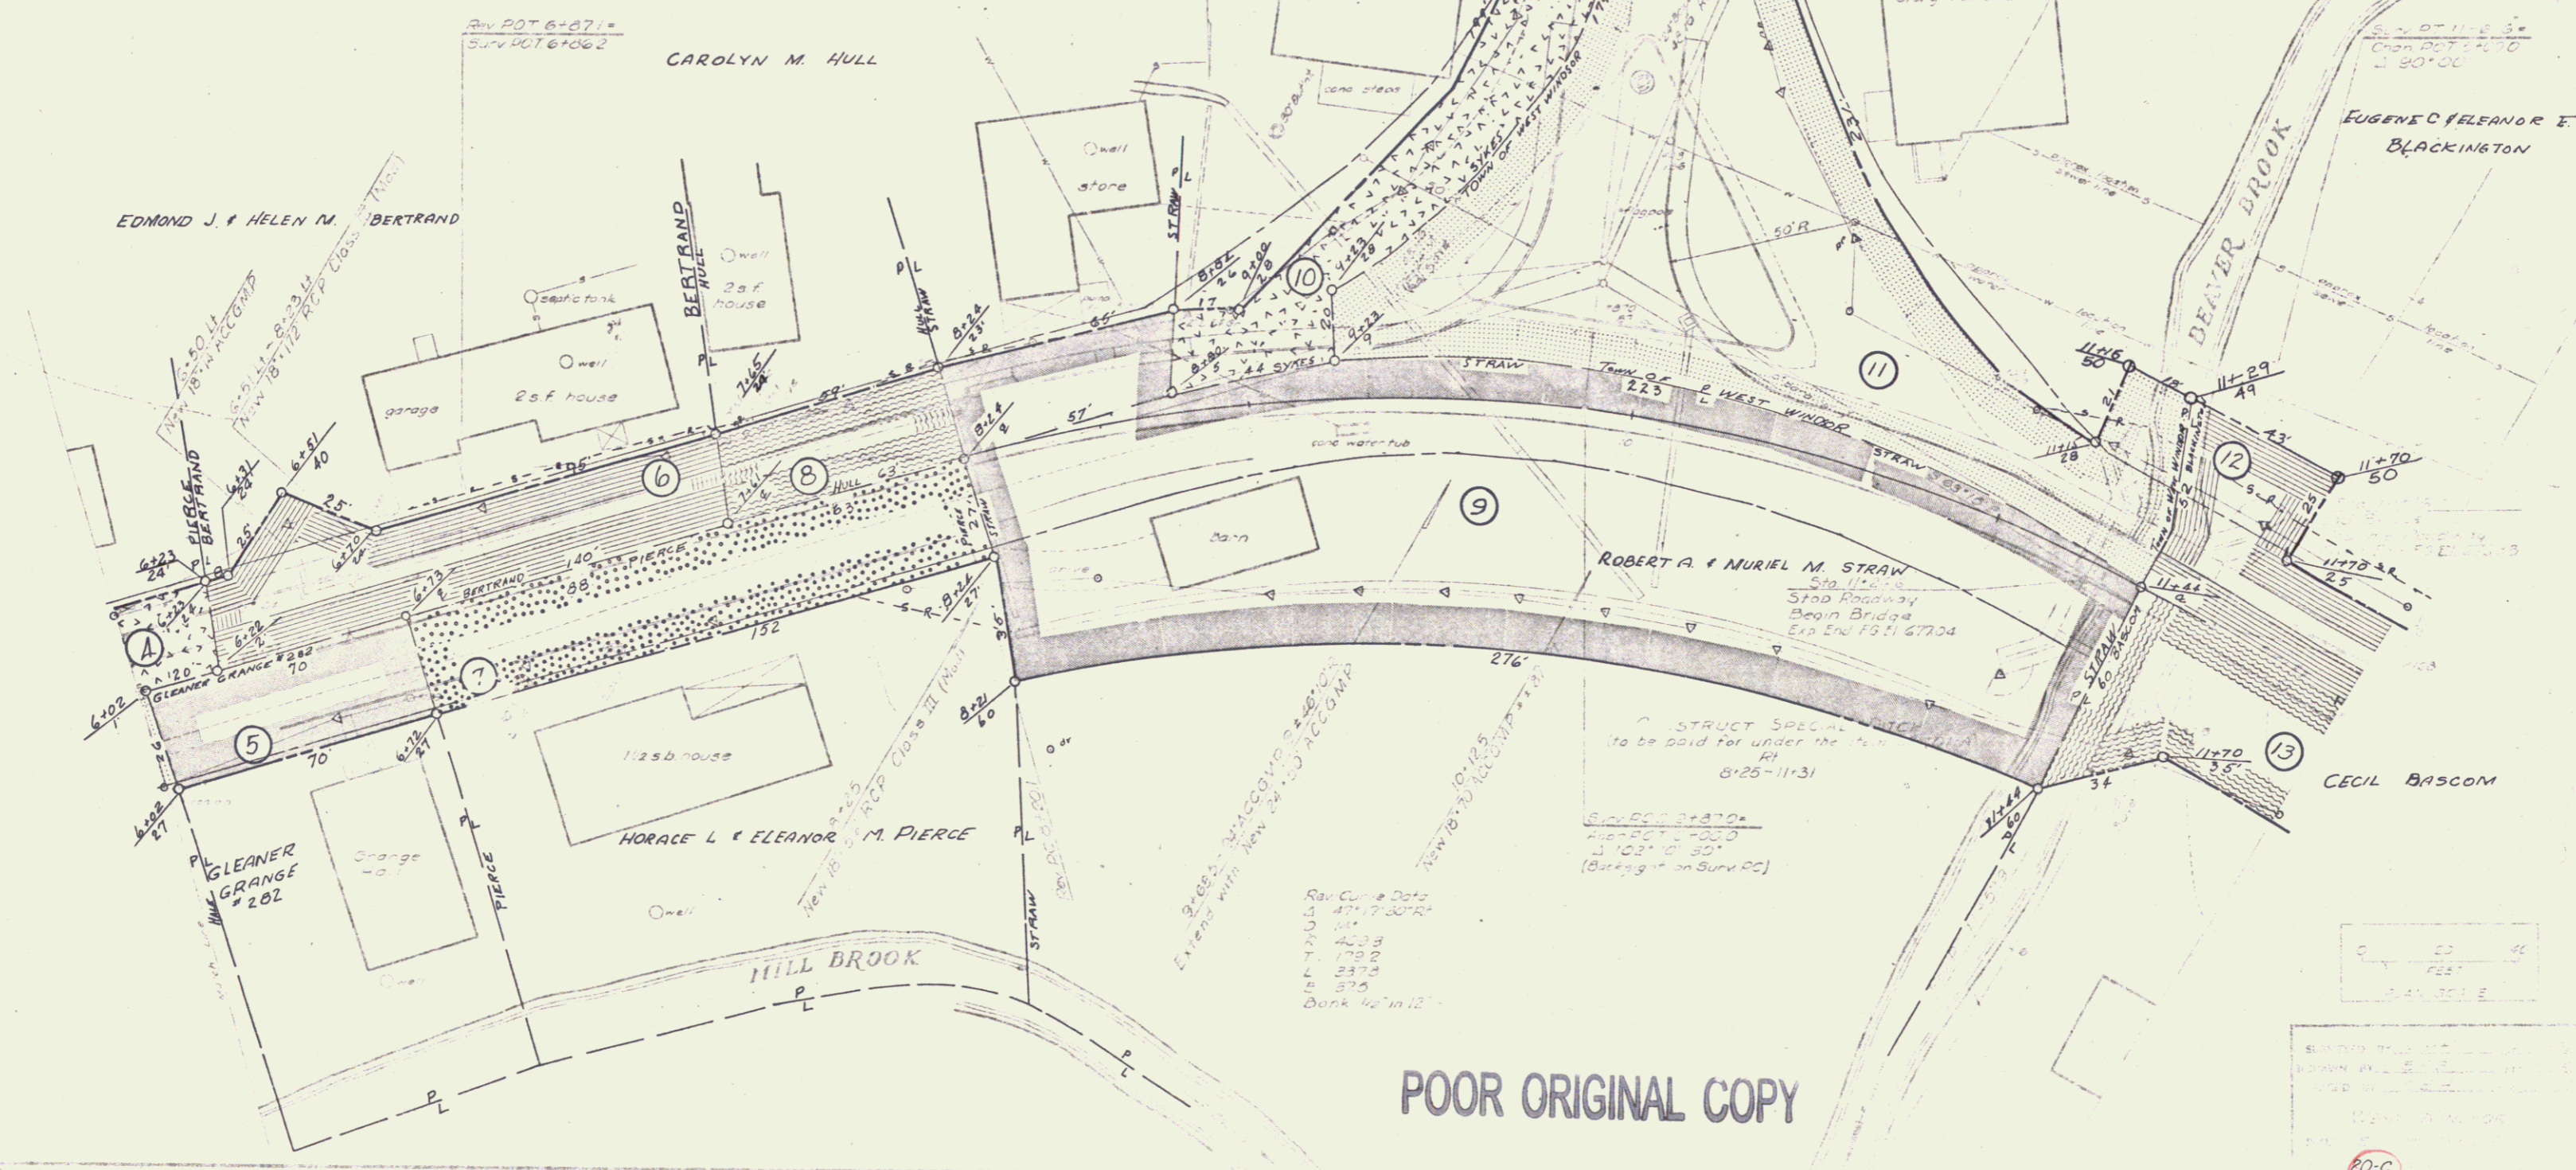

POOR ORIGINAL COPY

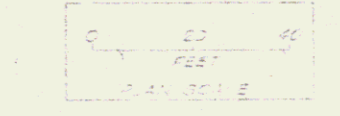

20-C