

ONE COURSE 5" CEMENT CONCRETE SIDEWALK (5'-0")
LT 18-00-18-84
RT 19-14-21-66

CONSTRUCT DRIVE
LT 18-00-19-00
RT 20-11-21-00

CONSTRUCT APPROACH
LT 21-90
RT


CONSTRUCT GRANITE CURB
LT 18-00-21-53
RT 19-10-20-31
20-25-20-28
21-16-21-66

PAVED SHOULDERS
LT 18-00-21-62
RT

CONSTRUCT SPECIAL DITCH TO DRAIN WATER PUMP AT STA 23+00.5 LT (To be paid for under the item of 10-A)
LT 23-50-24-00
RT


ONE COURSE 5" CEMENT CONCRETE SIDEWALK (5'-0")
LT 18-84-19-14
RT

CONSTRUCT PAVED GUTTER
LT 18-00-18-50
RT

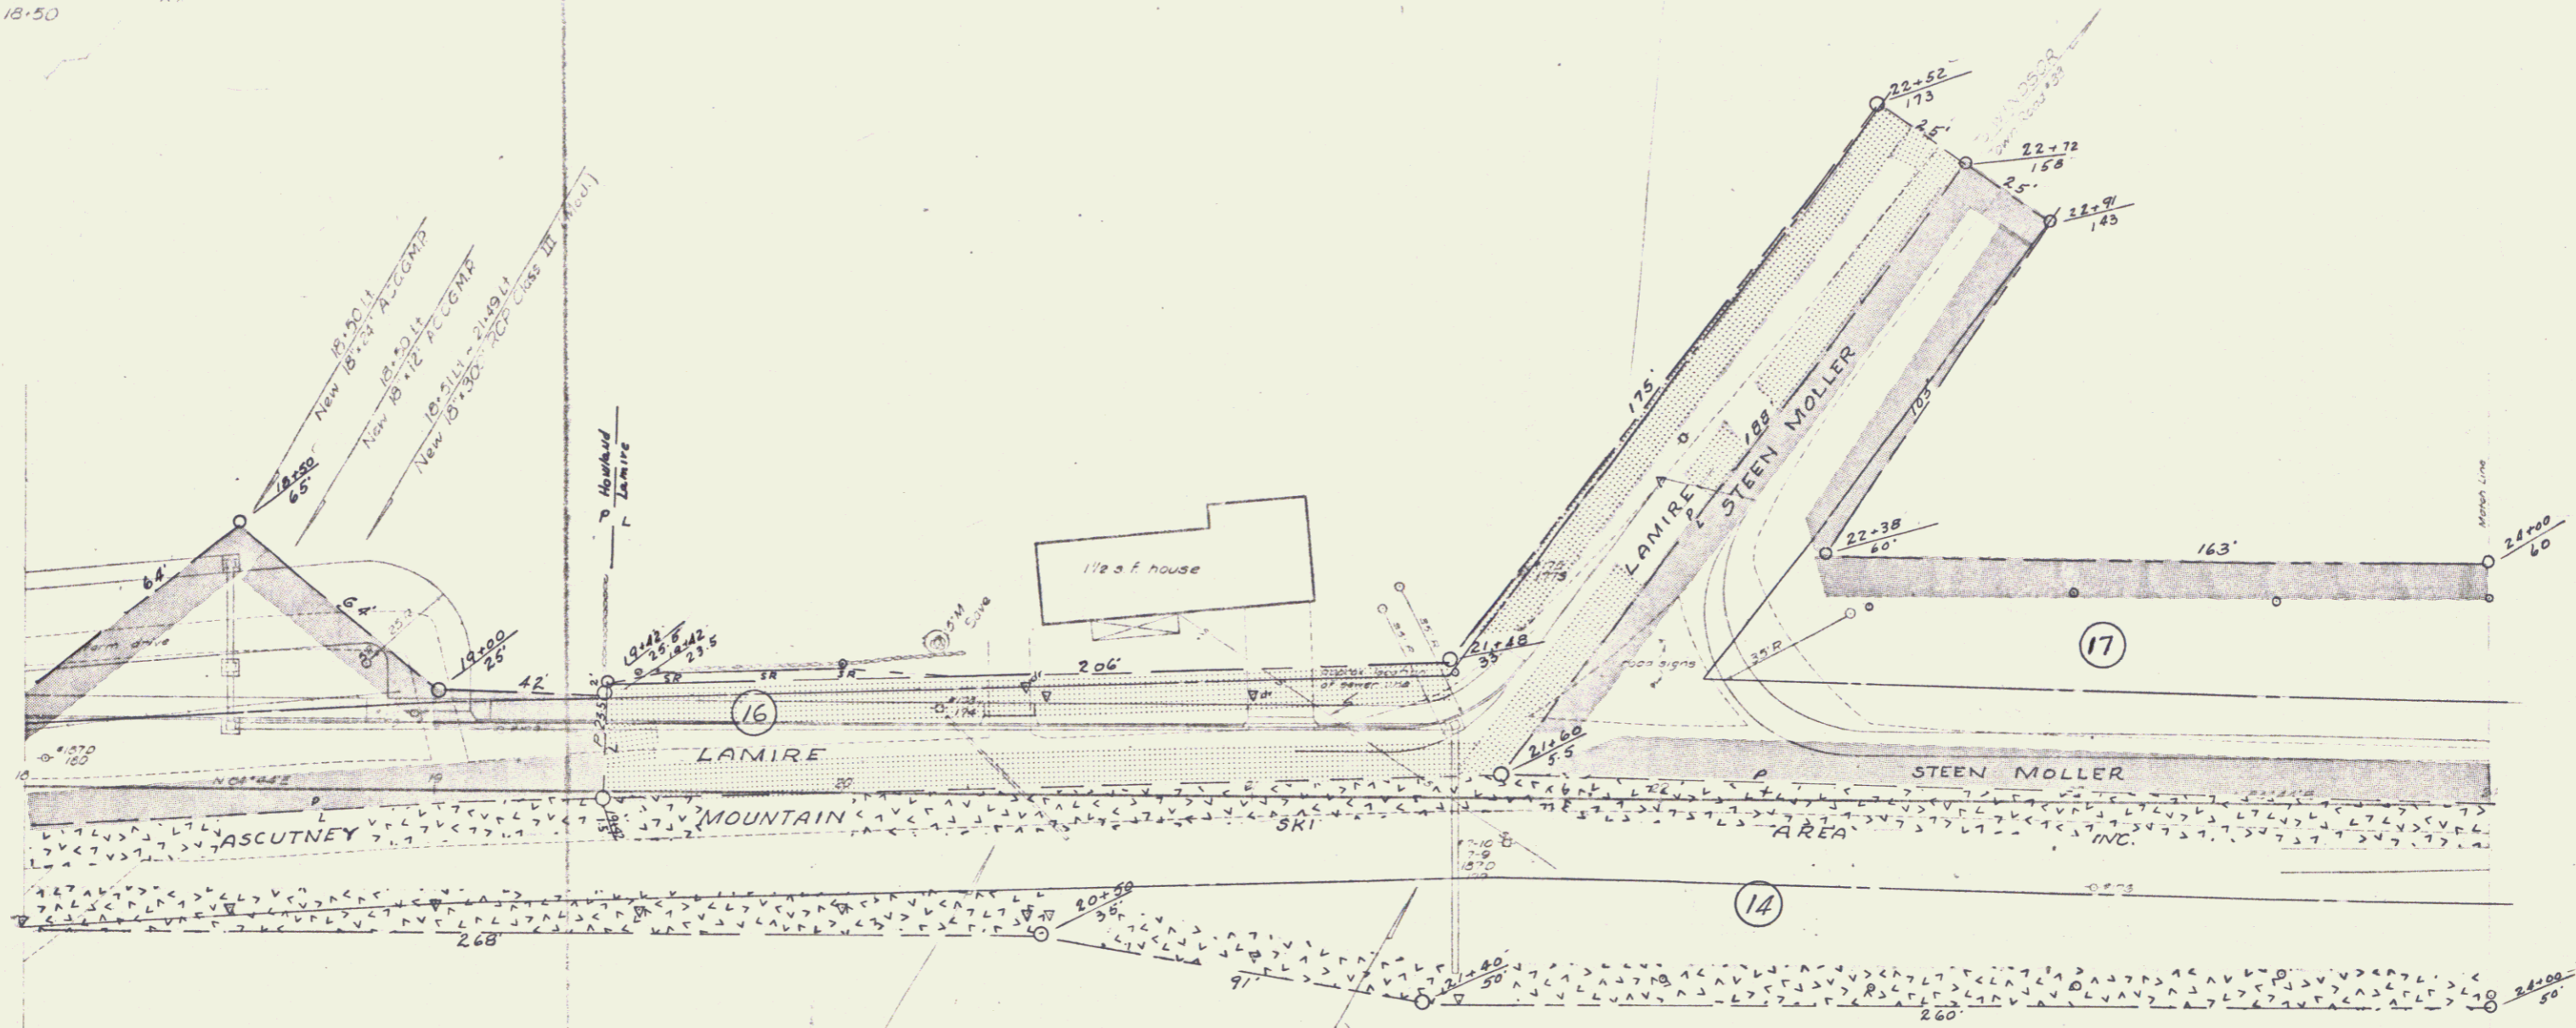

2044-12 C.M.D. 5-12-12 RT
Remove

21-90
New 18' RCP Class II (Road)

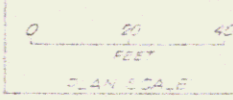

SURVEYED BY: [Signature]
DRAWN BY: [Signature]
CHECKED BY: [Signature]
DATE: [Date]
NO. 80-E