

CONSTRUCT DRIVES
 LT 18+36
 RT 19+70
 19+70 25+44

Δ 18'50' LT
 D 0'30'
 R 11459.2
 T 1833.5
 L 366.7
 E 1.5
 DO NOT BANK

Δ 3'28' RT
 D 1'
 R 5729.6
 T 173.4
 L 346.7
 E 2.6
 DO NOT BANK

NOTE: 21+50 TO 24+00±
 PAVE SHOULDER & DITCH LT

PLAN
 SHEET NO. 446
 PROJECT: CANAAN FUND
 DATE: 12/15/08

PROFILE
 SHEET NO. 446
 PROJECT: CANAAN FUND
 DATE: 12/15/08

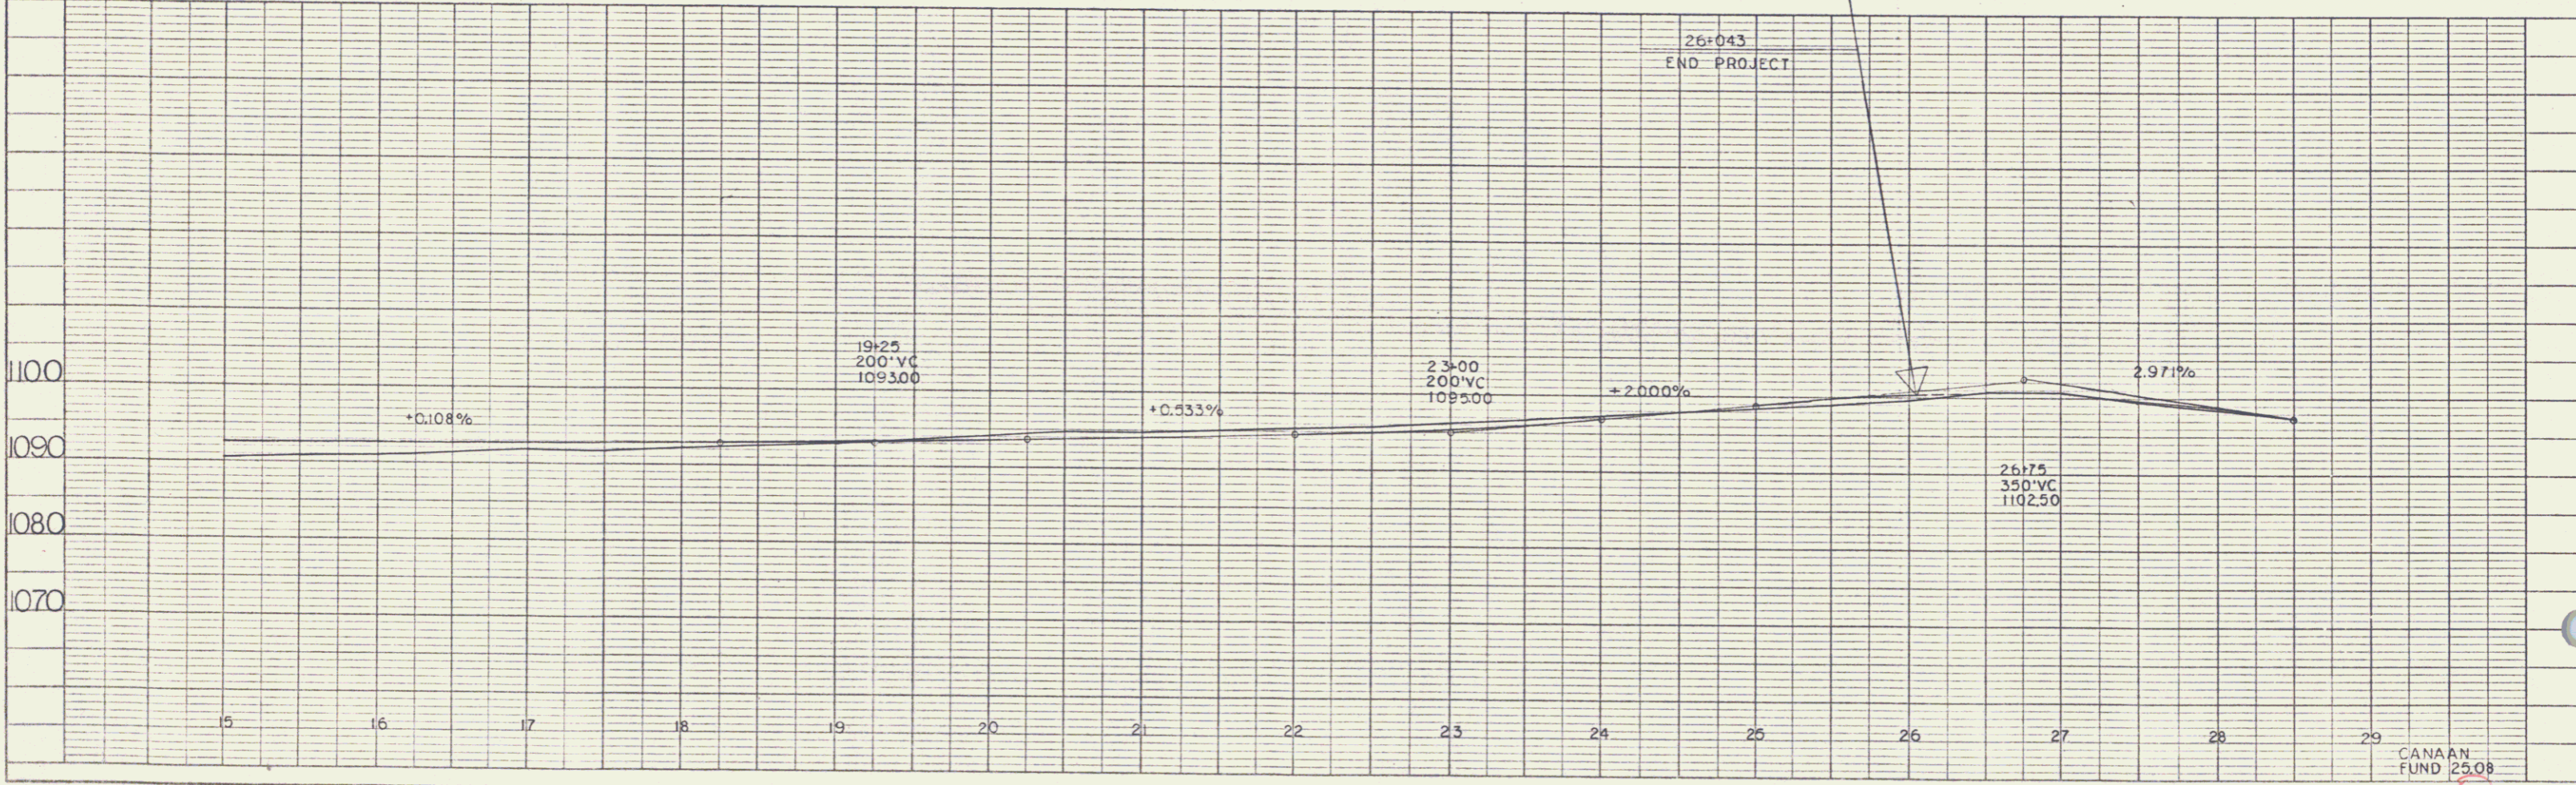


PLATE 1. PLAN, PROFILE, C.P.P. & R.T. STANDARD
 KEUFFEL & ESSER CO., NEW YORK

CANAAN FUND 25.08
 Sheet 3 of 6