

NOTE:

ALL DRIVES WILL HAVE A MINIMUM 12' WIDTH AND A 15' FLARE RADIUS.

CONSTRUCT SPECIAL DITCH - TO BE PAID FOR UNDER THE ITEM 103-A-1
R1
304+89 - 307+40'

CONSTRUCT DRIVES
L1 R1
299+00' 299+15'
300+17' 300+17'
301+07' 301+17'
298+30' 298+30'

PLAN
DESIGNED BY: [illegible]
CHECKED BY: [illegible]
DATE: [illegible]

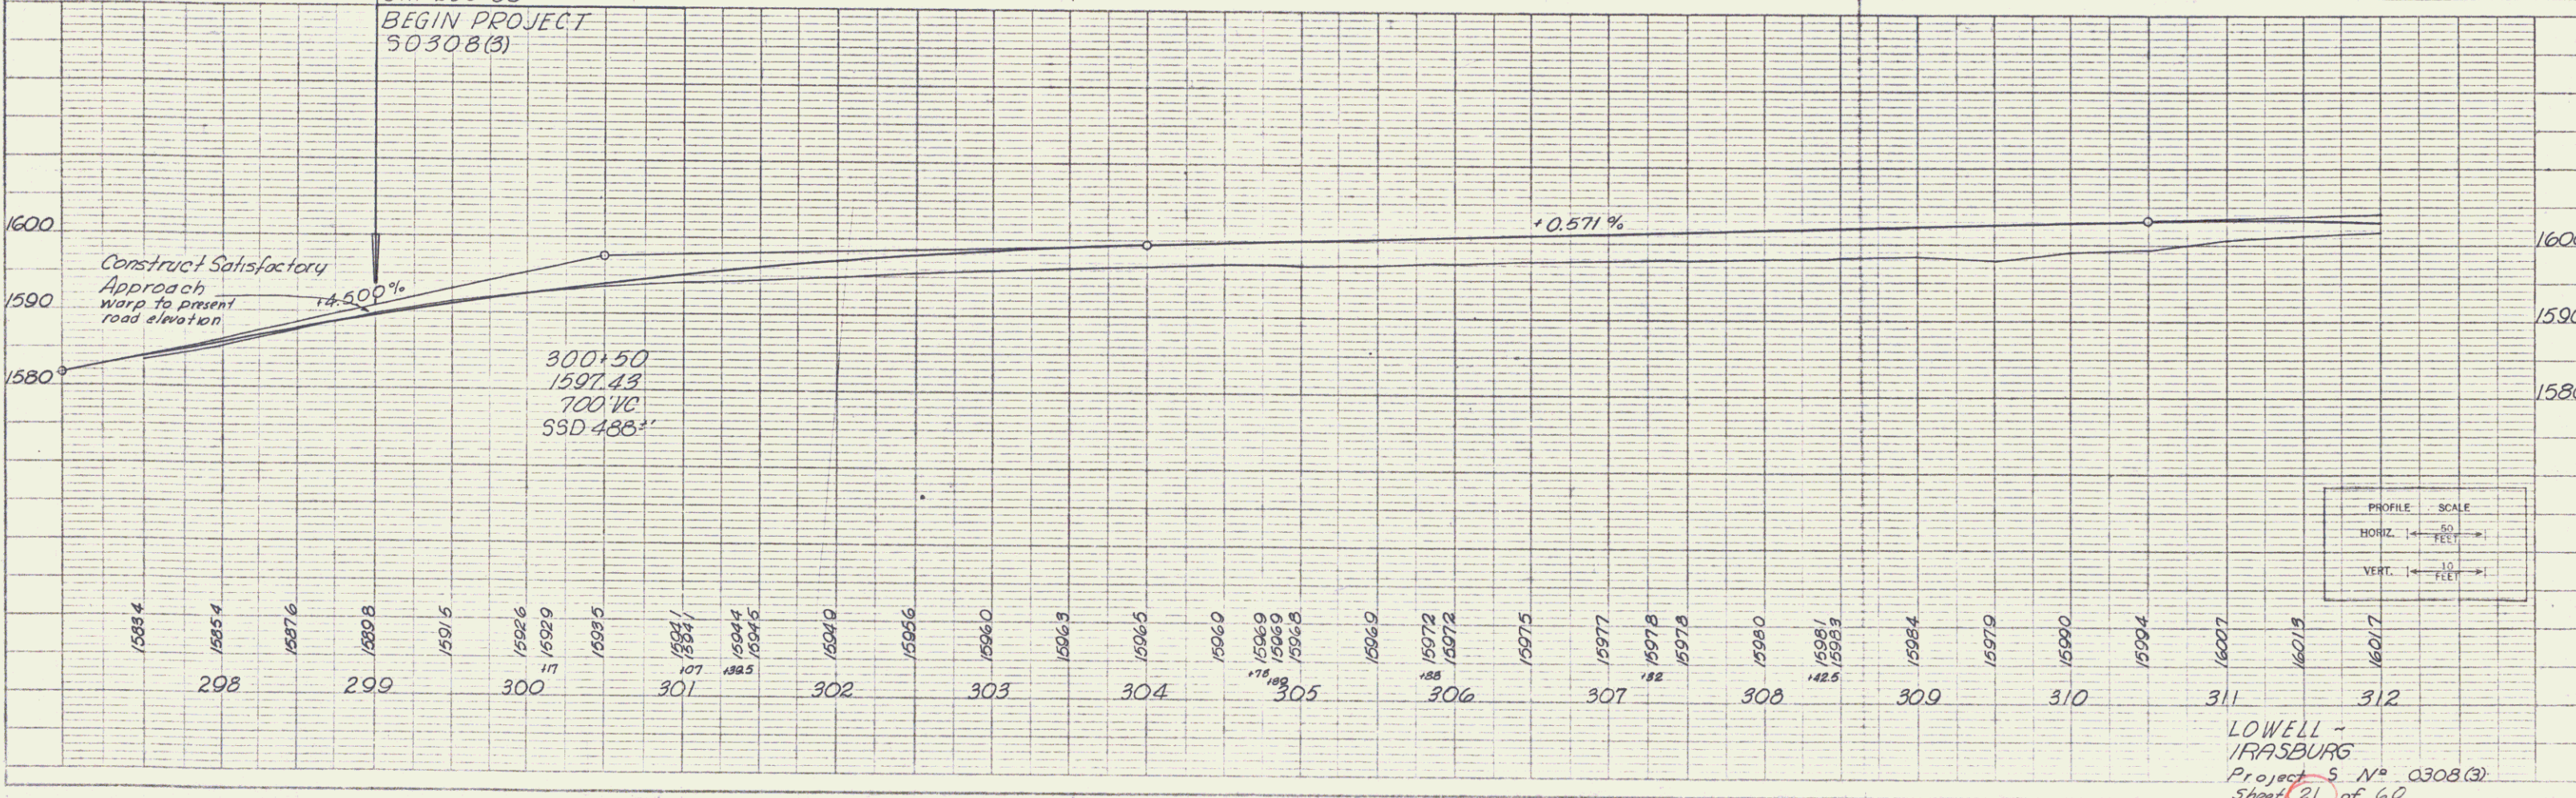
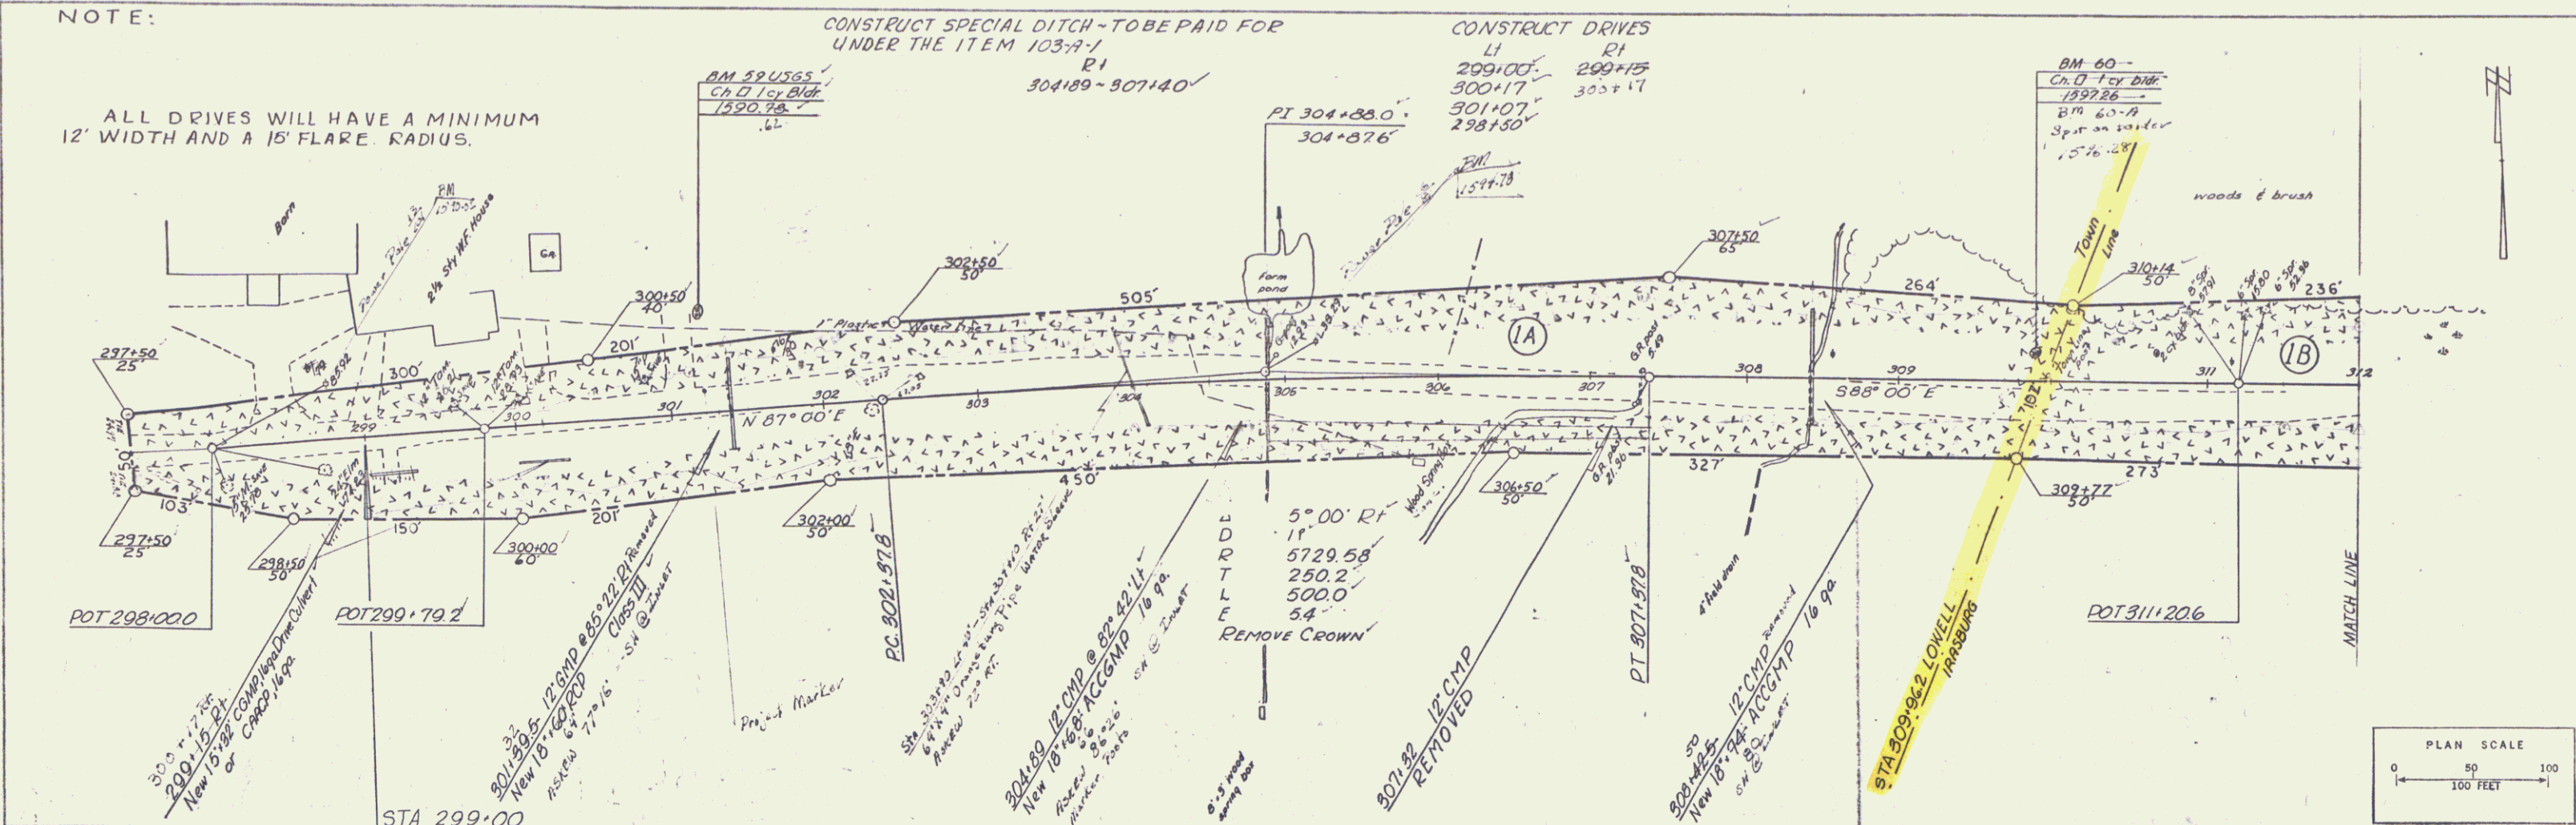


PLATE 1 - PLAN - PROFILE - C.P. & E. STANDARD
SCALE: 1" = 100' HORIZ. 1" = 10' VERT.