


PLAN
 DATE: 10/12/11
 DRAWN BY: J. J. [unclear]
 CHECKED BY: [unclear]
 NO. OF SHEETS: 60
 SHEET NO.: 22

PROFILE
 DATE: 10/12/11
 DRAWN BY: J. J. [unclear]
 CHECKED BY: [unclear]
 NO. OF SHEETS: 60
 SHEET NO.: 22

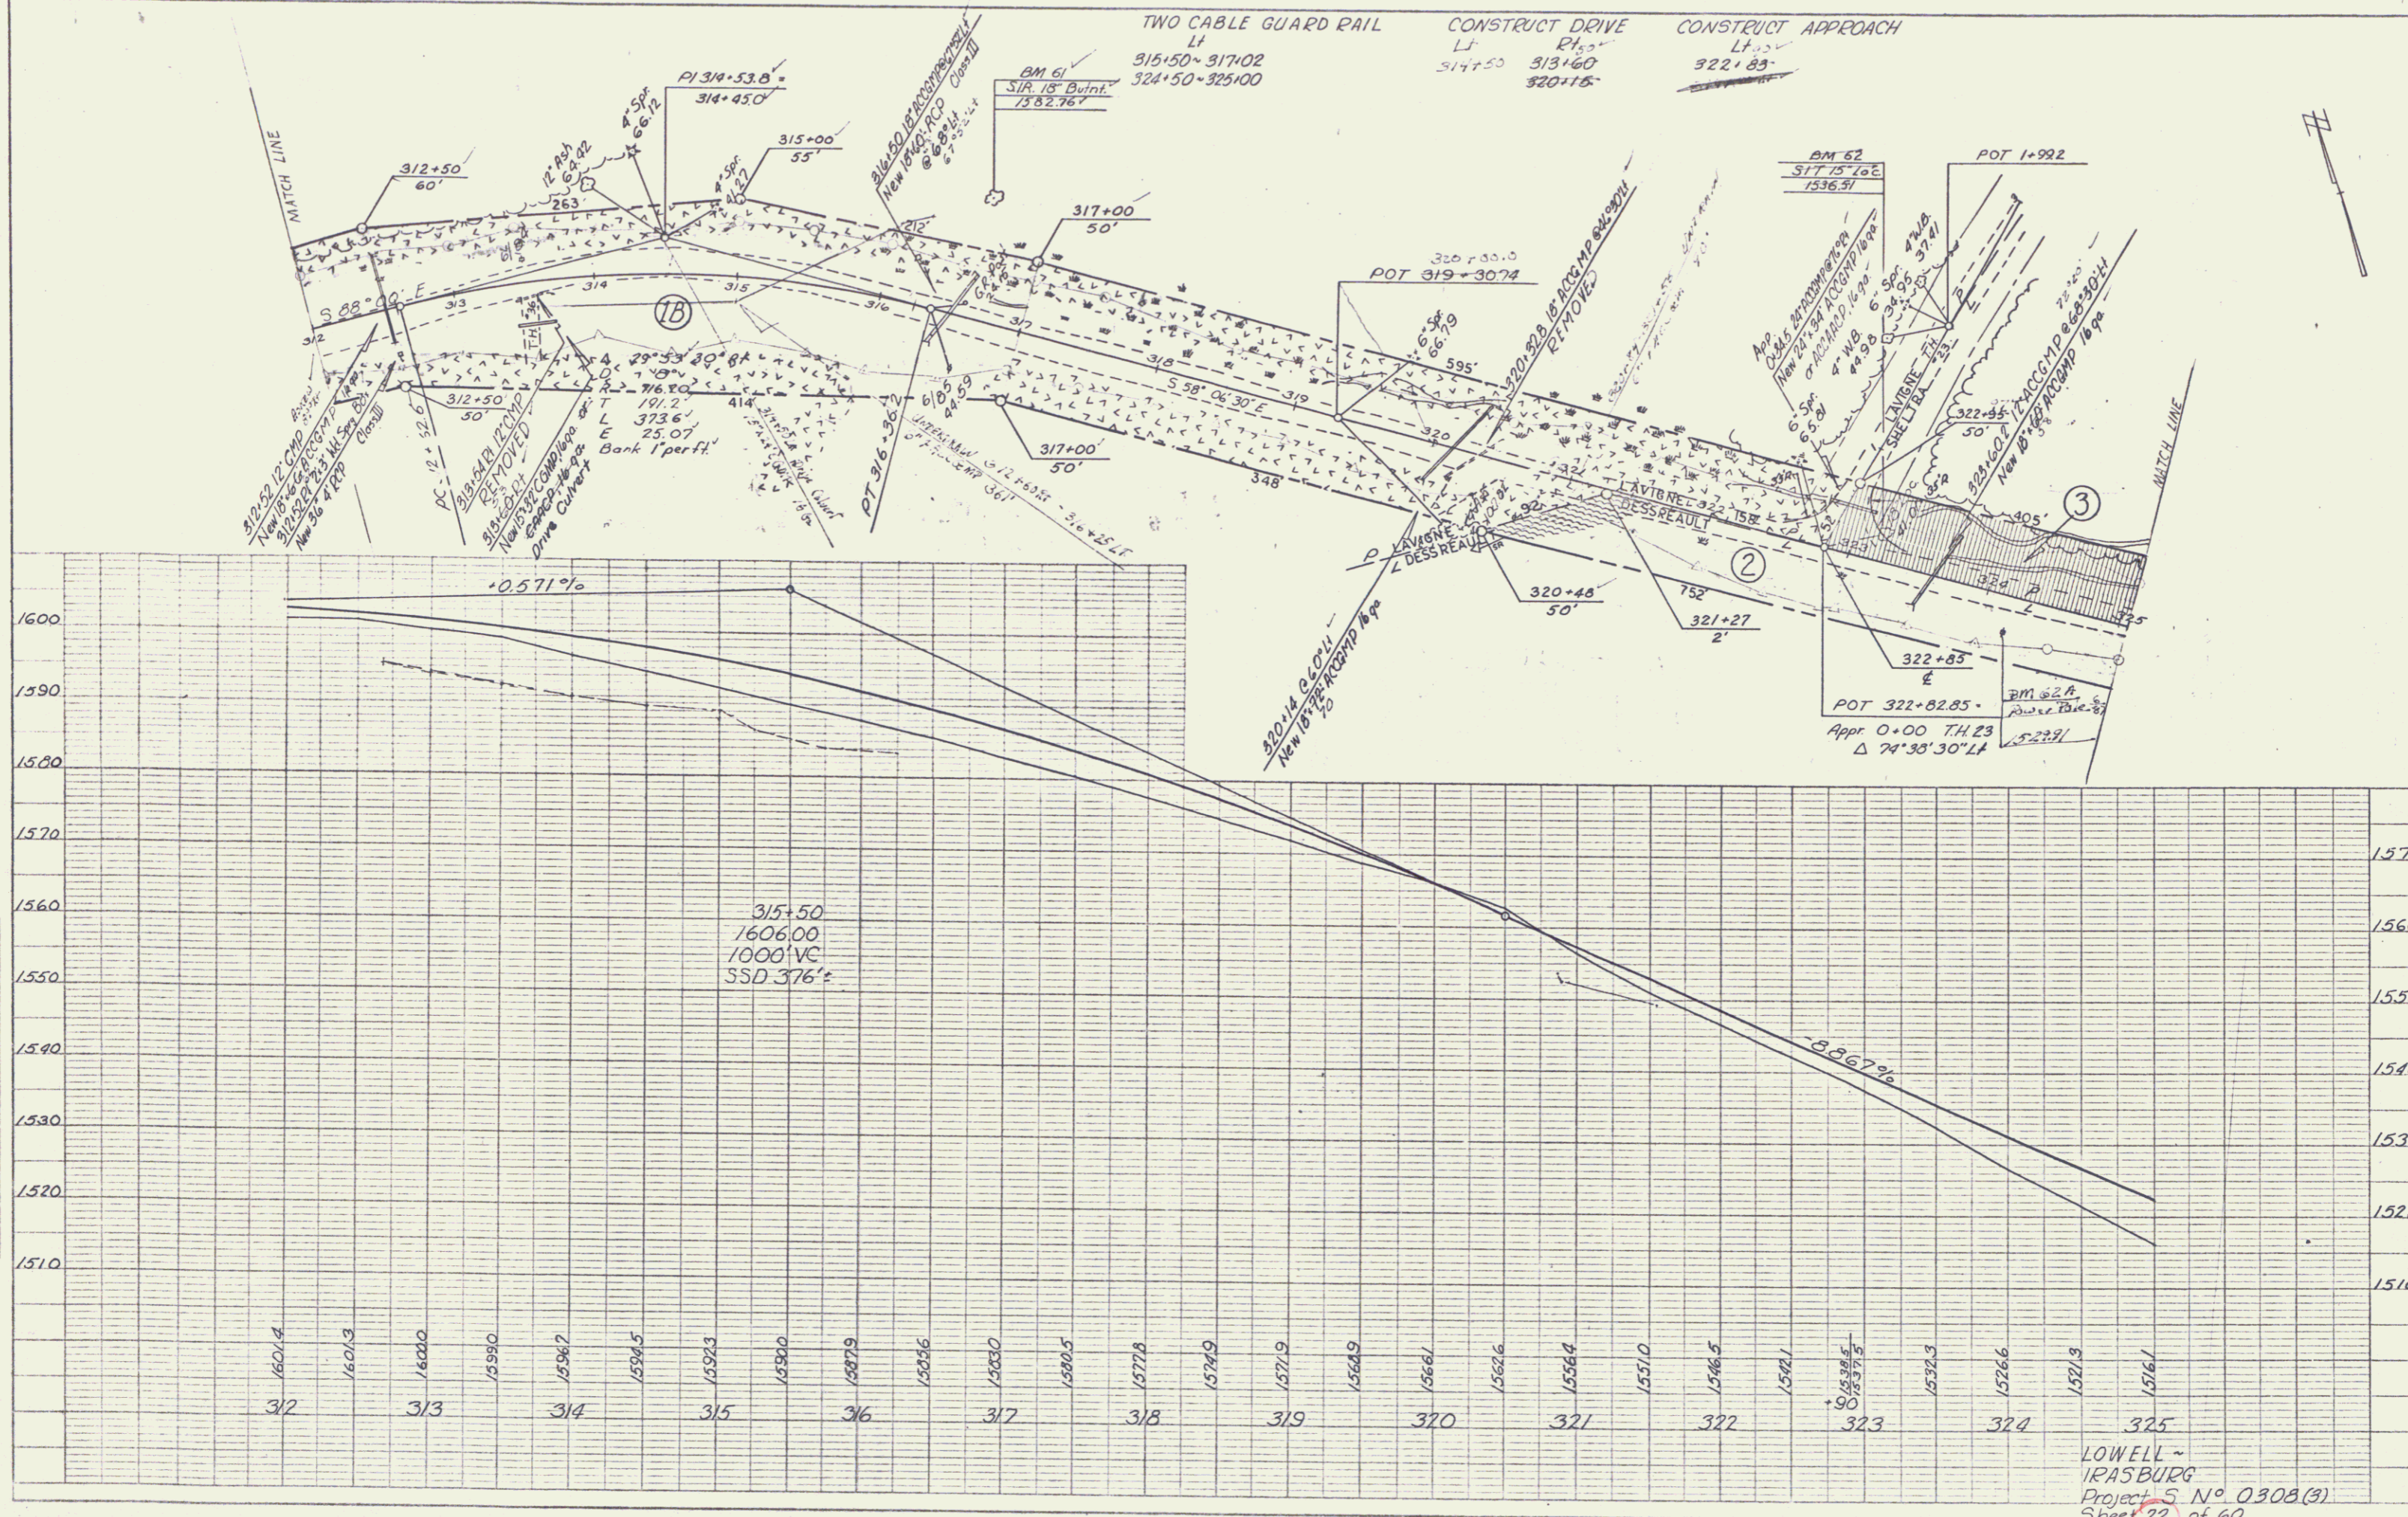

PLANT: PLAN, PROFILE, G.P.A.R.E. STANDARD
 METRIC & IMPERIAL, NEW YORK
 A.E.C. NO. 348-R
 11/11/11

LOWELL -
 IRASBURG
 Project S N° 0308(3)
 Sheet 22 of 60