

PLAN
 DATE MOON
 CHECKED
 NO.

PROFILE
 DATE MOON
 CHECKED
 NO.

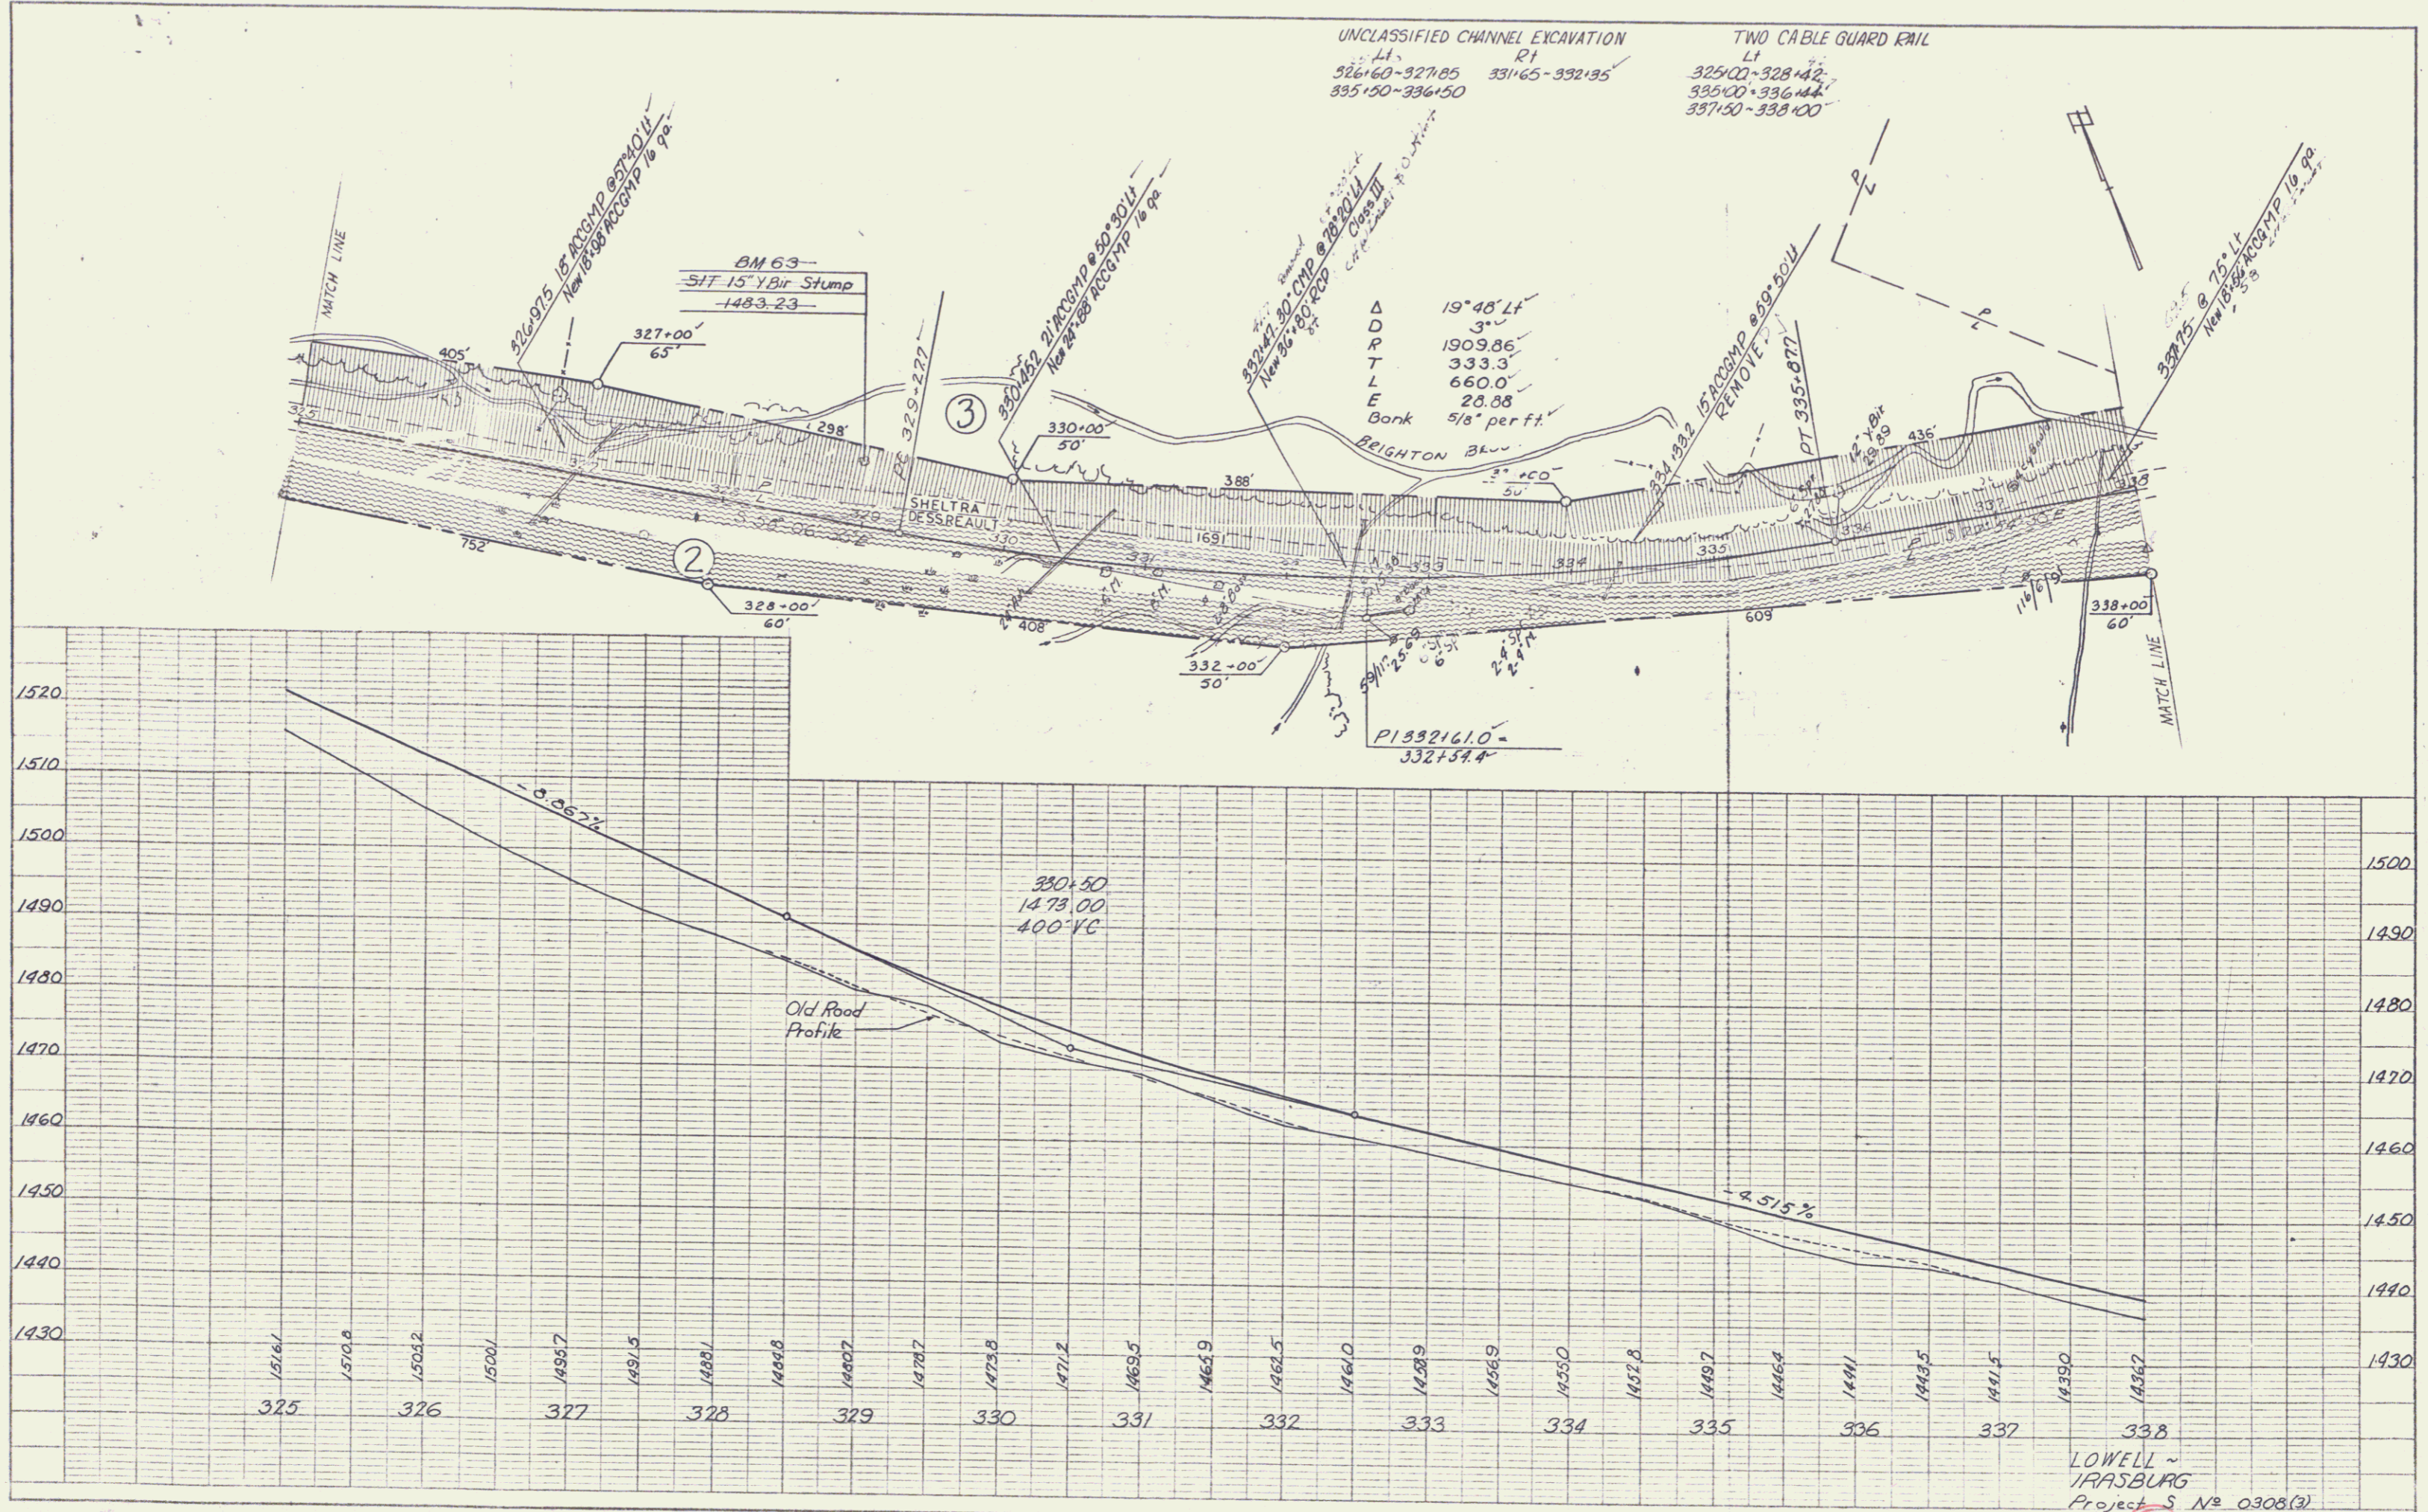


PLATE 1 - PLAN PROFILE OF R.R. STANLEY
 ROUTE 10 - LOWELL - VERMONT
 1/8" = 10' HORIZONTAL
 1" = 10' VERTICAL

LOWELL - VERMONT
 IRASBURG
 Project No. 0308(3)
 Sheet 23 of 60