

PLAN
 DATE: 10/1/67
 DRAWN BY: [illegible]
 CHECKED BY: [illegible]

PROF
 DATE: 10/1/67
 DRAWN BY: [illegible]
 CHECKED BY: [illegible]

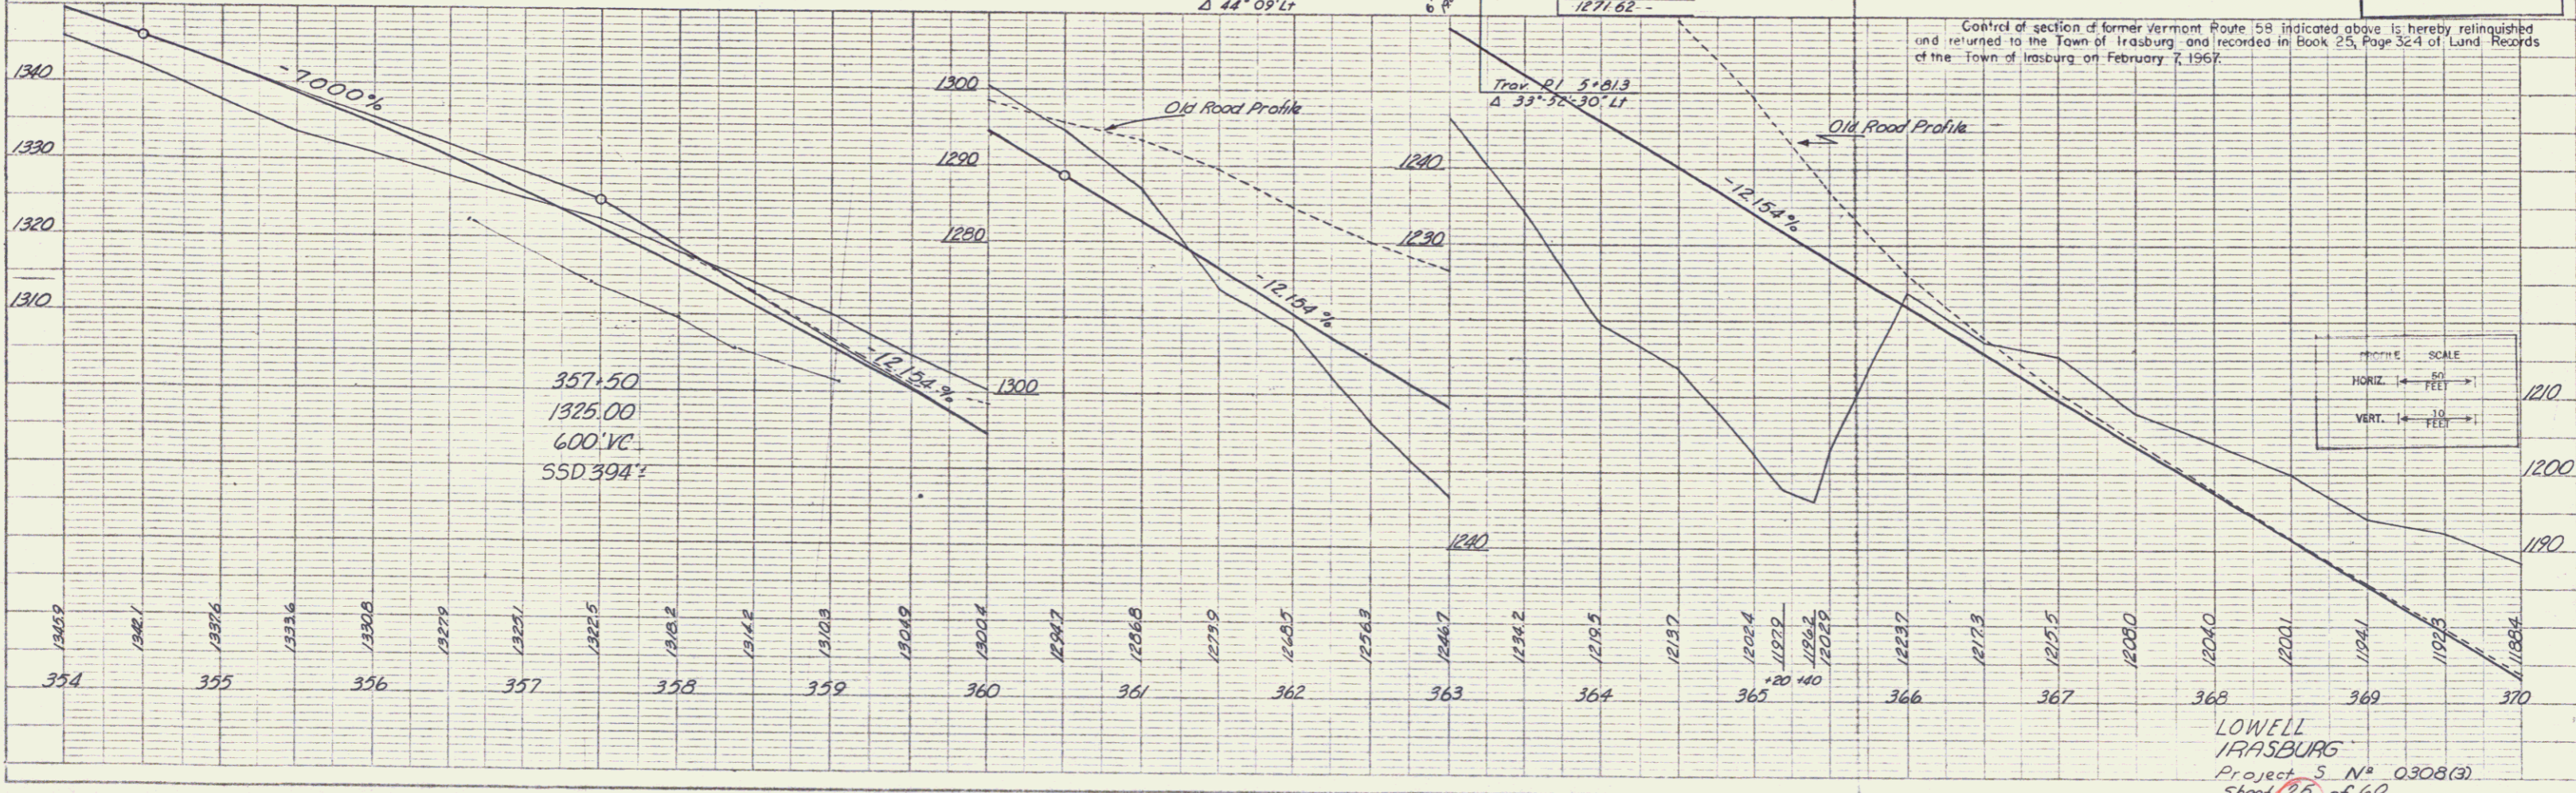
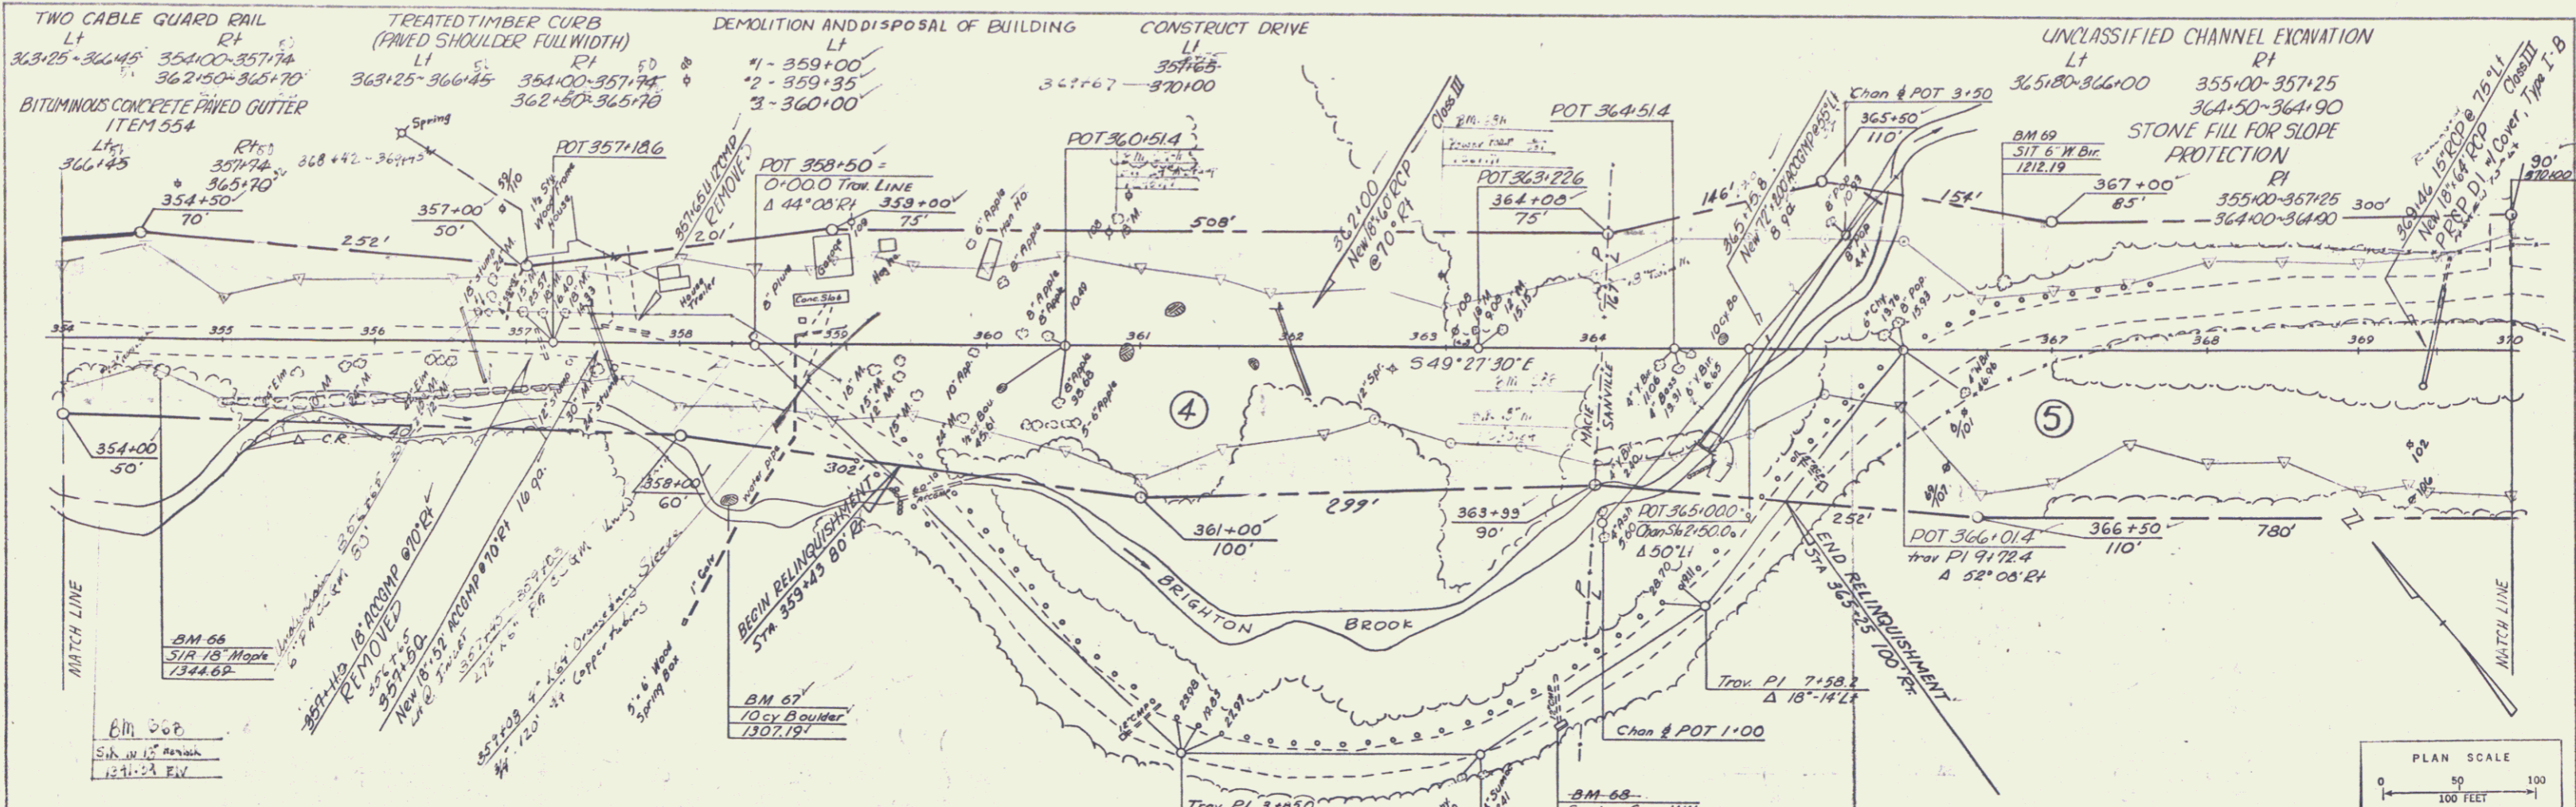


PLATE 1, PLAN, PROFILE & BALKEN STANDARD
 PENNYL & STEIN CO. NEW YORK

LOWELL
 IRASBURG
 Project 5 N° 0308(3)
 Sheet 25 of 60

6