


PLAN  
 DRAWN BY: [unclear]  
 CHECKED BY: [unclear]  
 DATE: [unclear]

PROFILE  
 DRAWN BY: [unclear]  
 CHECKED BY: [unclear]  
 DATE: [unclear]

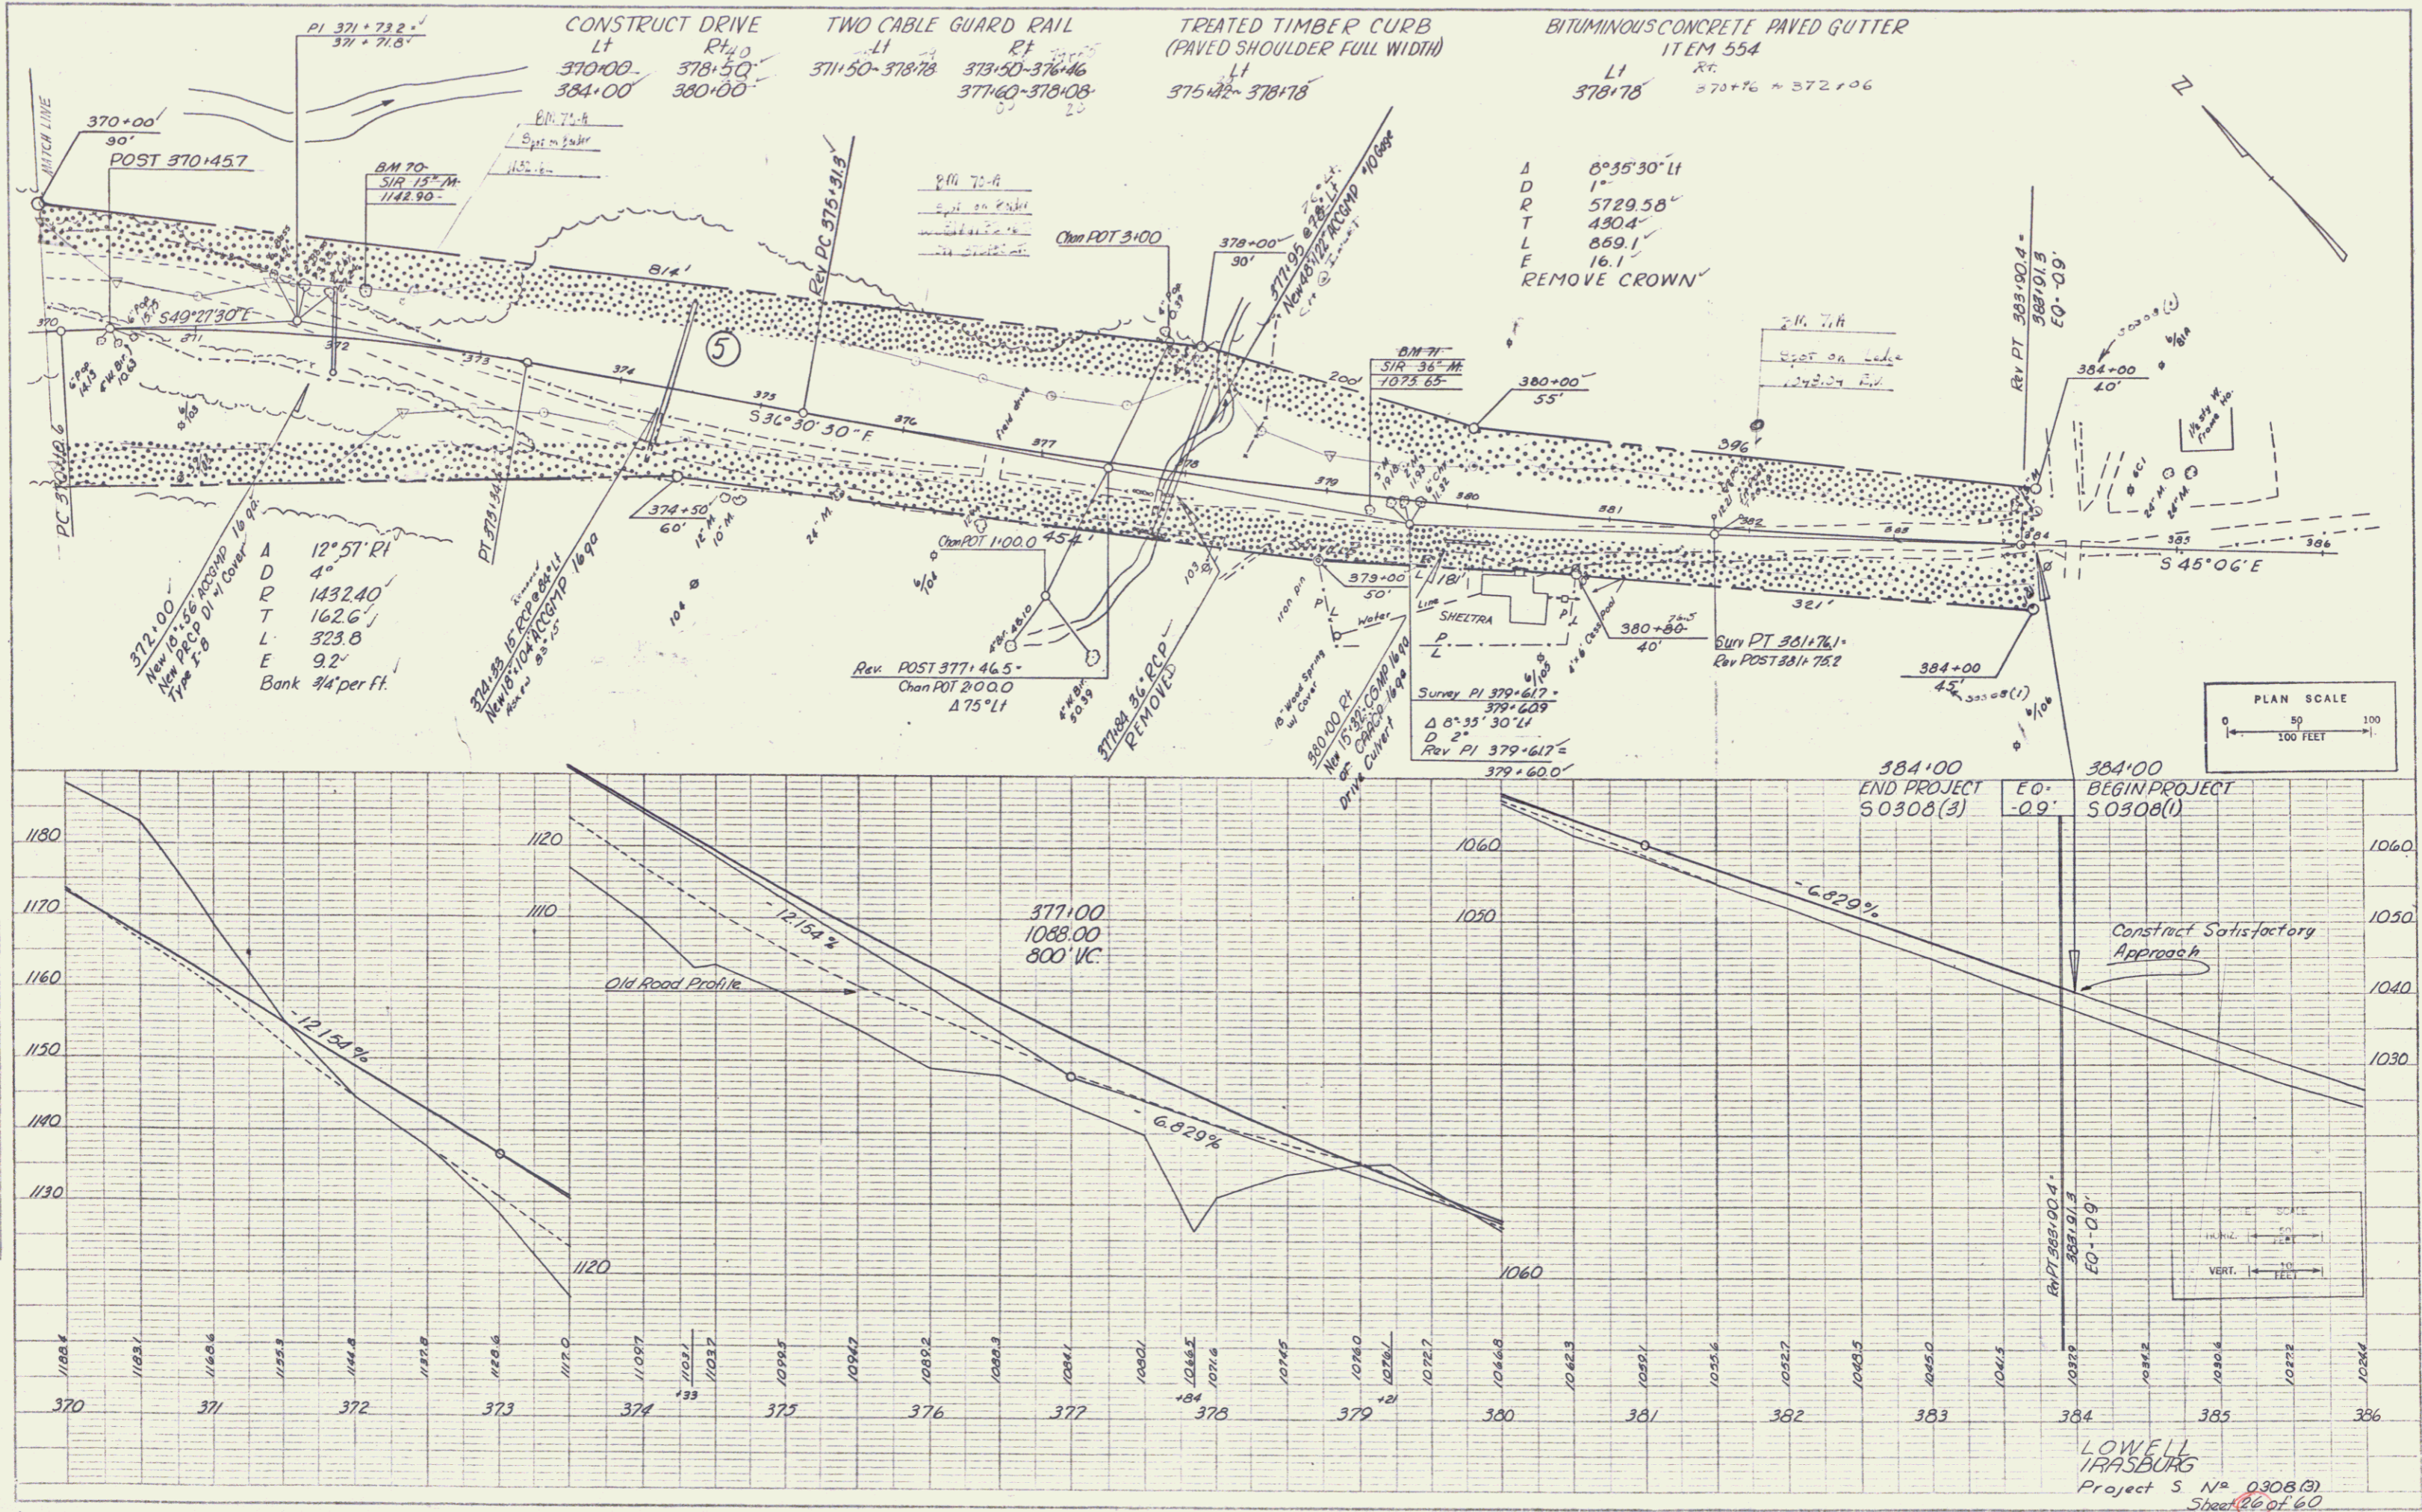

LOWELL  
 FRASBURG  
 Project 5 No. 0308(3)  
 Sheet 2 of 60