
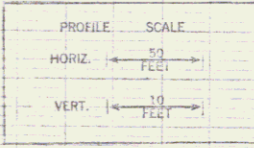
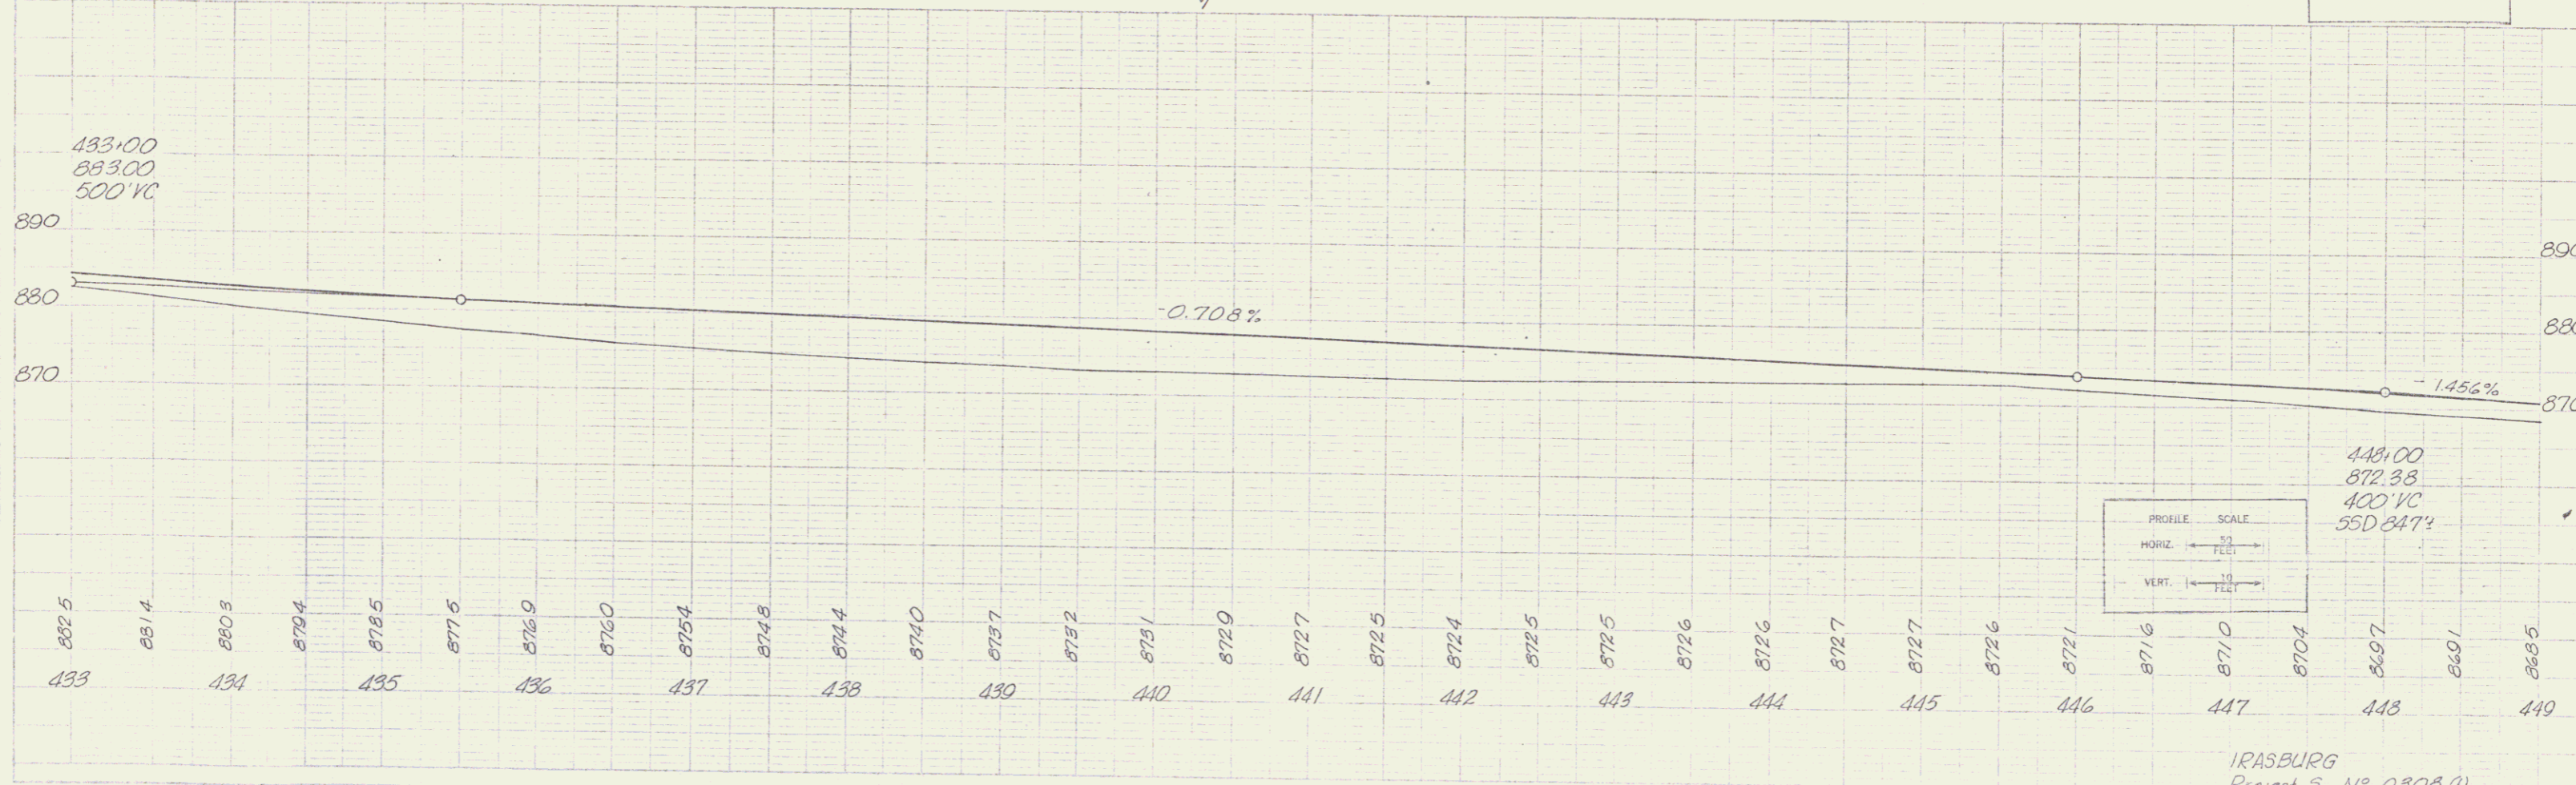


CONSTRUCT DRIVE  
 Lt 433+00 Rt 433+10  
 434+15 438+00  
 438+00

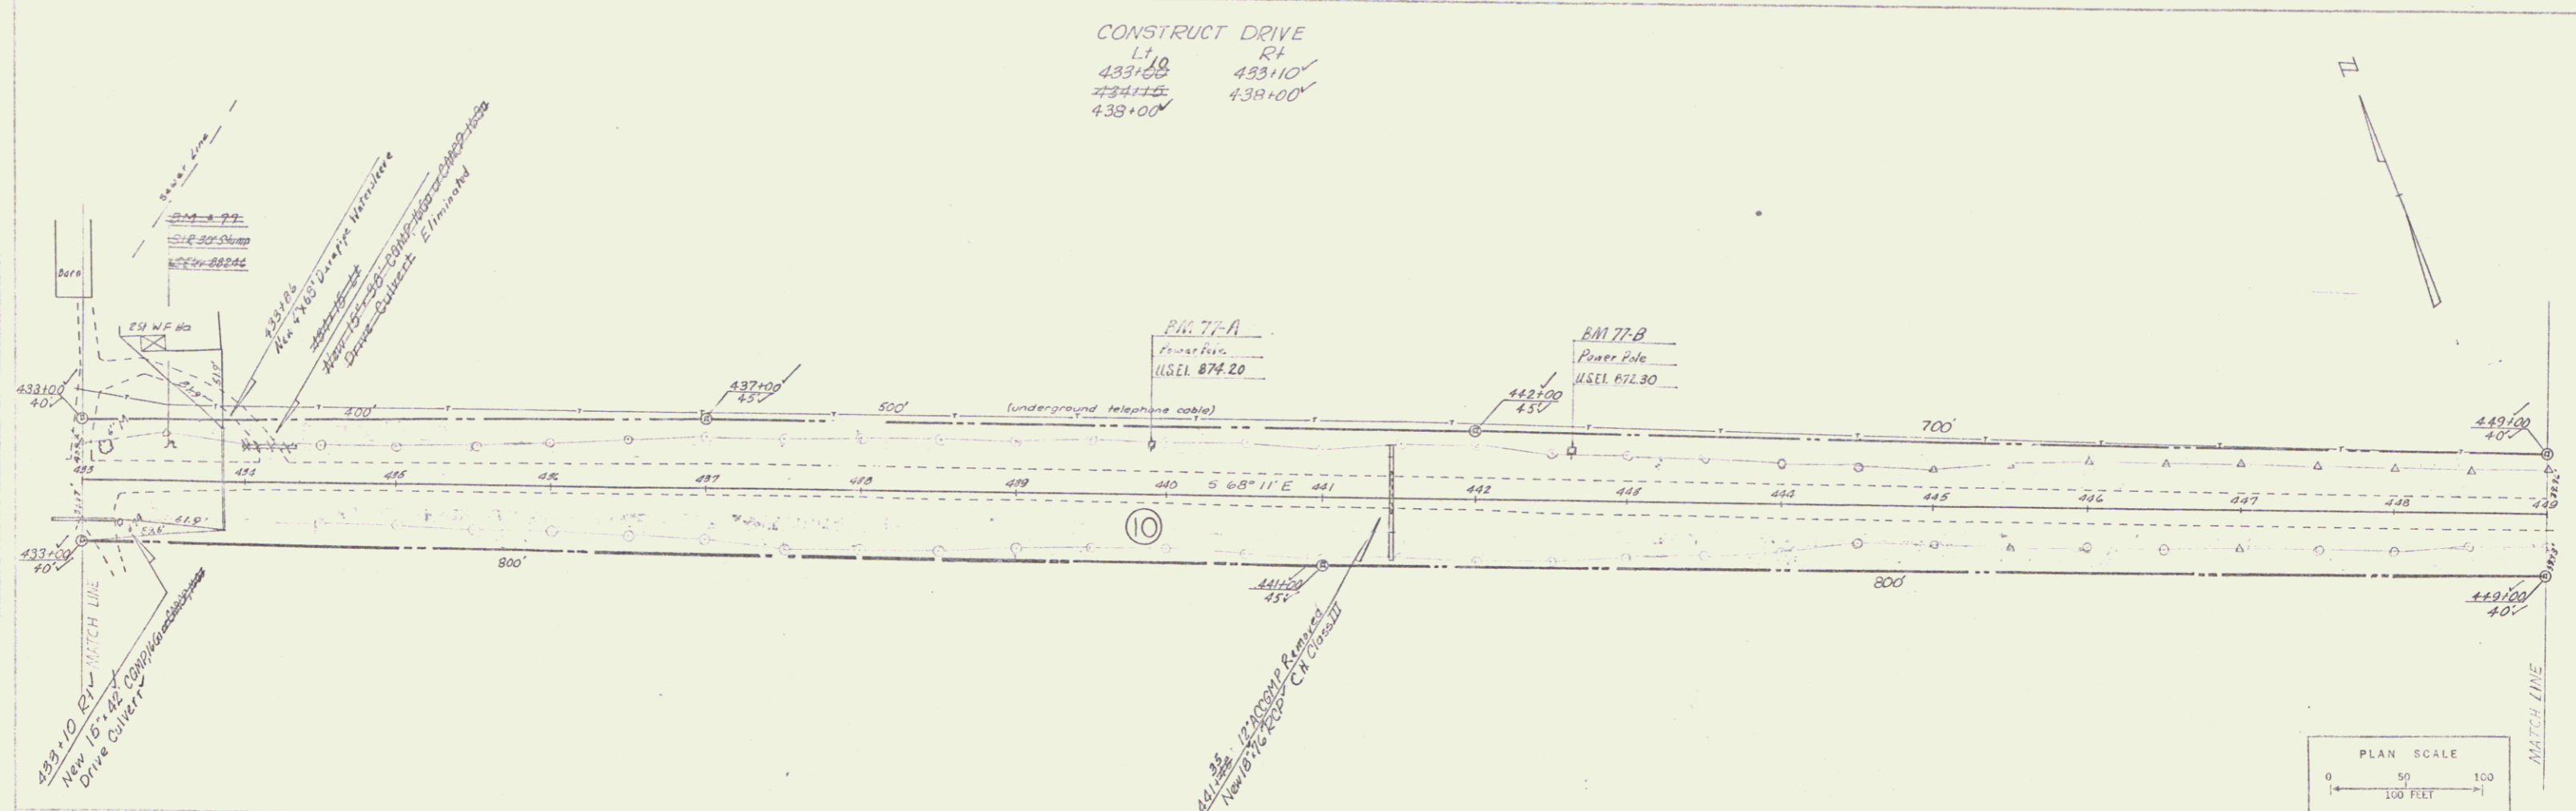

IRASBURG  
 Project 5 No 0303.01  
 Sheet 24 of 67