
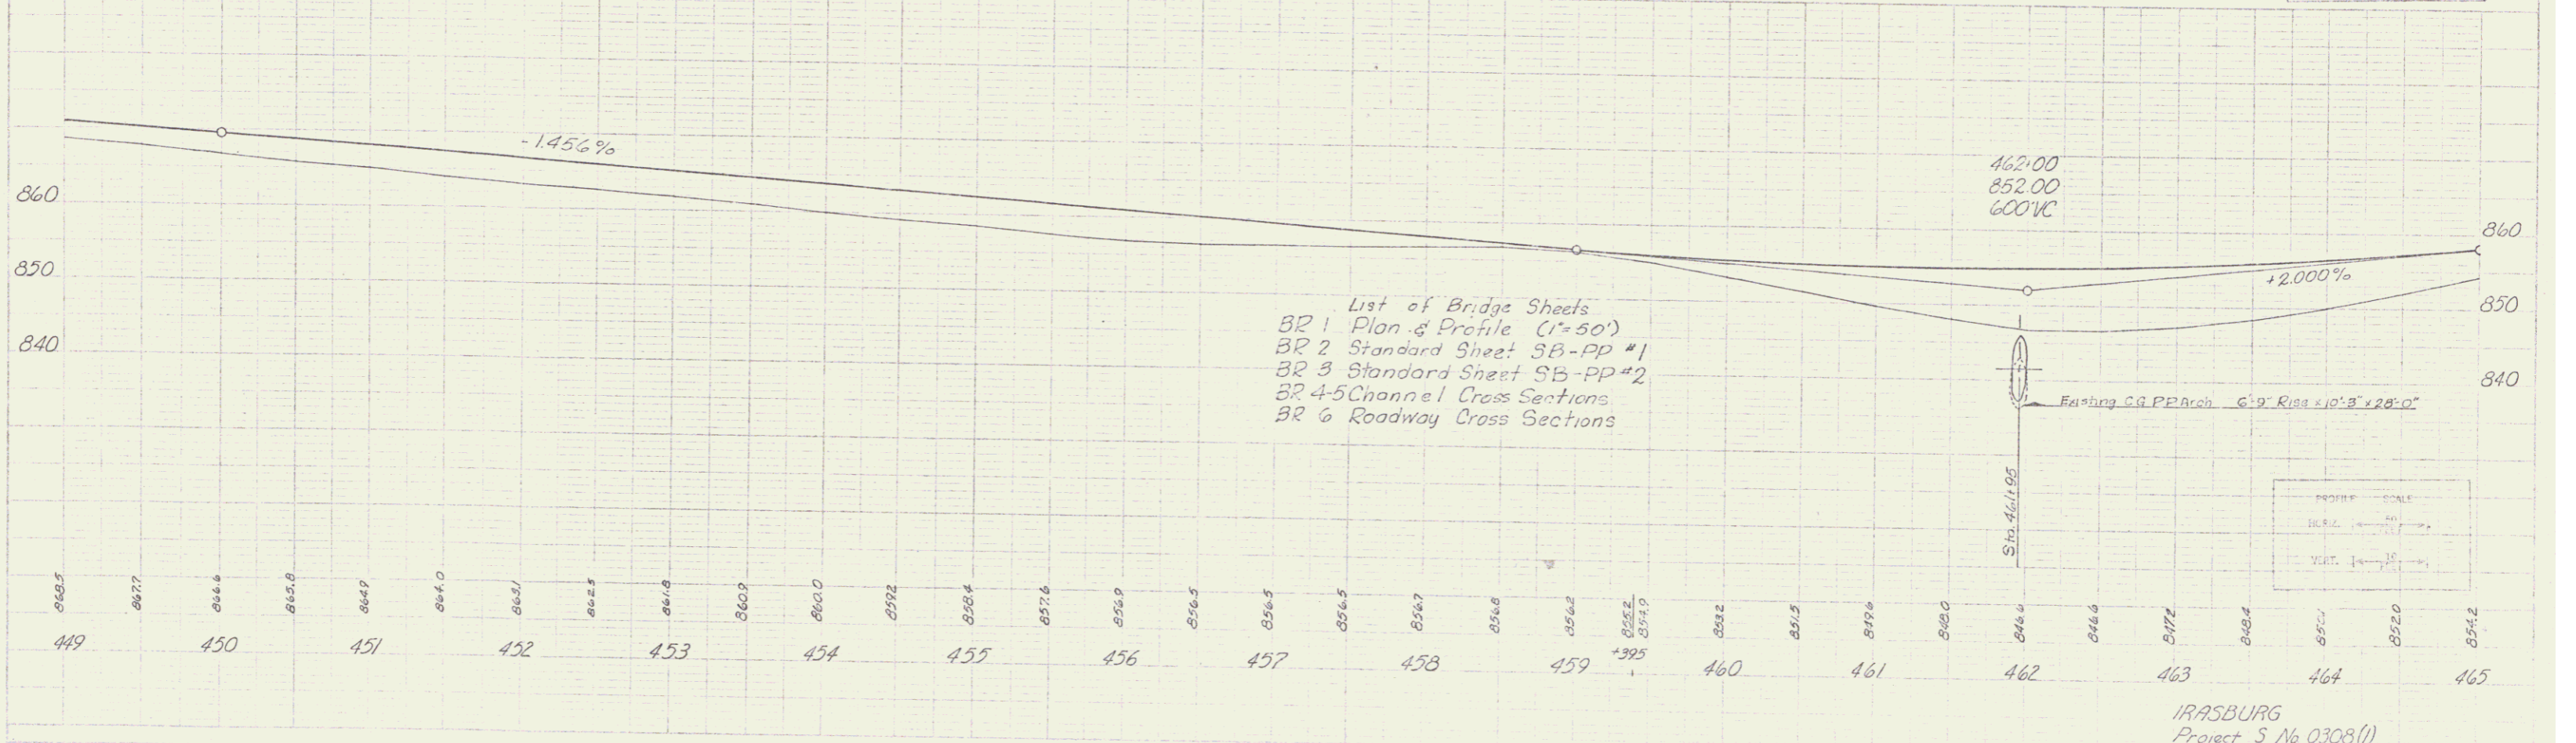


CONSTRUCT DRIVE
 LT 459+75
 RT 458+35
 460+50

REMOVAL AND DISPOSAL OF
 PRESENT GUARD RAIL
 LT 461+25
 RT 461+25

TWO CABLE GUARD RAIL
 LT 461+25
 RT 461+25

CONSTRUCT PAVED SHOULDER Item 361-B
 LT 460+00
 RT 459+25

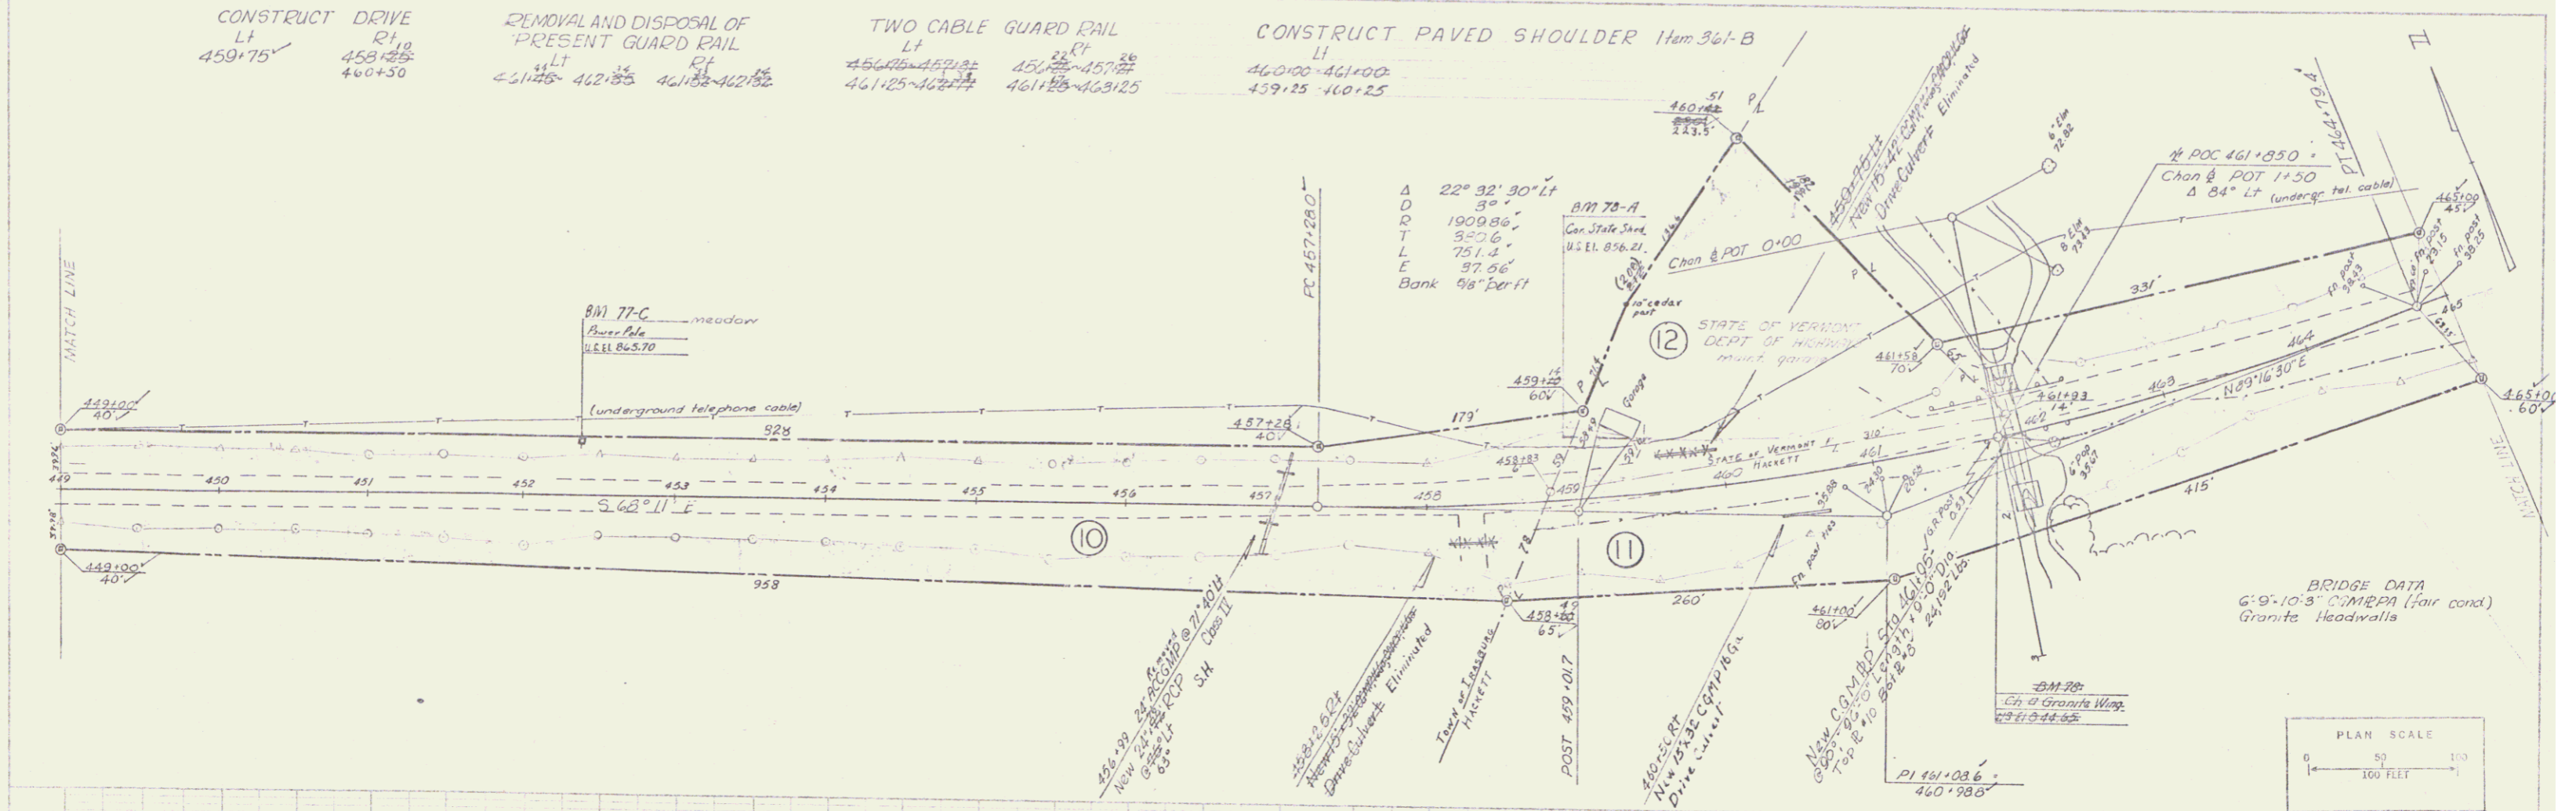

- List of Bridge Sheets
 BR 1 Plan & Profile (1"=50')
 BR 2 Standard Sheet SB-PP #1
 BR 3 Standard Sheet SB-PP #2
 BR 4-5 Channel Cross Sections
 BR 6 Roadway Cross Sections

IRASBURG
 Project S No 0308(1)
 Sheet 53 of 67