

INDEX OF SHEETS

SHEET NO.	1	TITLE PAGE
"	2	TYPICAL CROSS-SECTION OF IMPROVEMENT STABILIZED GRAVEL BASE COURSE OF CUTBACK ASPHALT WITH SAND SEAL ITEM 303-B
"	3	BANKING AND WIDENING TABLES
"	4	CONSTRUCTION DETAILS (DRAINAGE & MARKERS)
"	5	CONSTRUCTION DETAILS CD-1 (DITCHES)
"	6	STANDARD STRUCTURE SHEET S 40 BARRICADES SIGNS & LIGHTS
"	7	QUANTITY SHEET (ITEMS & DRAINAGE)
"	8-9	EARTHWORKS
"	10-13	PLAN & PROFILE
"	14	CORR. GALV. METAL PLATE PIPE
"	15-21	CROSS SECTIONS

STANDARD STRUCTURE SHEET APPROVED BY THE CHIEF ENGINEER, VERMONT DEPARTMENT OF HIGHWAYS. — S-40 JULY 10, 1950

STATE OF VERMONT
STATE HIGHWAY DEPARTMENT



PLAN AND PROFILE OF PROPOSED
STATE HIGHWAY

SECONDARY PROJECT
TOWN OF IRASBURG
COUNTY OF ORLEANS
VT. ROUTE 58
IRASBURG-ORLEANS ROAD

BEGINNING AT A POINT APPROXIMATELY 143 FEET EASTERLY OF ITS INTERSECTION WITH VT. ROUTE 128 AND EXTENDING EASTERLY 3093.5 FEET.

LENGTH OF PROJECT 3093.5 FT. = 0.586 MI.

DIV. NO.	STATE	FED. AID PROJ. NO.	FISCAL YEAR	SHEET NO.	TOTAL SHEETS
1	Vt.	5 5512	1953	1	1

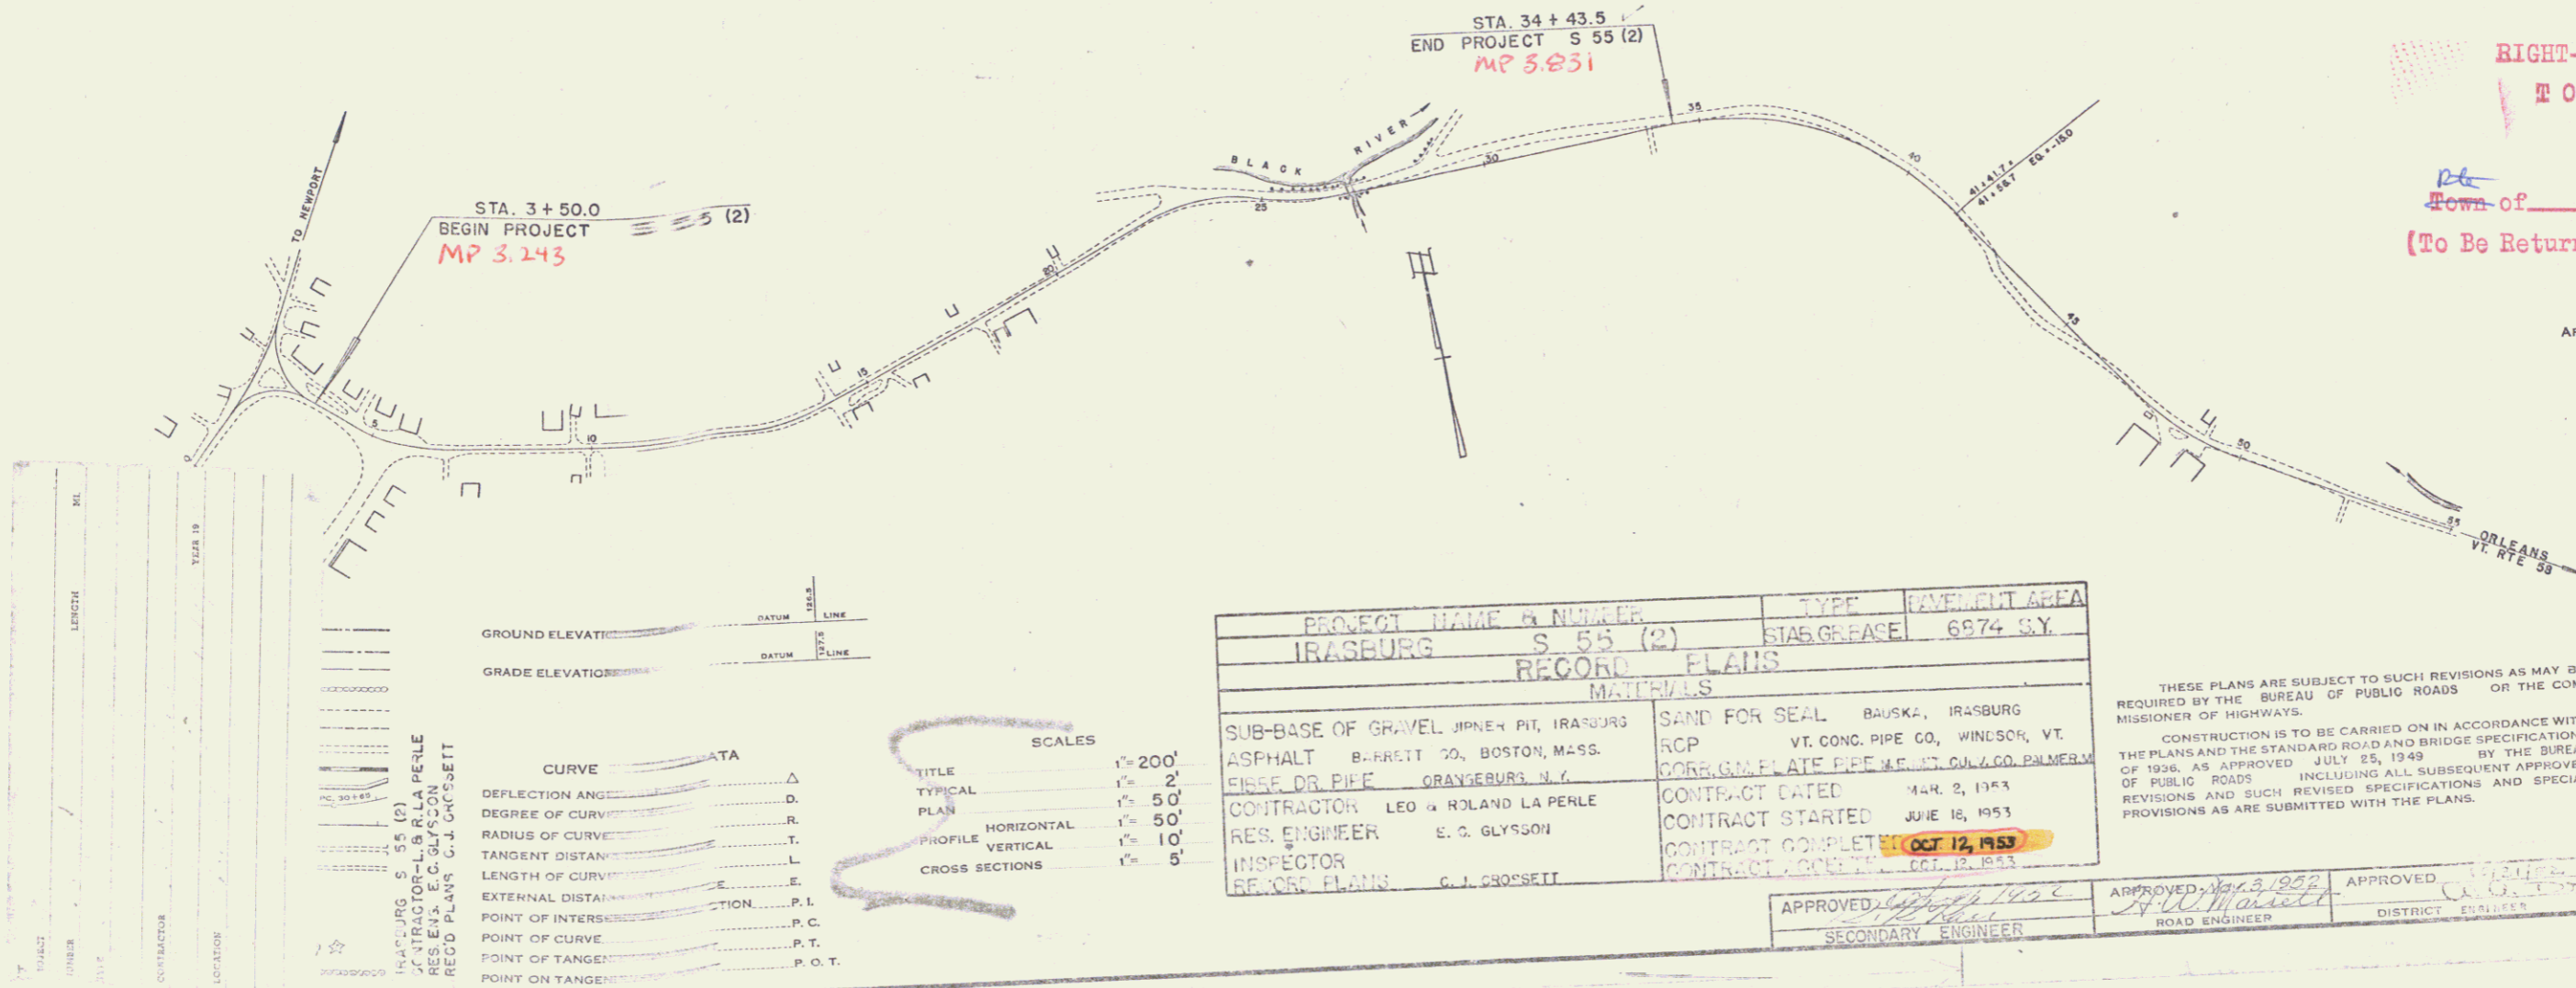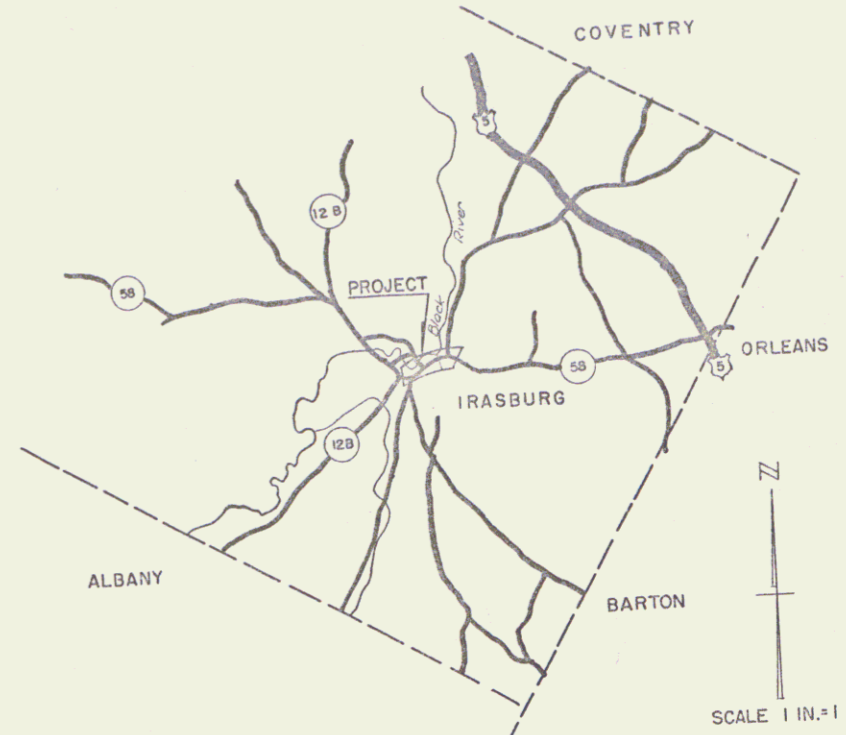

RIGHT-OF-WAY DIVISION
TOWN FILE
PERPETUAL
Town of Irasburg
(To Be Returned To R.O.W. Division)

APPROVED: *Nov 3, 1952*
H.E. Sargent
ENGINEER
SUBMITTED BY ORDER OF THE STATE HIGHWAY BOARD

NOTE: ANY CHANGES TO THESE PLANS MUST BE APPROVED BY THE BUREAU OF PUBLIC ROADS BEFORE THE FIELD START OF CONSTRUCTION.

DEPARTMENT OF COMMERCE
BUREAU OF PUBLIC ROADS
RECOMMENDED FOR APPROVAL

DISTRICT ENGINEER
APPROVED: *Pin # OR 328*
DIVISION ENGINEER

APPROVED: *Nov 3, 1952*
A.W. Marlett
ROAD ENGINEER
APPROVED: *C. J. Crosssett*
DISTRICT ENGINEER
PROJECT S NO 55(2) FILED
SHEET 1 OF 21

Irasburg '53