


Wood Guide Posts
 Sta. 24 RF
 13+0 1 1

CONSTRUCT DRIVES
 LT RT
 4+20 to 6+20 6+62
 9+52 9+83
 14+10 14+27
 14+05 14+05
 0+0

CONSTRUCT APPROACH
 5+50.5 RT

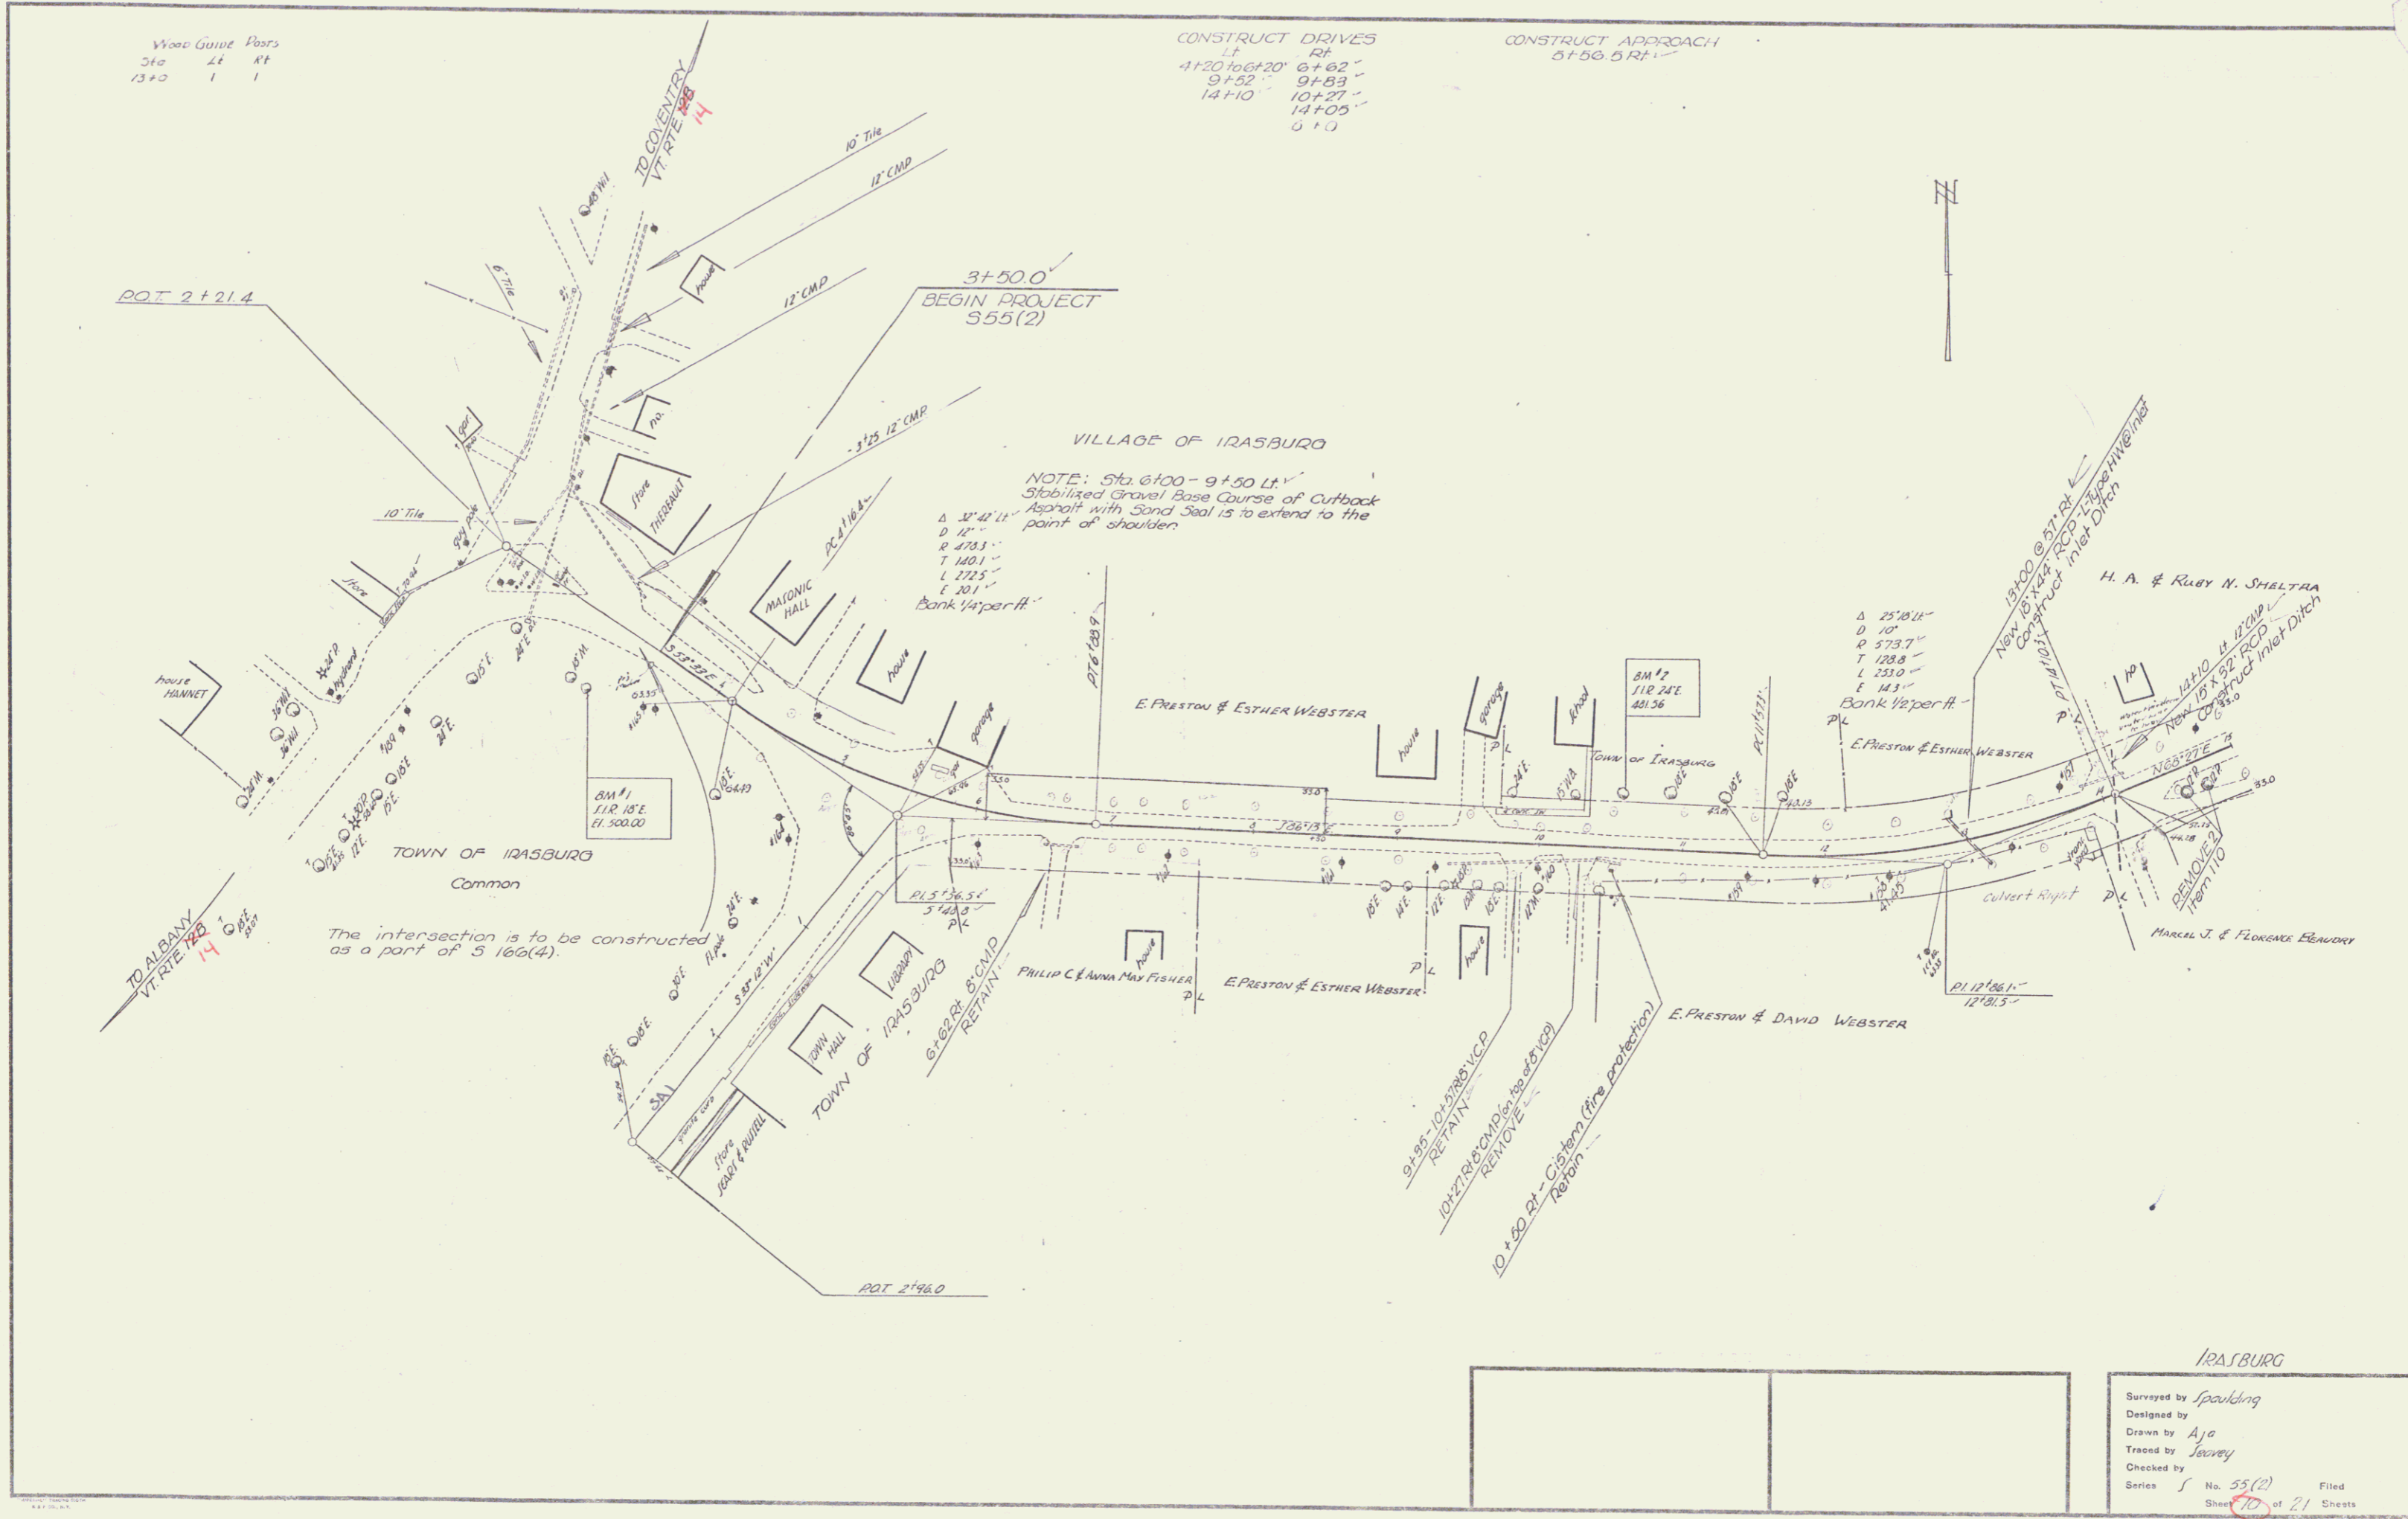

VILLAGE OF IRASBURG
 NOTE: Sta. 6+00 - 9+50 LT
 Stabilized Gravel Base Course of Cutback
 Asphalt with Sand Seal is to extend to the
 point of shoulder.
 Δ 32' 41" L
 D 12"
 R 473.3"
 T 140.1"
 L 72.5"
 E 10.1"
 Bank 1/4 per ft

The intersection is to be constructed
 as a part of S 166(4).

IRASBURG

Surveyed by	Spaulding
Designed by	
Drawn by	Ajo
Traced by	Seavey
Checked by	
Series	No. 55(2) Filed
Sheet	10 of 21 Sheets