



Sounding 1946
 TRILEAF ROBERTS 1946

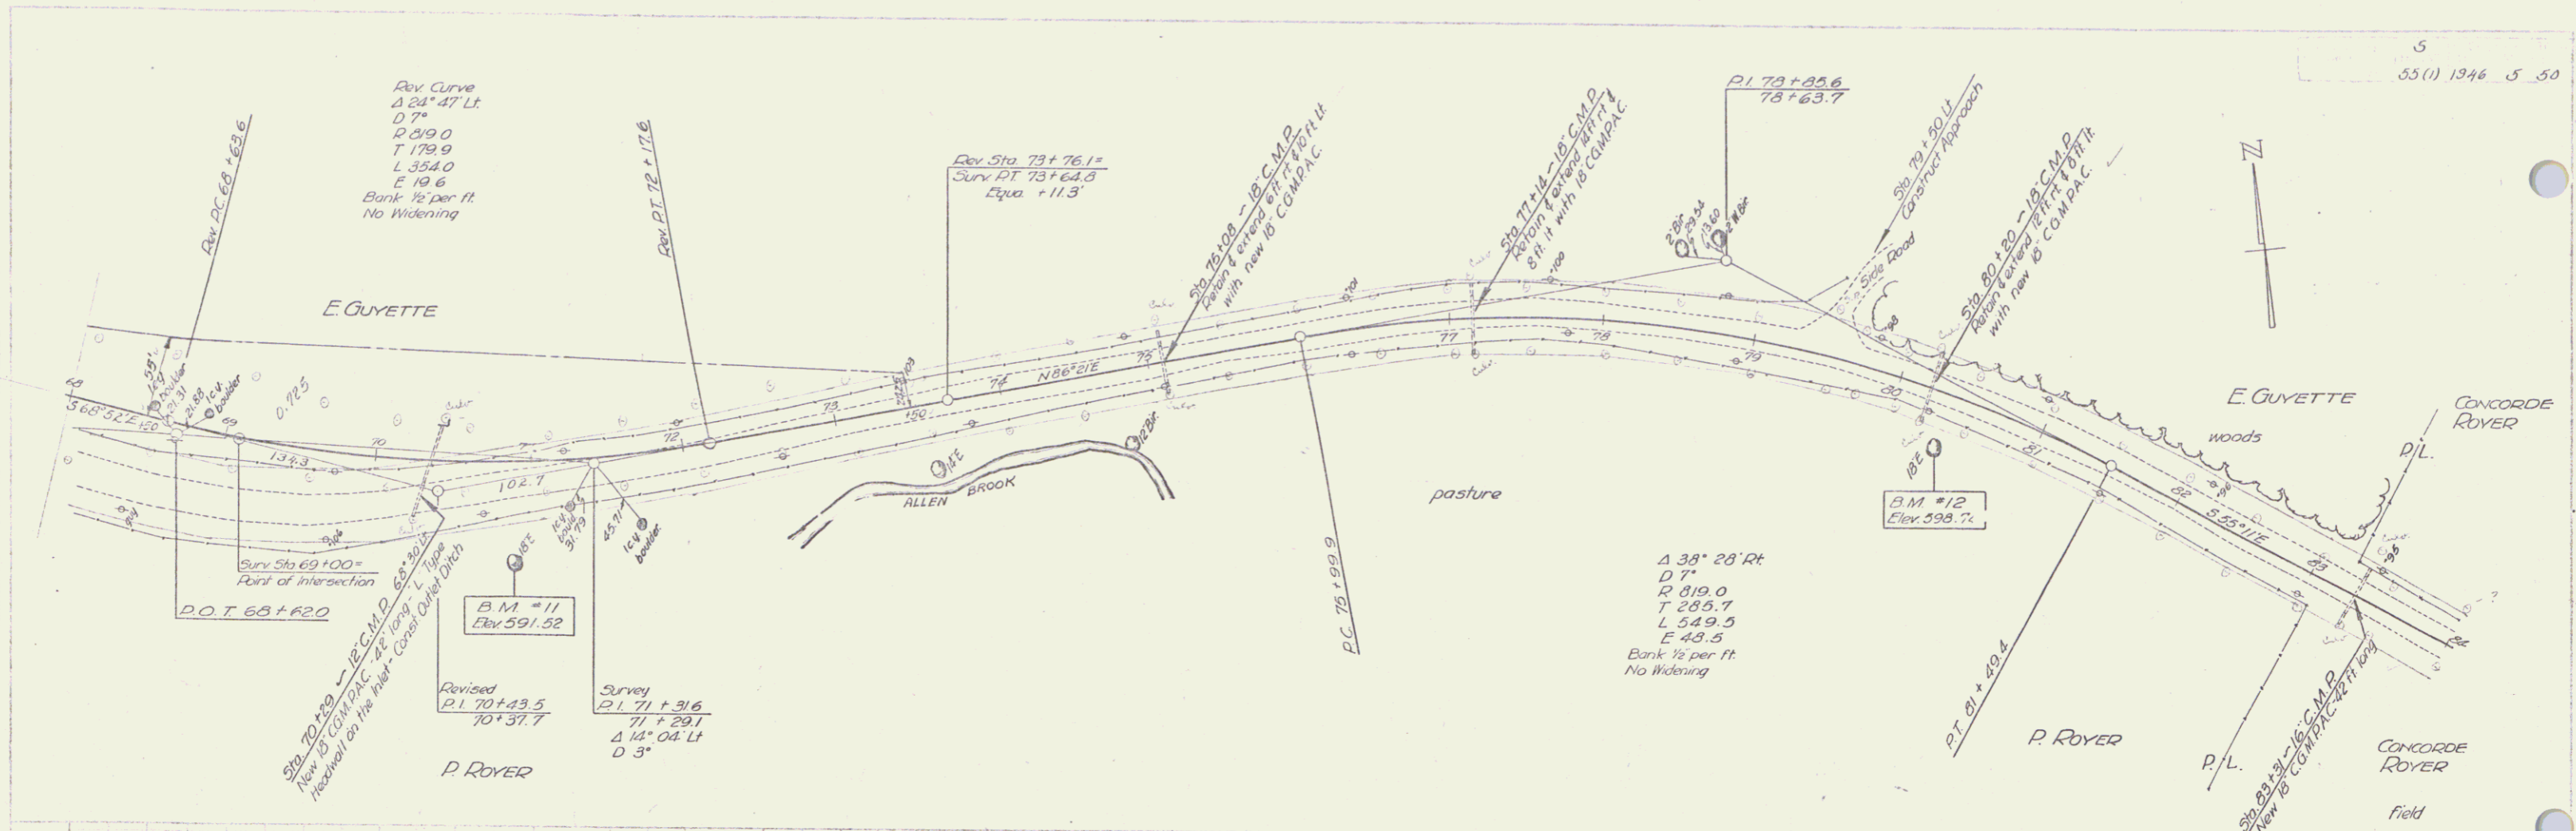

P. 1946
 1946

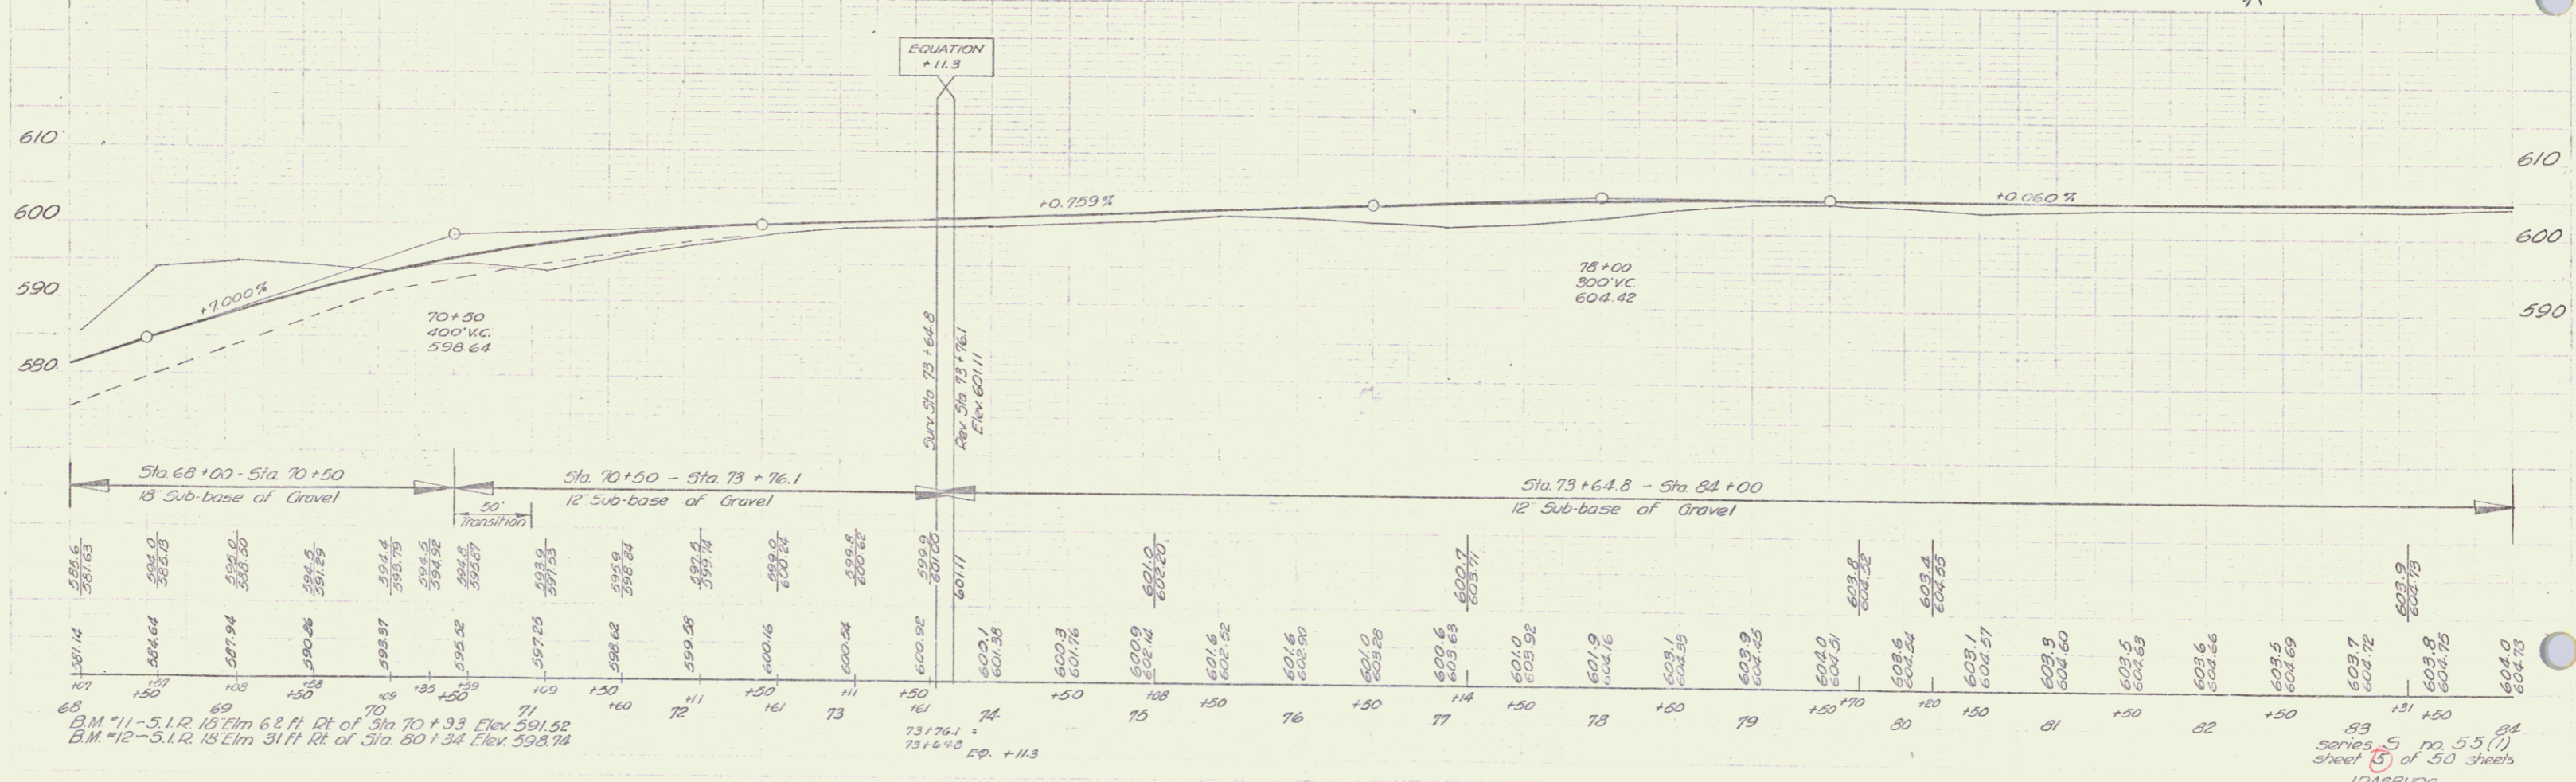

B.M. #11 - S.I.R. 15 Elm 62 ft. Pt. of Sta 70+93 Elev 591.52
 B.M. #12 - S.I.R. 18 Elm 31 ft. Rt. of Sta 80+34 Elev 598.74

Series 5 of 50 sheets
 sheet 15 of 50 sheets
 IRASBURG