
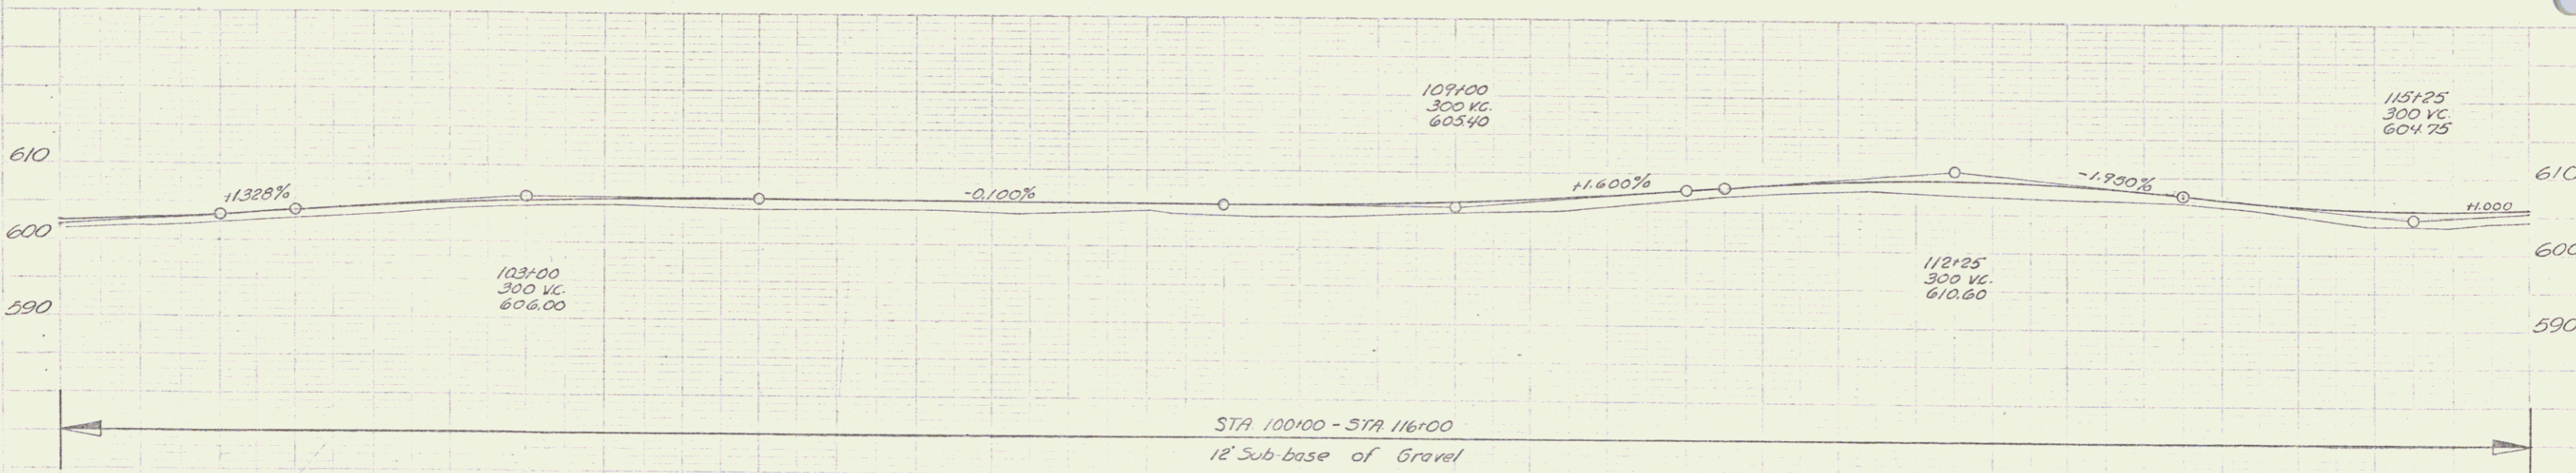


PLAN
 1946
 1946
 REBERS
 TRACED

PLAN
 1946
 1946
 REBERS
 TRACED

5
 55(1) 1946 7 50

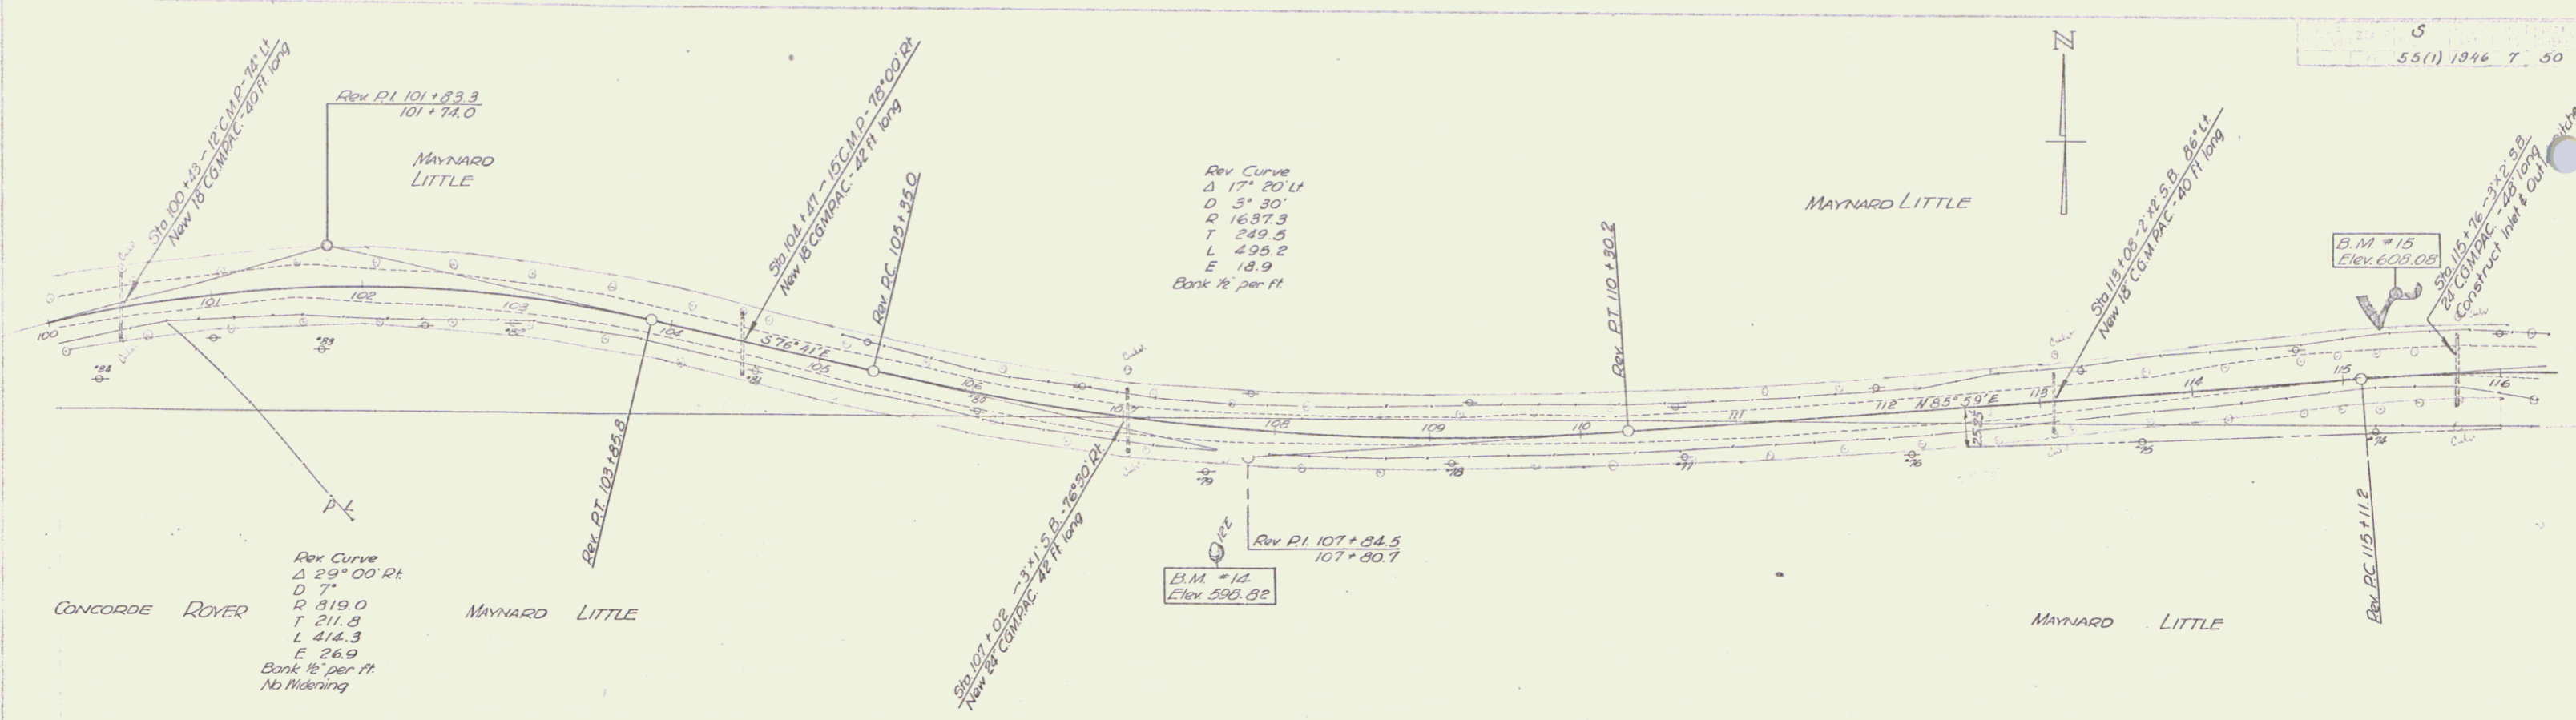

Station	Elevation
100+00	604.32
100+10	604.32
100+20	604.32
B.M. #14 - 5.1 T. 12' E. 76.1' N. of Sta. 107+16.5 Elev. 598.82
 B.M. #15 - Spot on ledge 50 Ft. N. of Sta. 115+34 Elev. 608.08

Series 55(1)
 sheet 7 of 50 sheets
 REBERS

5