

PLAN
 SUBMITTED BY
 DATE
 NOTE BOOK NO.
 PLANT CHECKED BY
 DATE


PROFILE
 DATE
 BY
 NOTE BOOK NO.
 PLANT CHECKED BY
 DATE

TOWN OF BARTON
 Pin # 00R332
 Project District 9
 Route VT 58
 01/01/1930

Under Town Control

STA 7+23
 MPO 754

D-6
 T-179.8
 L-223.9
 E-20.7
 R
 27.4-57

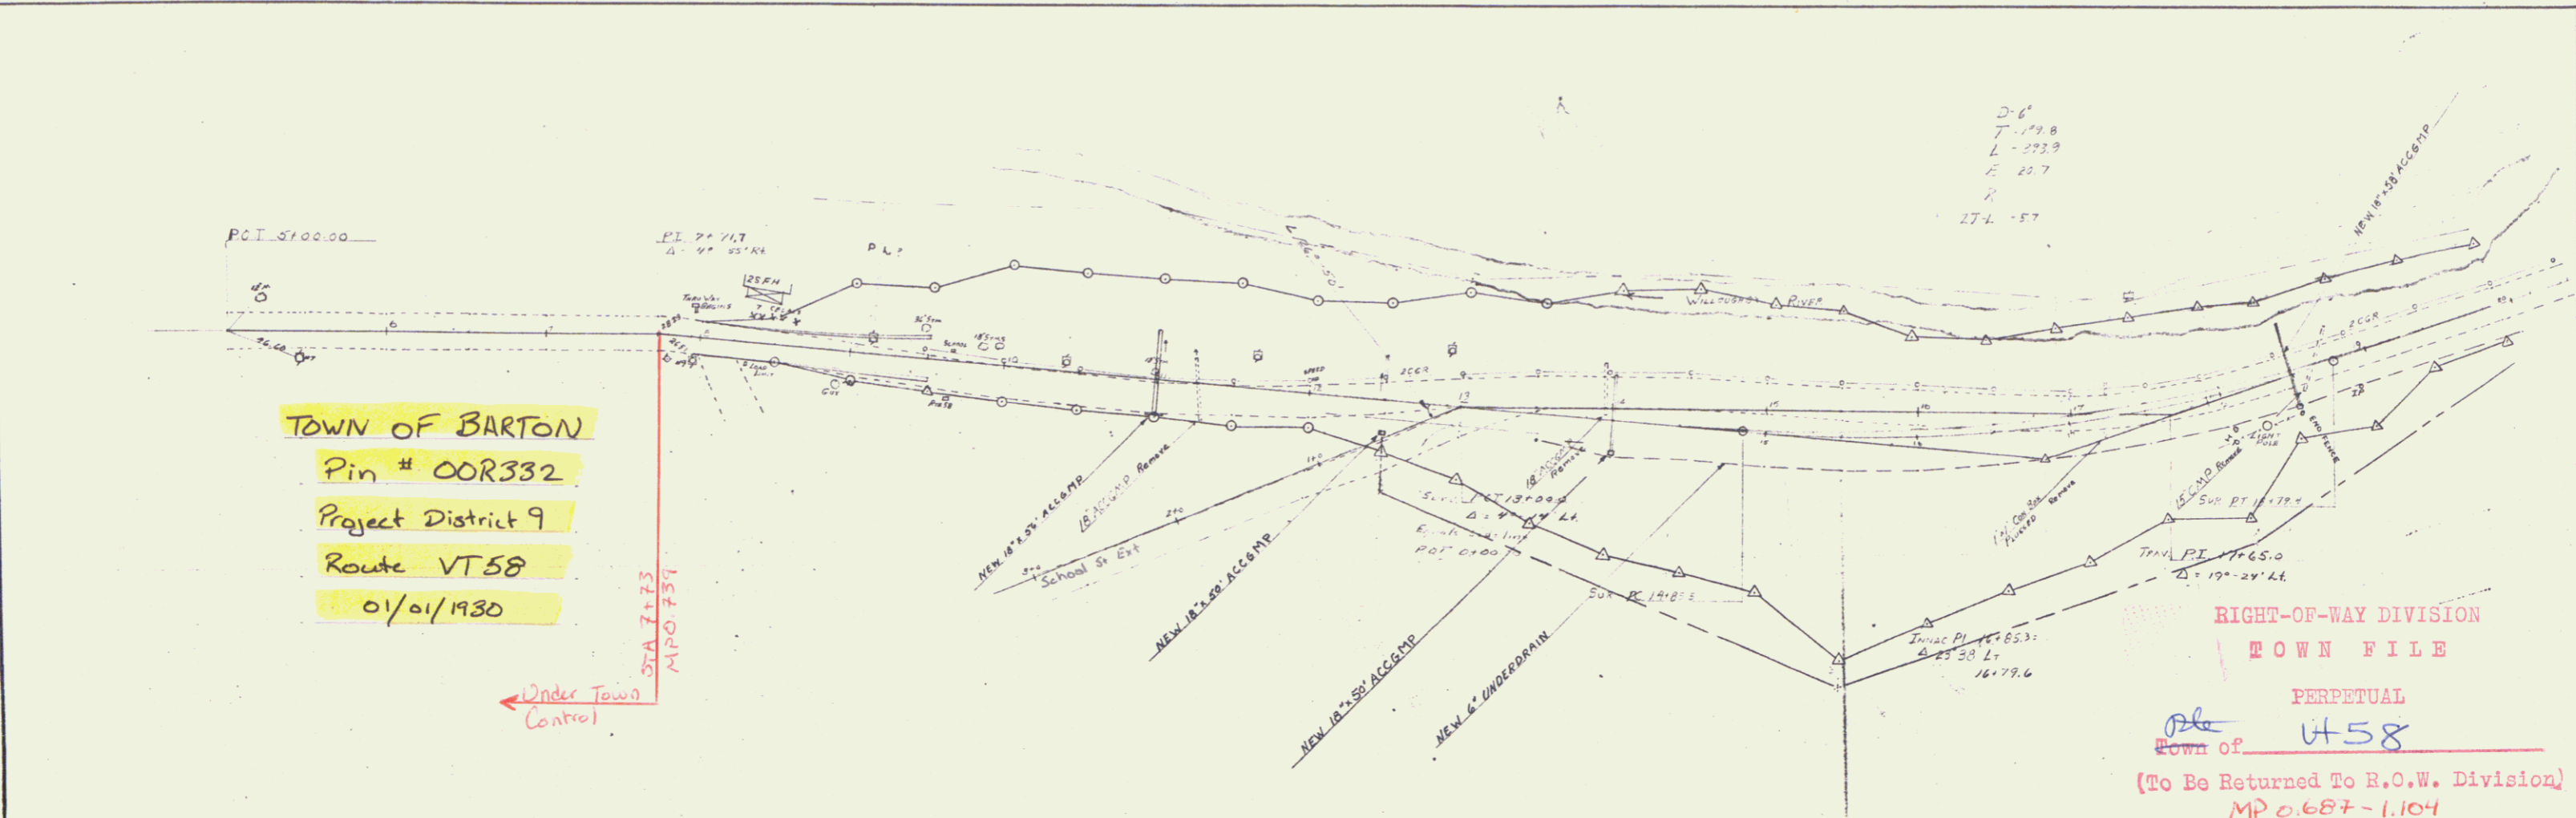

RIGHT-OF-WAY DIVISION
 TOWN FILE
 PERPETUAL
 Town of U58
 (To Be Returned To R.O.W. Division)
 MP 0.687-1.104