

1. TITLE
 2. QUANTITY AND EARTHWORK SHEET
 3. RIGHT OF WAY DETAIL SHEET
 4. PLAN
 5. PROFILE, BORINGS, & TYPICAL SECTION
 6. SUPERSTRUCTURE DETAILS & GENERAL NOTES
 7. ABUTMENT DETAILS
 8. PIER DETAILS
 9. REINFORCING SCHEDULE
 - 10/11. ROADWAY SECTIONS
 - 12-16. CHANNEL SECTIONS
- BRIDGE STANDARDS
17. SCB-DI-71 1-24-72
 18. SCB-D6-71, DET. A 12-14-71
 19. SB-R4-71 12-14-71
- ROADWAY STANDARDS
20. B-5 EMBANKMENT ON EARTH SLOPE 12-6-71
 21. E-3 BRIDGE CONSTRUCTION APPROACH SIGNS 12-14-71
 22. E-5 ROAD CONSTRUCTION SIGNS-BETTERMENT PROJECTS 12-14-71
 23. E-7 BARRICADES 12-14-71
 24. G-16 GUARD RAIL BOX BEAM WITH STEEL POSTS 10-1-71
 25. J-1 ERECTION OF PROJECT MARKERS, BOUNDARY MARKERS 12-6-71

BROWNINGTON BP 0310-7110
 RECORD PLANS PAVEMENT AREA
 MATERIALS 709 S.Y.

SUBBASE OF GRAVEL — CALKINS PIT — COVENTRY, VT.
 BITUMINOUS CONCRETE — L.M. PIKE & SON, INC. — WILLISTON, VT.
 CONCRETE CLASS B — CALKINS READY MIX — COVENTRY, VT.
 STEEL PILING & REINFORCING STEEL — PIONEER VALLEY STEEL CO.
 (BETHLEHEM STEEL) — GREENFIELD, MA.
 WATER REPELLENT — KIBBY EQUIPMENT CO. — WHITE RIVER JCT., VT.
 GRANITE BRIDGE CURB — CETRANGOLO FINISHING WORKS, INC. —
 NORTHFIELD, VT.
 BRIDGE RAILING — D.W. HUBBELL & SONS, INC. — NEW HARTFORD, N.Y.
 GUARD RAIL — GRISWOLD FENCE CO. — WILLISTON, VT.

CONTRACTOR
 BRIDGES INC.
 MONTPELIER, VT.
 RES. ENG. — MARK G. HUTCHINS.
 RECORD PLANS — A.G. SPIDLE.

CONTRACT
 DATED — JUNE 22, 1972.
 STARTED — JULY 17, 1972.
 COMPLETED — DECEMBER 7, 1972.
 ACCEPTED — DECEMBER 7, 1972.

NOTE: ANY FURTHER INFORMATION CONCERNING
 FINAL QUANTITIES, ADJUSTS OR OTHER DETAILS
 RELATIVE TO THIS PROJECT MAY BE FOUND IN
 EITHER THE FIELD BOOKS OR THE ESTIMATE
 FILE.

CONVENTIONAL SIGNS

BROWNINGTON BP 0310-7110
 CONTRACTOR — BRIDGES, INC. — MONTPELIER, VT.
 RECORD PLANS — A.G. SPIDLE.
 CONST. COMPLETED — DECEMBER 7, 1972.

STATE OF VERMONT
 DEPARTMENT OF HIGHWAYS

PROPOSED IMPROVEMENT

BRIDGE PROJECT

TOWN OF BROWNINGTON


ORLEANS COUNTY

VT ROUTE 58, BRIDGE #13 OVER WILLOUGHBY RIVER

BEGINNING ON VT 58 APPROXIMATELY 2.5 MILES WEST OF THE
 INTERSECTION OF VT 58 AND VT 5A AND EXTENDING
 350 FEET NORTHWEST ALONG VT. 58

THE PROJECT SHALL CONSIST OF REMOVAL OF EXISTING
 SUPERSTRUCTURE AND ABUTMENTS, REPAIR OF
 EXISTING PIERS, CONSTRUCTION OF NEW SUPERSTRUCTURE
 AND ABUTMENTS, AND NECESSARY APPROACH WORK.

LENGTH OF BRIDGE = 84 FEET = 0.016 MILES.
 LENGTH OF ROADWAY = 266 FEET = 0.050 MILES.
 LENGTH OF PROJECT = 350 FEET = 0.066 MILES.

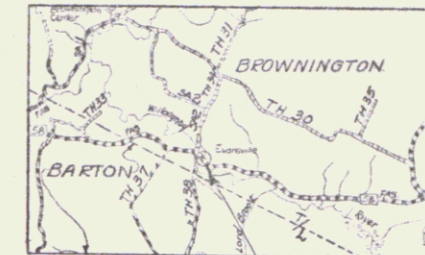


PROJECT-BR0310-7110

Br # 13
 MP 0.82

RIGHT-OF-WAY DIVISION
 TOWN FILE

PERPETUAL

Rte
 Town of VT 58
 (To Be Returned To R.O.W. Division)

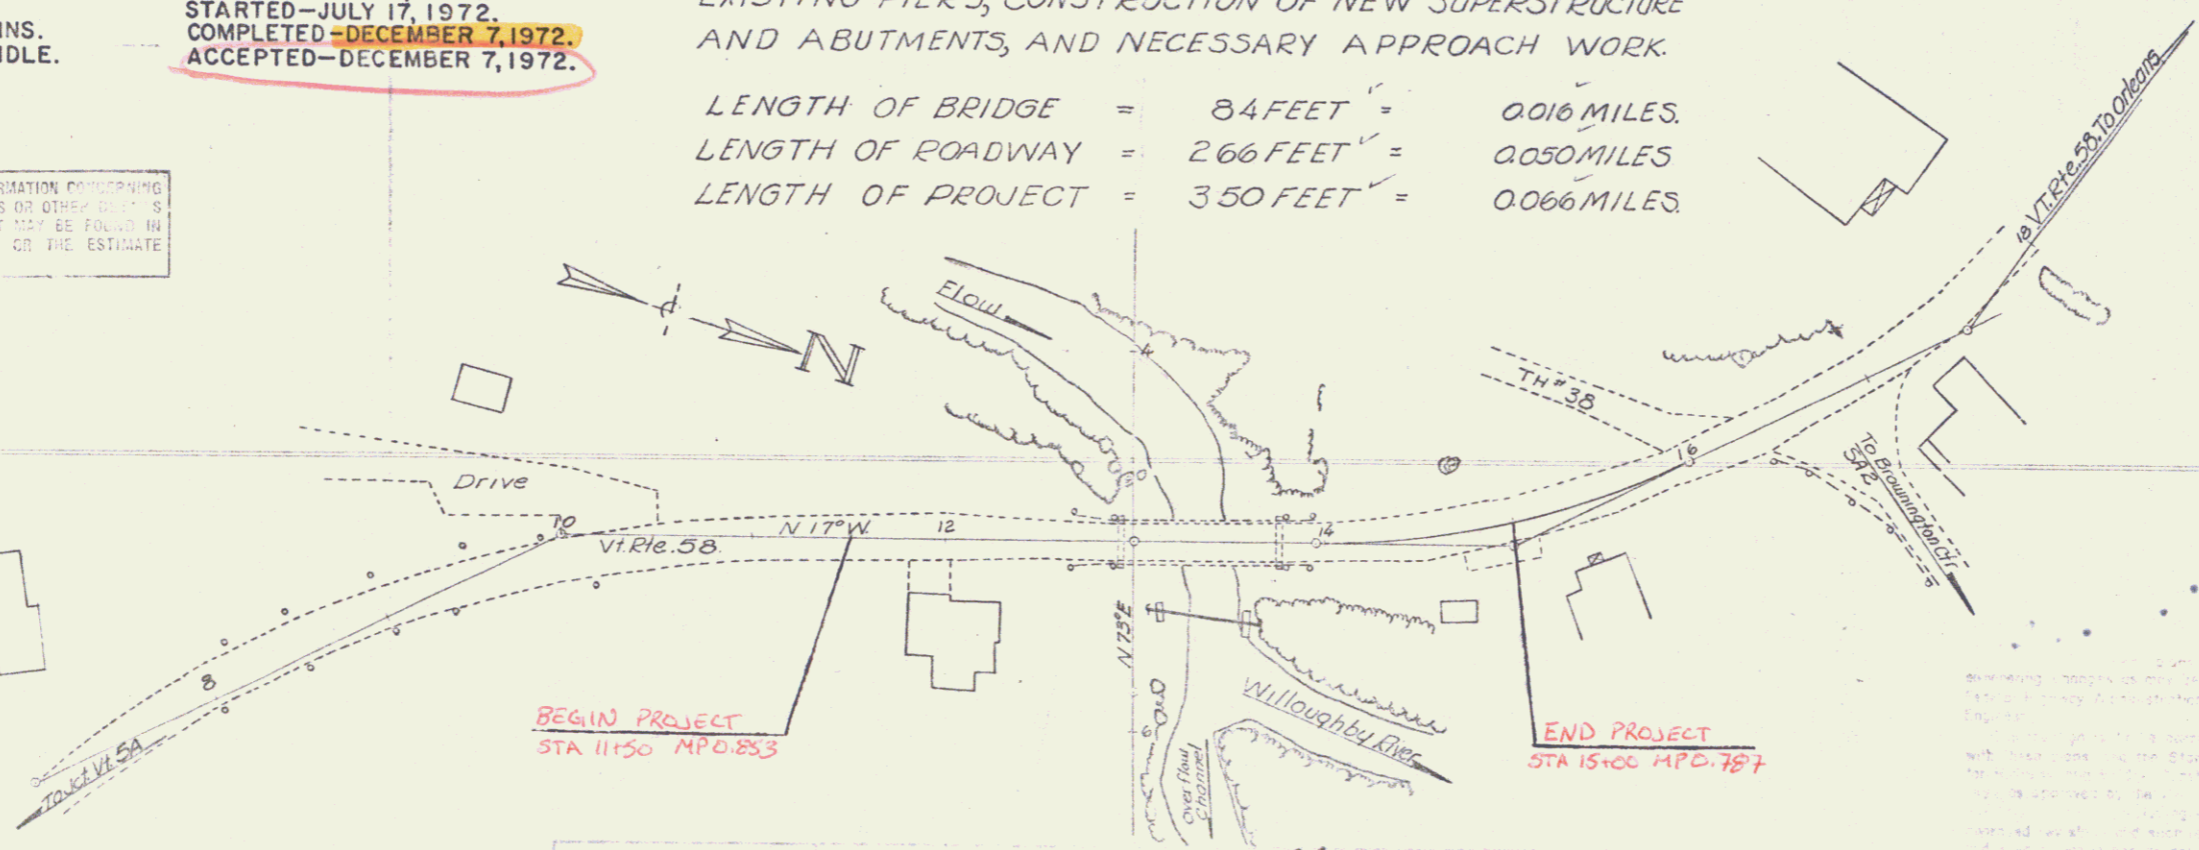

RECOMMENDED FOR APPROVAL
 DISTRICT ENGINEER 5-2-72

RECOMMENDED FOR APPROVAL
 CONSTRUCTION ENGINEER 5/17/72

RECOMMENDED FOR APPROVAL
 E.H. Stebbins 5/4/72

RECOMMENDED FOR APPROVAL
 BRIDGE 5/4/72

R.H. Arnold 5/4/72
 Pin # 00R 335
 Project BP 0310-7110
 SHEET 1