

INDEX OF SHEETS

SHEET NO. 1	TITLE PAGE
2	TYPICAL CROSS-SECTION OF IMPROVEMENT (DOUBLE TACK COAT OF REFINED TAR WITH PEASTONE SEAL, ITEM 312 A)
3	BANKING AND WIDENING TABLES
4	QUANTITY SHEET (ITEMS)
5	QUANTITY SHEET (DRAINAGE)
6-14	EARTHWORK SHEETS
15-24	PLAN AND PROFILE
25	STANDARD STRUCTURE SHEET S- 40 BARRICADES, SIGNS & LIGHTS
26	STANDARD STRUCTURE SHEET S- 41 ROUNDING OF SLOPES
27	STANDARD STRUCTURE SHEET S- 45-45 PLANK GUARD RAIL
28	STANDARD STRUCTURE SHEET S- 46-45 MARKERS
29	STANDARD STRUCTURE SHEET S- 47-45 PIPE CULVERTS
30	STANDARD STRUCTURE SHEET S- 48-46 THREE CABLE GUARD RAIL
31	STANDARD STRUCTURE SHEET SB-11 BARRICADES, SIGNS & LIGHTS (BRIDGE)
32-50	CROSS SECTIONS
51-56	CROSS SECTIONS (CHANNEL 50+00 RT. AND 50+97.7 LT. TO 53+00 LT.)

STATE OF VERMONT
STATE HIGHWAY DEPARTMENT

PLAN AND PROFILE OF PROPOSED
STATE HIGHWAY
FOREST HIGHWAY


TOWNS OF JAMAICA-WINHALL
COUNTIES OF WINDHAM AND BENNINGTON
VT. ROUTE 30

BRATTLEBORO-MANCHESTER ROAD

BEGINNING AT A POINT 3,930 FEET SOUTHEASTERLY FROM THE INTERSECTION OF VT. ROUTE 30 AND VT. ROUTE 8 AND EXTENDING NORTHWESTERLY 2.647 MILES.

FED. ROAD DIST. NO.	STATE	F.H. PROJ. NO.	FISCAL YEAR	SHEET NO.	TOTAL SHEETS
9	Vt.	7A		1	56


FOREST HIGHWAY

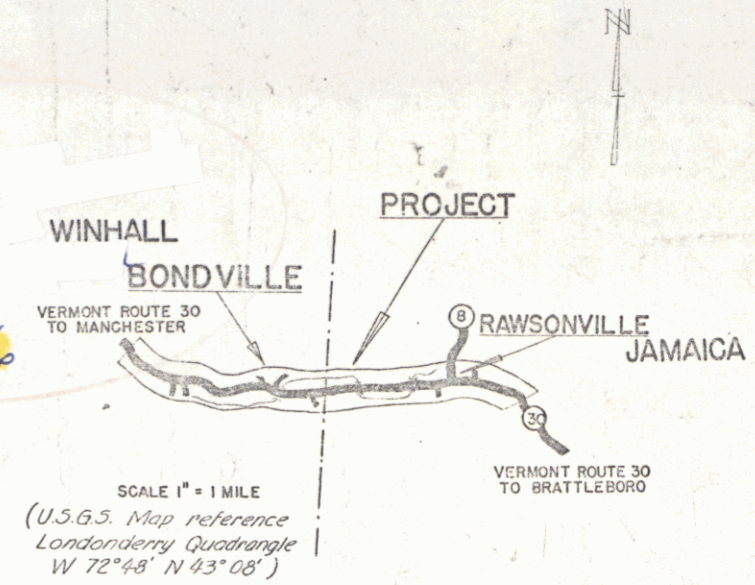

STANDARD STRUCTURE SHEETS APPROVED BY THE CHIEF ENGINEER, VERMONT DEPARTMENT OF HIGHWAYS.

S- 40	FEB 28, 1949
S- 41	DEC. 3, 1941
S- 45-45	OCT. 8, 1945
S- 46-45	FEB. 28, 1949
S- 47-45	FEB. 28, 1949
S- 48-46	MAY 13, 1946
SB- 11	DEC. 18, 1945

PROJECT NAME AND NUMBER	T-PE	PAVEMENT AREA
JAMAICA - WINHALL FH-7A	ONE TACK WITH PEASTONE SEAL	90,260 sq. Yd.
RECORDED PLANS		
MATERIALS		
CEMENT - Portland - Air-entraining Alpha, Atlas, Ironclad Natural - Rosendale Nat. Cement Co. Brattleboro Sand & Gravel Co. Brattleboro, Vt.	AGGREG - New Eng. Culvert Co. - Palmer, Mass. CO. PAIL - Bethlehem Steel Corp. CRUSHED STONE - Brattleboro Sand & Gravel Co. Northfield Washery Gravel Co. Northfield, Vt. SAND - Brattleboro Sand & Gravel Co. TAD - Barrell Co. - Worcester, Mass. STEEL POSTS - Bethlehem Steel Corp. RCP - Vt. Concrete Pipe Co. - Windsor, Vt. GRAVEL - Walker Pit - So. Londonderry Butler Pit - East Jamaica, Walker Pit - Rawsonville, DeKomper Pit - East Jamaica Roadley Pit - West Townsend, Vt.	
CONTRACTOR - George E. Dwyer RES. ENGR. - W.B. McMillister INSPECTORS - Wiley, Bontick, Osberry, Auzan RECORD PLANS BY - Murphy, Culegan	CONTRACT DATED - June 10, 1949 " STARTED - June 13, 1949 " COMPLETED - Dec. 12, 1950 " ACCEPTED - Dec. 12, 1950	

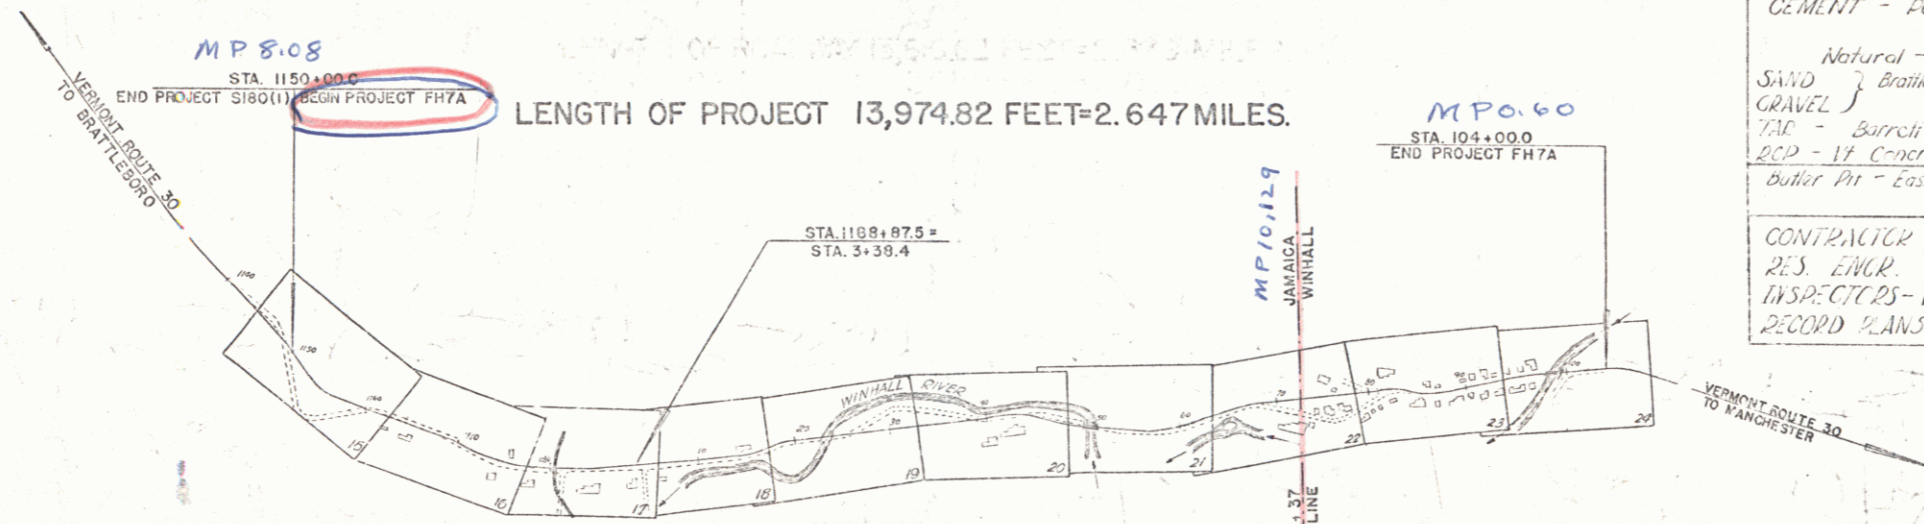

Jamaica 50

APPROVED April 1, 1949
H. W. Jenkins
HIGHWAY ENGINEER

APPROVED June 4, 1949
H. E. Laughey
DISTRICT HIGHWAY COMMISSIONER

SERIES FH NO. 7A FILED
SHEET 1 OF 56

CURVE DATA

DEFLECTION ANGLE	Δ
DEGREE OF CURVE	D
RADIUS OF CURVE	R
TANGENT DISTANCE	T
LENGTH OF CURVE	L
EXTERNAL DISTANCE	E
POINT OF INTERSECTION	P. I.
POINT OF CURVE	P. C.
POINT OF TANGENT	P. T.
POINT ON TANGENT	P. O. T.

SCALES

TITLE	1" = 1000'
TYPICAL	1" = 2'
PLAN	1" = 50'
HORIZONTAL	1" = 10'
PROFILE VERTICAL	1" = 10'
CROSS SECTIONS	1" = 3.810'

APPROVED: 6 Apr 49
H. E. Laughey
COMMISSIONER OF HIGHWAYS

SUBMITTED BY ORDER OF THE STATE HIGHWAY BOARD

RECOMMENDED FOR APPROVAL

THESE PLANS ARE SUBJECT TO SUCH REVISIONS AS MAY BE REQUIRED BY THE PUBLIC ROADS ADMINISTRATION OR THE COMMISSIONER OF HIGHWAYS.

CONSTRUCTION IS TO BE CARRIED ON IN ACCORDANCE WITH THE PLANS AND THE STANDARD ROAD AND BRIDGE SPECIFICATIONS OF 1948.

INCLUDING ALL SUBSEQUENT APPROVED REVISIONS AND SUCH REVISED SPECIFICATIONS AND SPECIAL PROVISIONS AS ARE SUBMITTED WITH THE PLANS.

STEARNS R. JENKINS
Rte. 30