


PARCEL	INSTRUMENT	DATE	GRANTED	RECORDED	BOOK	PAGE	DATE	REMARKS
#29B (S-180(1))	1.16 ACRES		Oxford Timber Corp.	JAMAICA	32	392	6-22-49	#29A & 29 B on S 180(1)
#29C #1C	0.25 ACRES	6-17-49	Oxford Timber Corp.	JAMAICA	32	376	6-18-49	#2 Bort. Street 76
#2A #B		6-10-49	Lawrence H. & Marguerite C. Slason	JAMAICA	32	380	6-18-49	
#3A		6-10-49	Carroll A. & Reba E. Bridgman	JAMAICA	32	380	6-18-49	

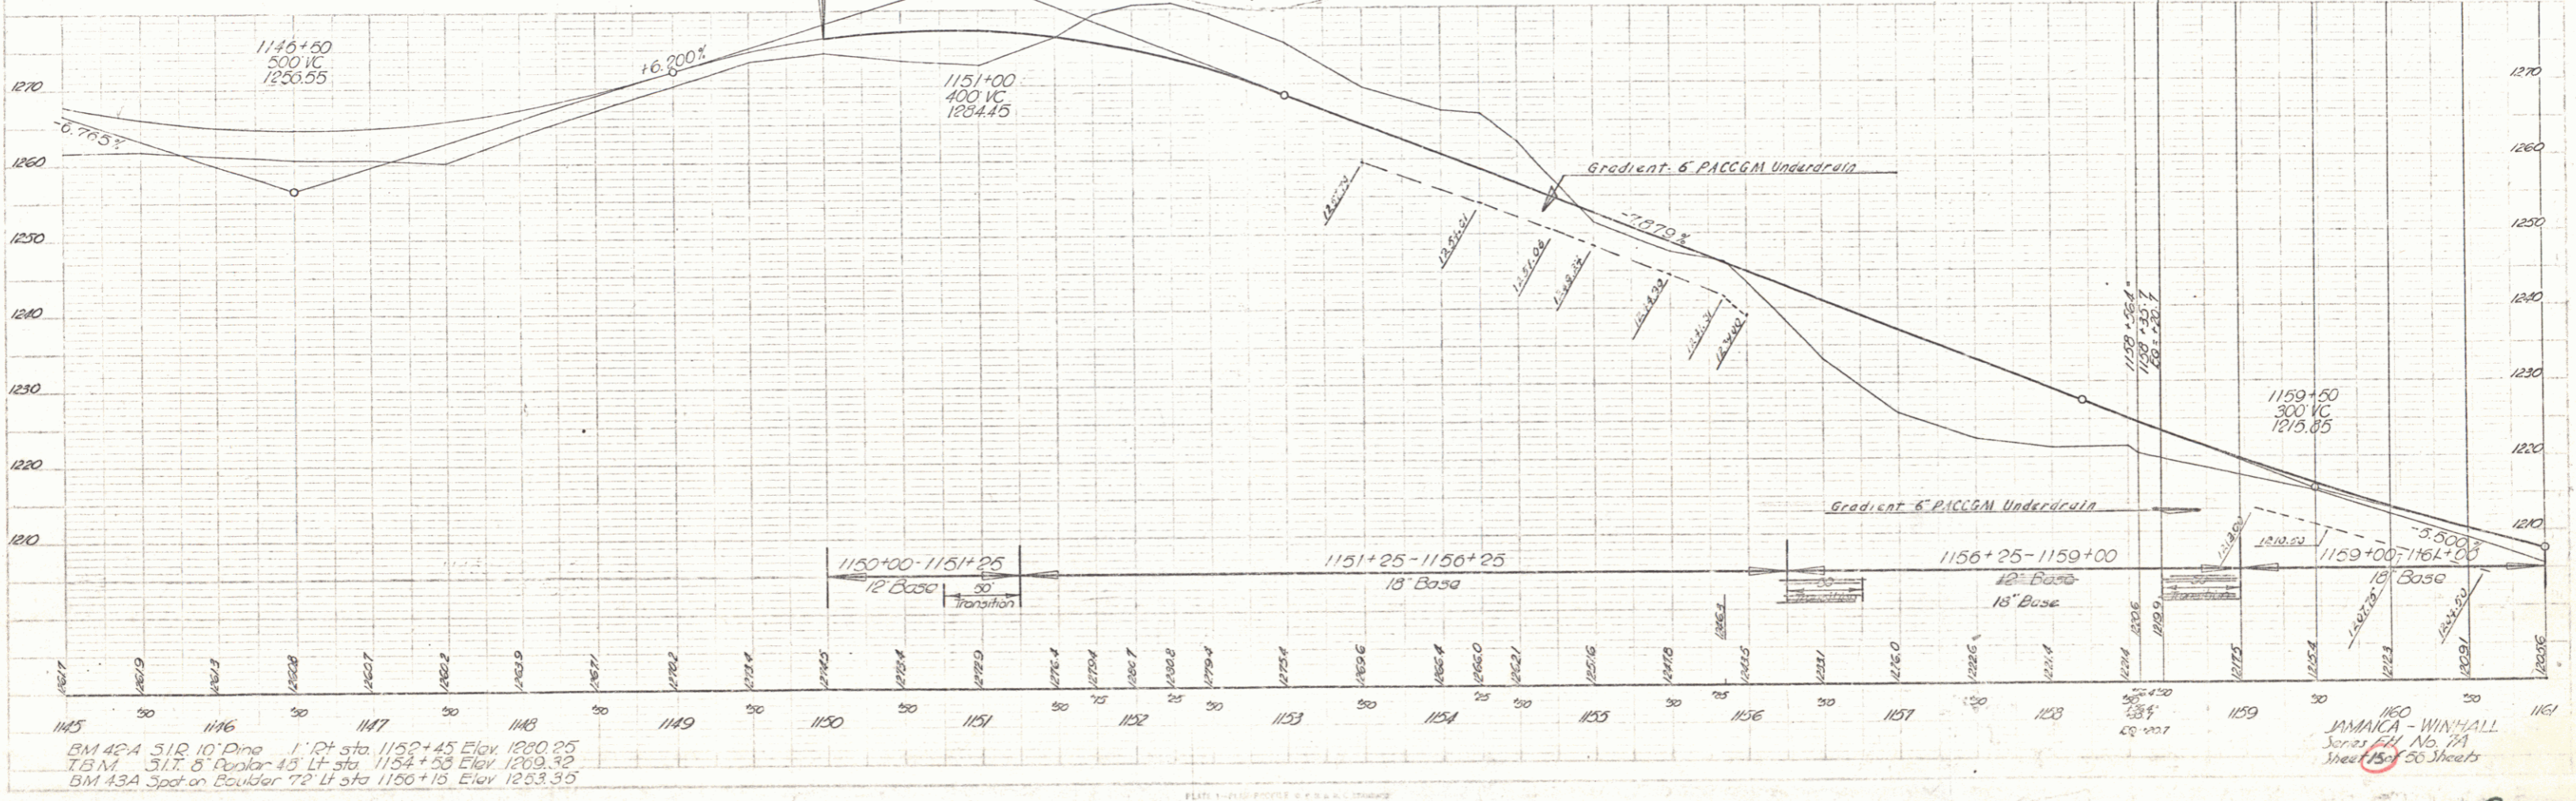

BM 42A 510.10' Dmg 1" Dt sta 1152+45 Elev 1220.25
TBM 311.8' Rod 45 Lt sta 1152+55 Elev 1209.32
BM 43A Spd on Boulder 72 Lt sta 1160+15 Elev 1253.35

WOOD GUIDE POST	STA	POS	LF
	1152+36	1	1
	1155+00	1	1
	1155+58	1	1
	1160+36	1	1
	1160+92	1	1

CONSTRUCTED APPROACHES
1152+30 Rt

Equation = +20.7'

THREE CABLE GUARD RAIL WITH ST POSTS
STA 1155+90 1162+40 Rt 630'

AS-METHOD
RECORDED
DATE

AS-METHOD
RECORDED
DATE