


PARCEL #5A W.D.O.E. 6-10-49
 #6A W.D.O.E. 6-20-49
 GRANTOR EDGAR A. & MILDRED E. LANDMAN LOREN W. & ELIZABETH A. COLEMAN
 GRANTEE ST. OF VT. ST. OF VT.
 RECORDED JAMAICA JAMAICA
 BOOK 32 3E
 PAGE 374 399
 DATE 6-18-49 6-30-49
 REMARKS-

WOOD GUIDE POSTS		PLANK GUARD RAIL				CONSTRUCTED DRIVES	
STA	LT RT	STA	RTS	LT	RT	LT	RT
1187.75	4	1180+19	1180+67	RT	43	1180+00	1183+00
1187.77	1	1180+19	1180+67	LT	46	1180+70	1186+70
						1188+00	1189+00

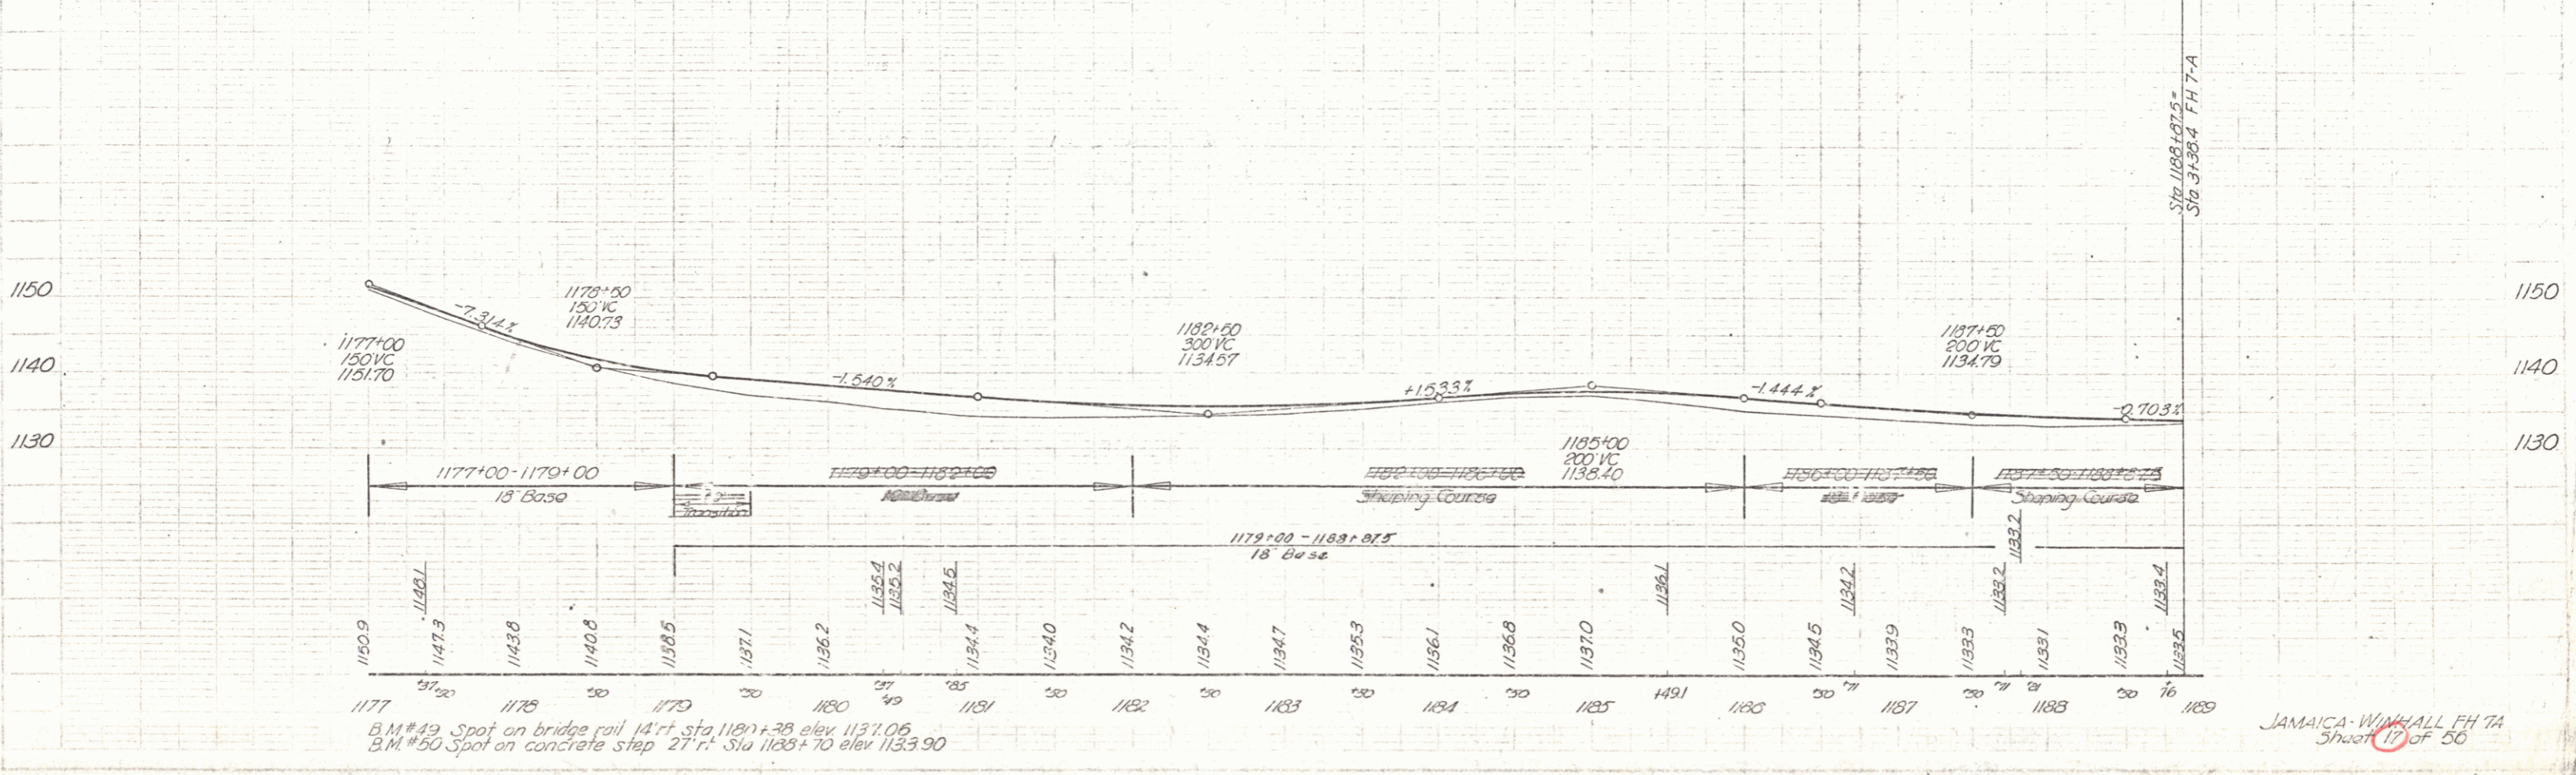

B.M. #49 Spot on bridge rail 14'± Sta 1180+38 elev 1137.06
 B.M. #50 Spot on concrete step 27'± Sta 1183+70 elev 1133.90