

Note: Bench data based on U.S.G.S. B.M. #RLB-3 on Vermont Bridge No. 2391 over Winhall River in Rawsonville. Elev. B.M. #RLB-3 - 1136.30. Bearings are true bearings determined from solar observations. The coordinate system is based on coordinates N 15000 - E 15000 assumed for Sta. 0+00 of the preliminary survey line.


Note: Power line owned by Central Vermont Public Service Corp. & Halifax Electric Co. Telephone line by New England Telephone & Telegraph Co.

PARCEL #7	# 8A 30 B
INSTRUMENT	W.D.O.E.
DATE	6-13-49
GRANTOR	DORR BETTY LYMAN ALMA WELKER
GRANTEE	ST. OF VT. ST. OF VT.
RECORDED BOOK	JAMAICA
PAGE	32
DATE	6-18-49
REMARKS	CULVERT - STA. 1135 - 1138 ON SHEET 19

CONSTRUCTED DRIVES		
Lt	Rt	
4+10	4+10	
11+43	5+22	
12+50		

W.C.C.D. GUIDE POSTS		
STA	Lt	Rt
4+35	1	1
9+00	1	1
11+96	3	
13+17	1	
11+46	1	

THREE CABLE GUARD RAIL WITH ST. POSTS		
STA	STA	POS
11+58	13+08	Rt 650'

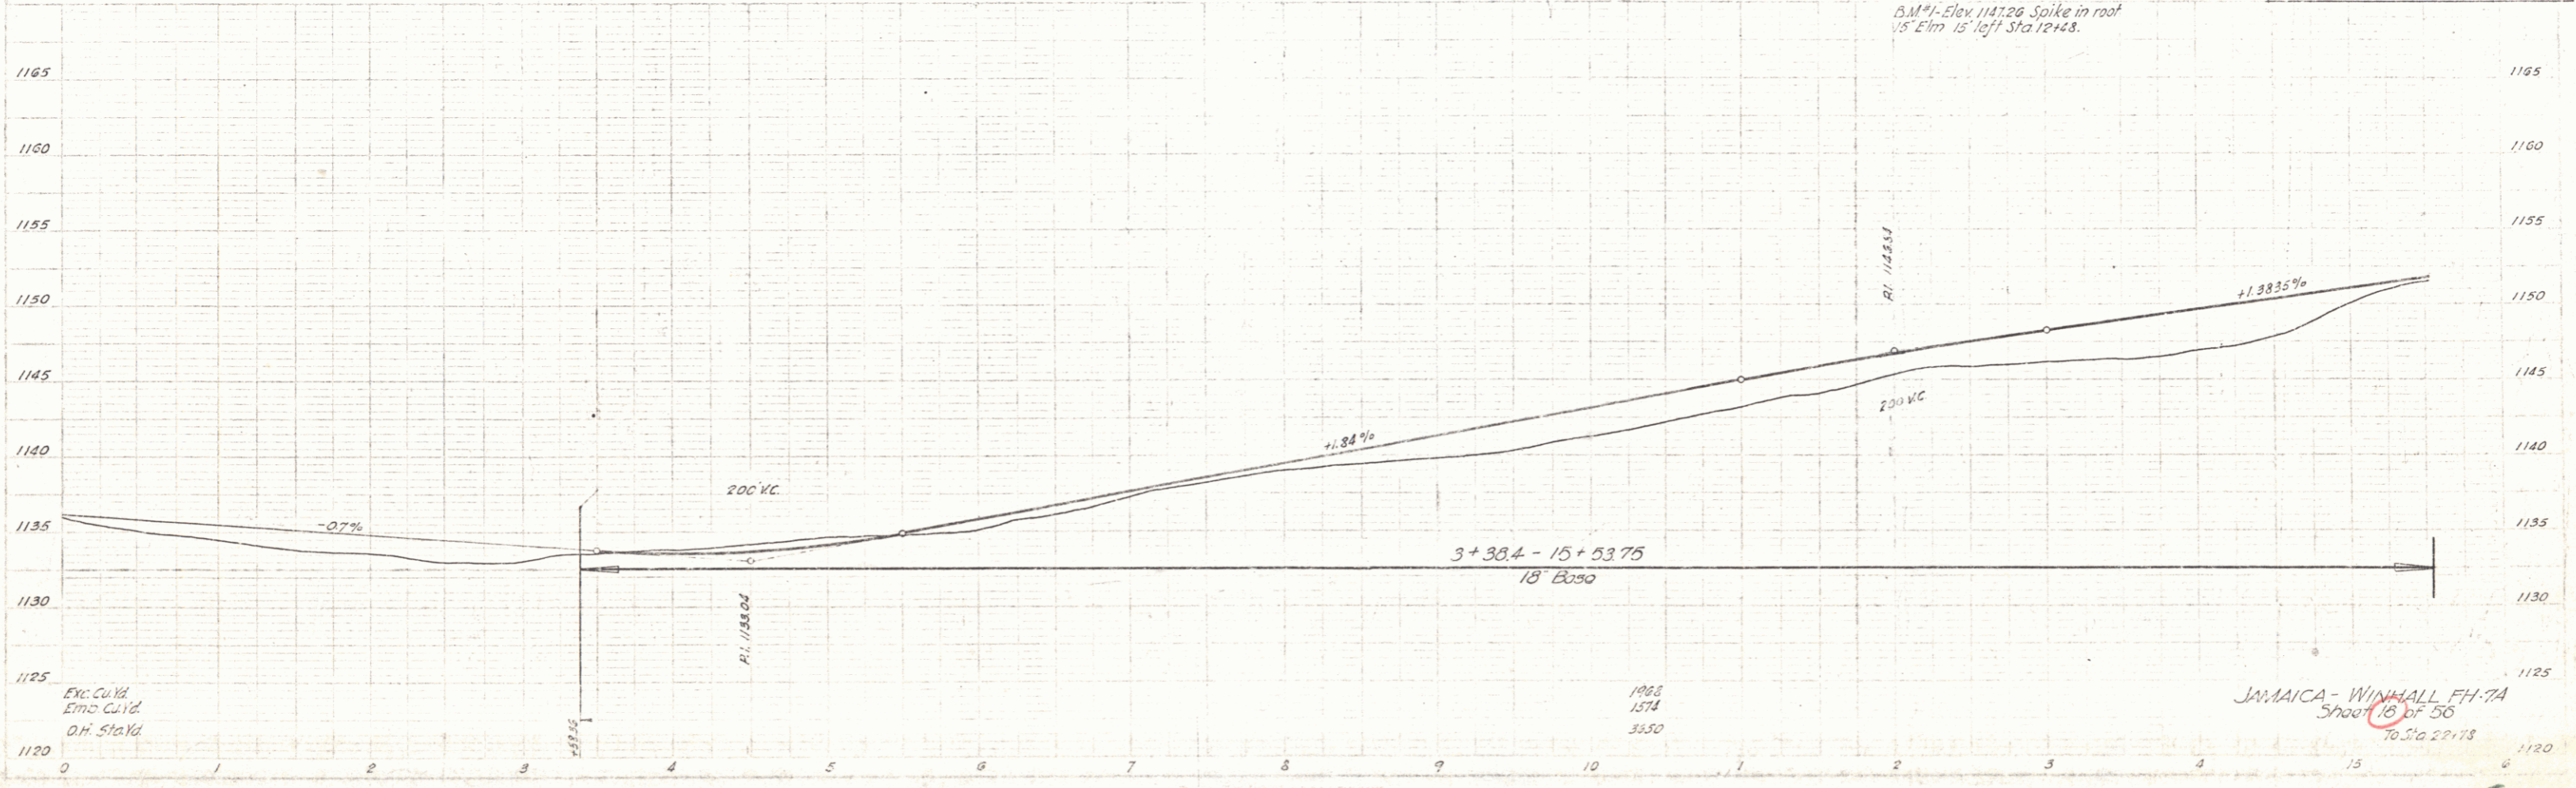

Exc. C.U.V.
Emo. C.U.V.
O.H. Stake

1968
1574
3050

JAMAICA - WINHALL FH-7A
Sheet 18 of 56
10 Sta 22178