


PARCEL #	#9	#10A
INSTRUMENT	M.D.O.E.	M.D.O.E.
DATE	6-10-49	6-10-49
GRANTOR	OSCAR F. & RUBY E. CRANDALL	JOHN S. & BLANCHE DOWNS
GRANTEE	ST. OF VT.	ST. OF VT.
RECORDED BOOK	JAMAICA 32	JAMAICA 32
PAGE	385	387
DATE	6-10-49	6-10-49
REMARKS	SUBDIVISION	SUBDIVISION


CONSTRUCTED DAVES	
Lt	Rt
17+25	26+50
20+50	

W.C.D. GUIDE POSTS	
STA	Lt Rt
15+64	1 1
16+70	1 1
23+03	1 1
25+76	1 1
27+60	1 1
29+00	1 3

TRIPLE CURVE GUARD RAIL WITH SL POSTS			
STA	STA	PC	LT
23+11	24+23	Rt	116'
24+03	25+35	Lt	32'
25+05	25+37	Rt	32'
25+20	25+60	Lt	48'

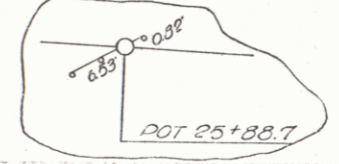

CONTROL OF SECTION OF OLD HIGHWAY BETWEEN STATION 26+30+0 AND STATION 30+90+0, RELINQUISHED TO TOWN OF JAMAICA. RECORDED BOOK 4, PAGE 186, DATE JAN. 10, 1951

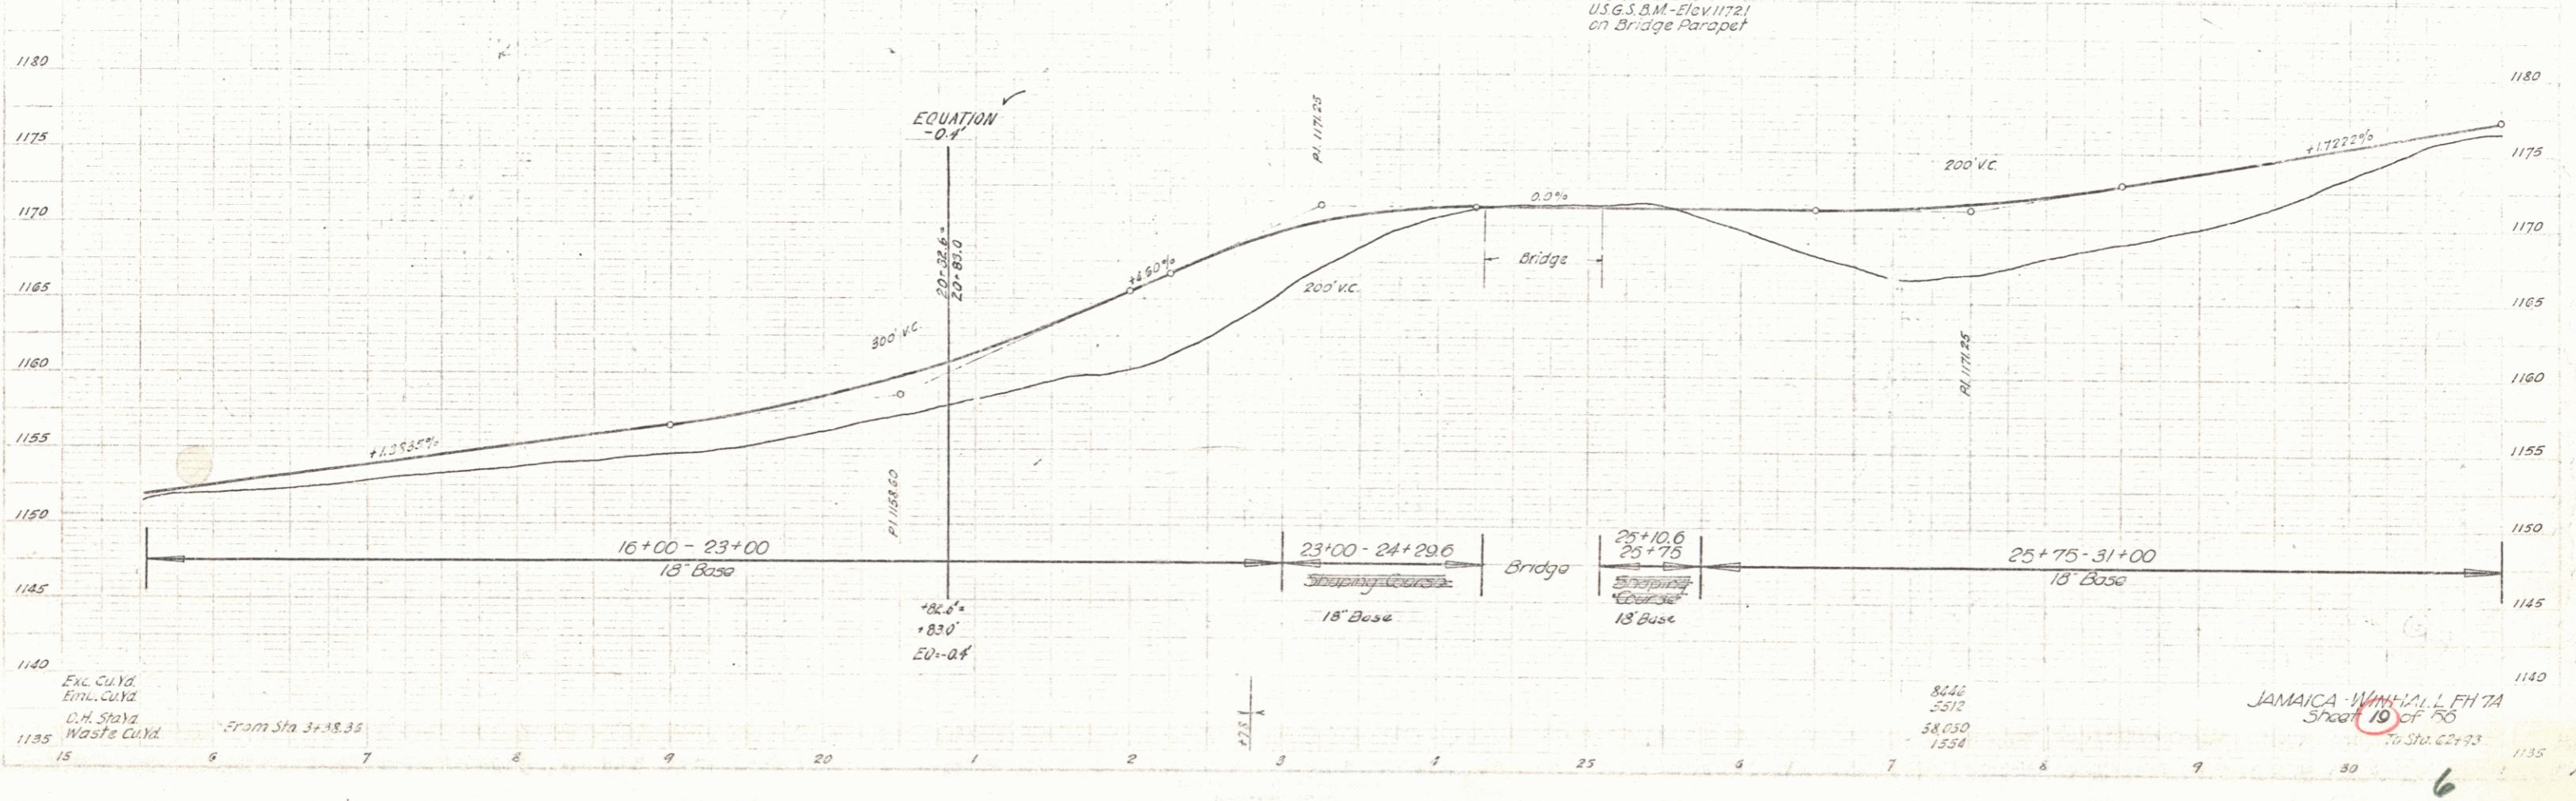

Exc. Curb
 Emul. Curb
 C.H. Stone
 Waste Curb

JAMAICA-WINHALL, L.F.H. 7A
 Sheet 10 of 56
 To Sta. 62+73