

PARCEL	#12 A	#13 A	#14 A	#15 A	#12 B
INSTRUMENT	W.D.O.E.	W.D.O.E.	W.D.O.E.	W.D.O.E.	W.D.O.E.
DATE	12-27-48	12-27-49	12-27-48	12-27-48	7-24-53
GRANTOR	E. F. GORDON	FRED W. & NORMA S. CATTANCH	LYLE K. & LAURA M. ROBBINS	CHESTER R. HENSHAW	RICHARD S. & MINERVA T. HAIER
GRANTEE	ST. OF VT.	ST. OF VT.	ST. OF VT.	ST. OF VT.	ST. OF VT.
RECORDED BOOK	JAMAICA 32	JAMAICA 32	JAMAICA 32	WINHALL 16	JAMAICA 33
PAGE	328	329	326	269	217
DATE	2-4-49	2-11-49	2-4-49	2-4-49	9-9-53
REMARKS:					


CONSTRUCTED APPROACH	
LT	67+25
RT	67+25

WCCD GUIDE POSTS		
S/A	Lt	Rt
69+00	74+25	25
69+20		
66+05		
61+00		
74+25		

THREE CABLE GUARD RAIL WITH STEEL POSTS			
S/A	S/A	Rt	Lt
62+03	66+03	Rt	40'

Control of section of highway between station 68+53 Rt and station 70+60 Rt relinquished to town of Jamaica. Recorded book 4, page 186, date January 10, 1957.

Control of section of highway between station 72+31 Rt and station 80+60 Rt relinquished to town of Winhall. Recorded book 17, page 16, date January 11, 1957.

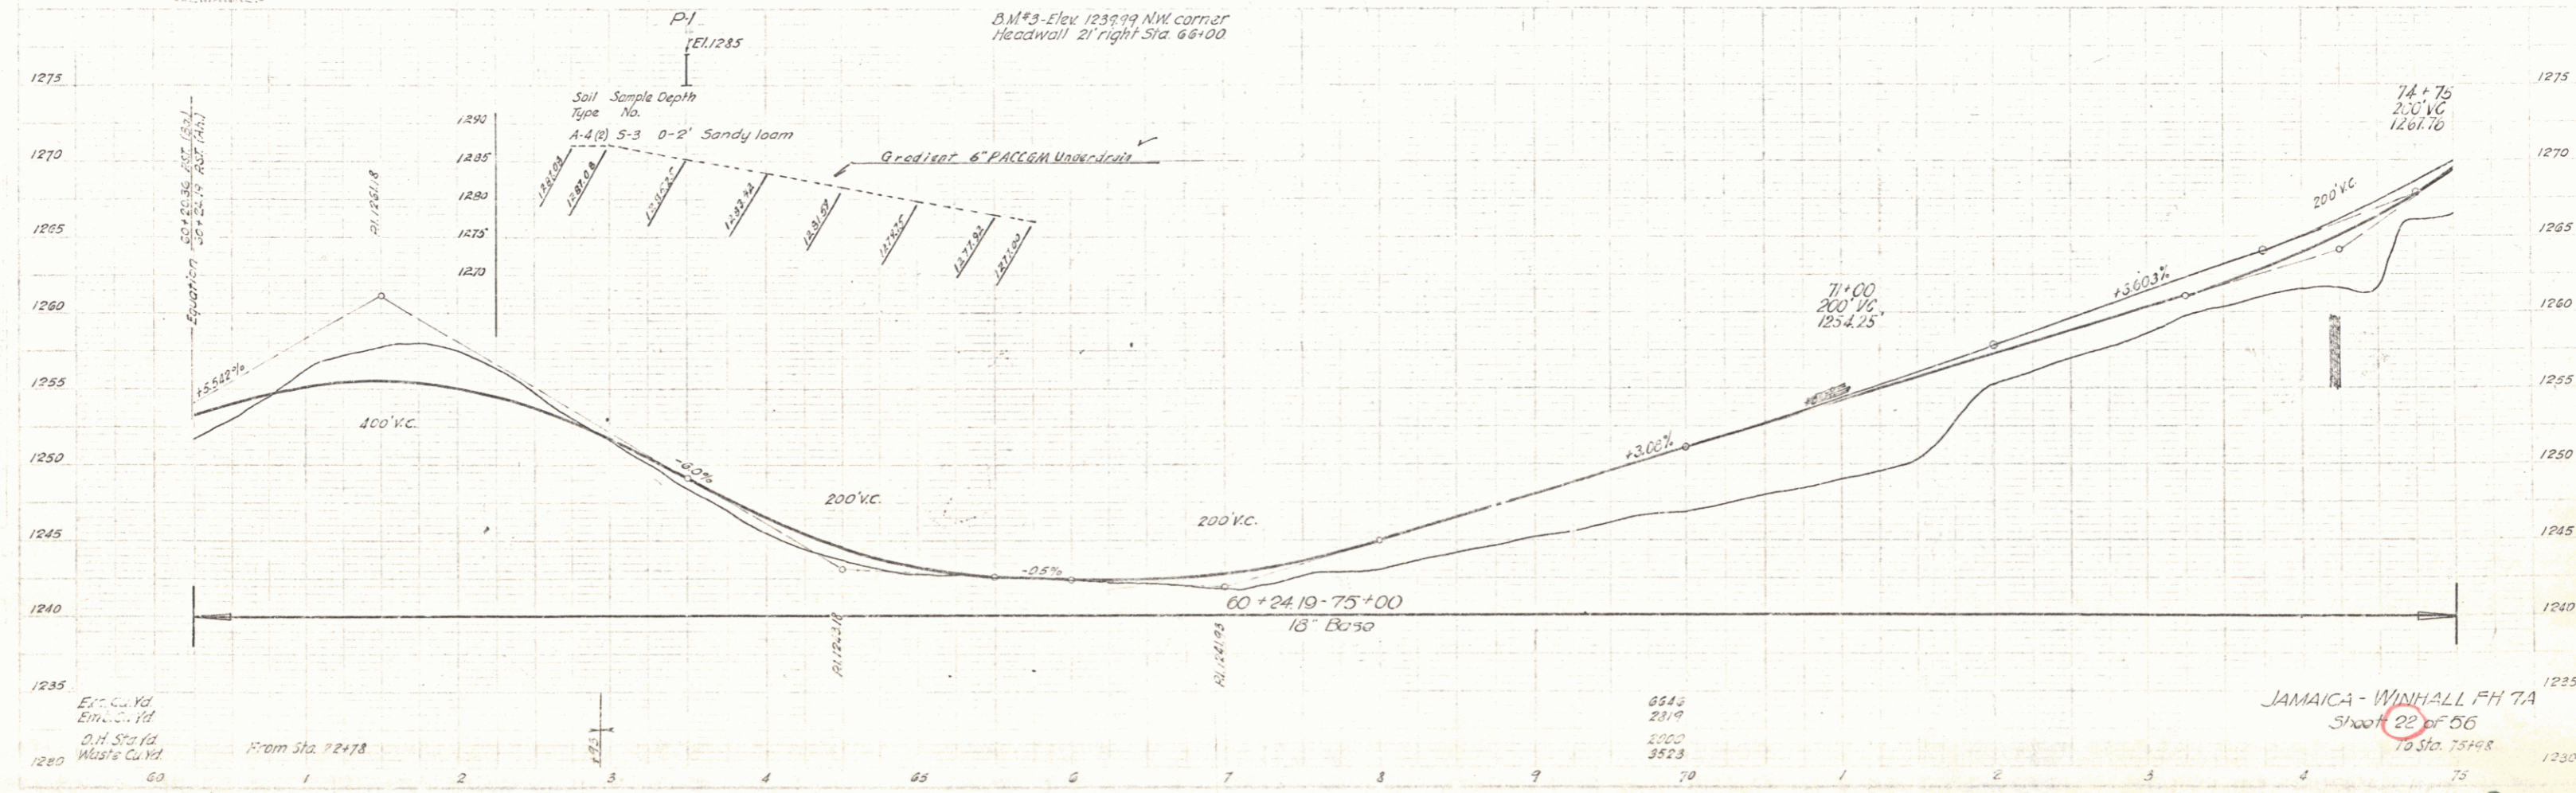

Elev. Cur. Yd.
Elev. Cur. Yd.
C.H. Sp. Yd.
Waste Cur. Yd.

JAMAICA - WINHALL FH 7A
Sheet 22 of 56
To Sta. 75+00