


POOR ORIGINAL COPY

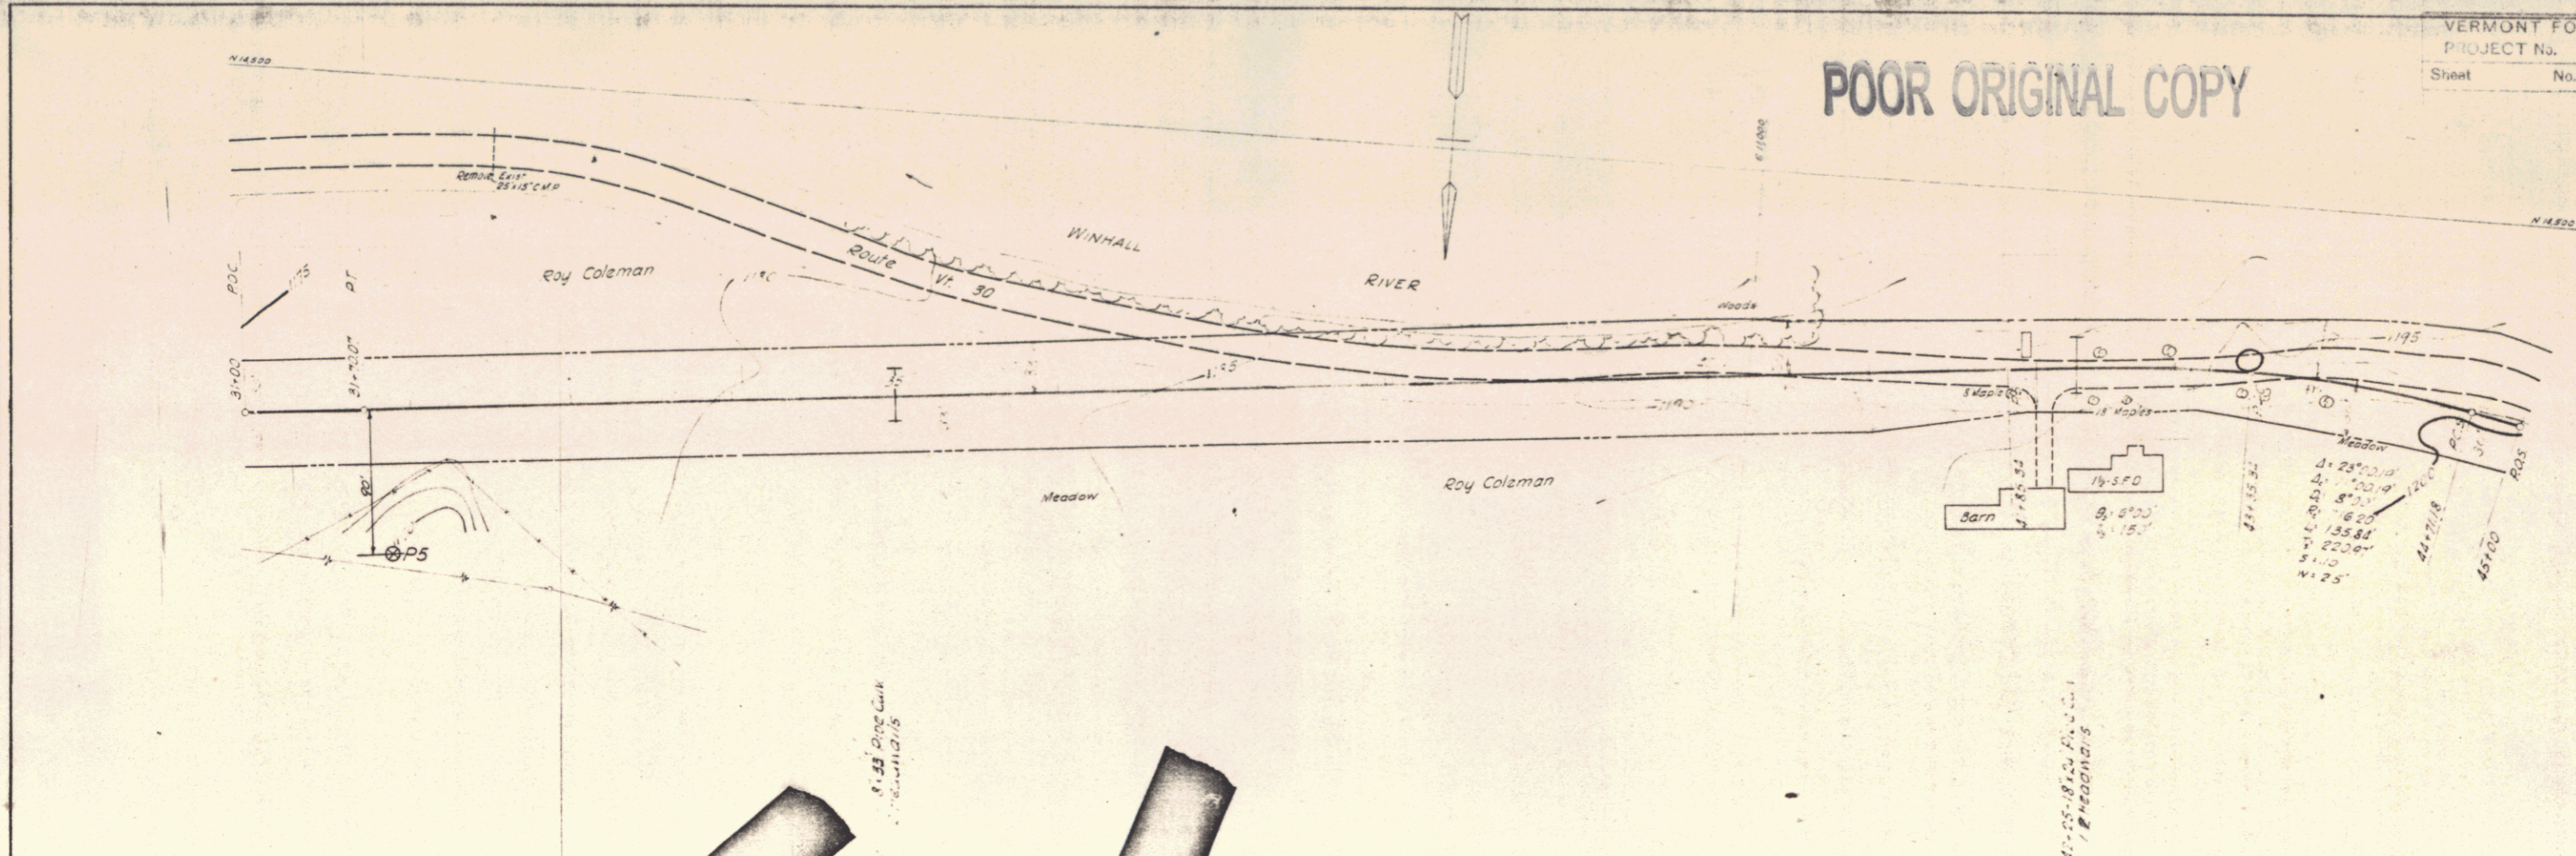

DATE	
BY	
PROJECT	
PROFILE	
NOTE BOOK	
NO.	

DATE	
BY	
PROJECT	
PROFILE	
NOTE BOOK	
NO.	

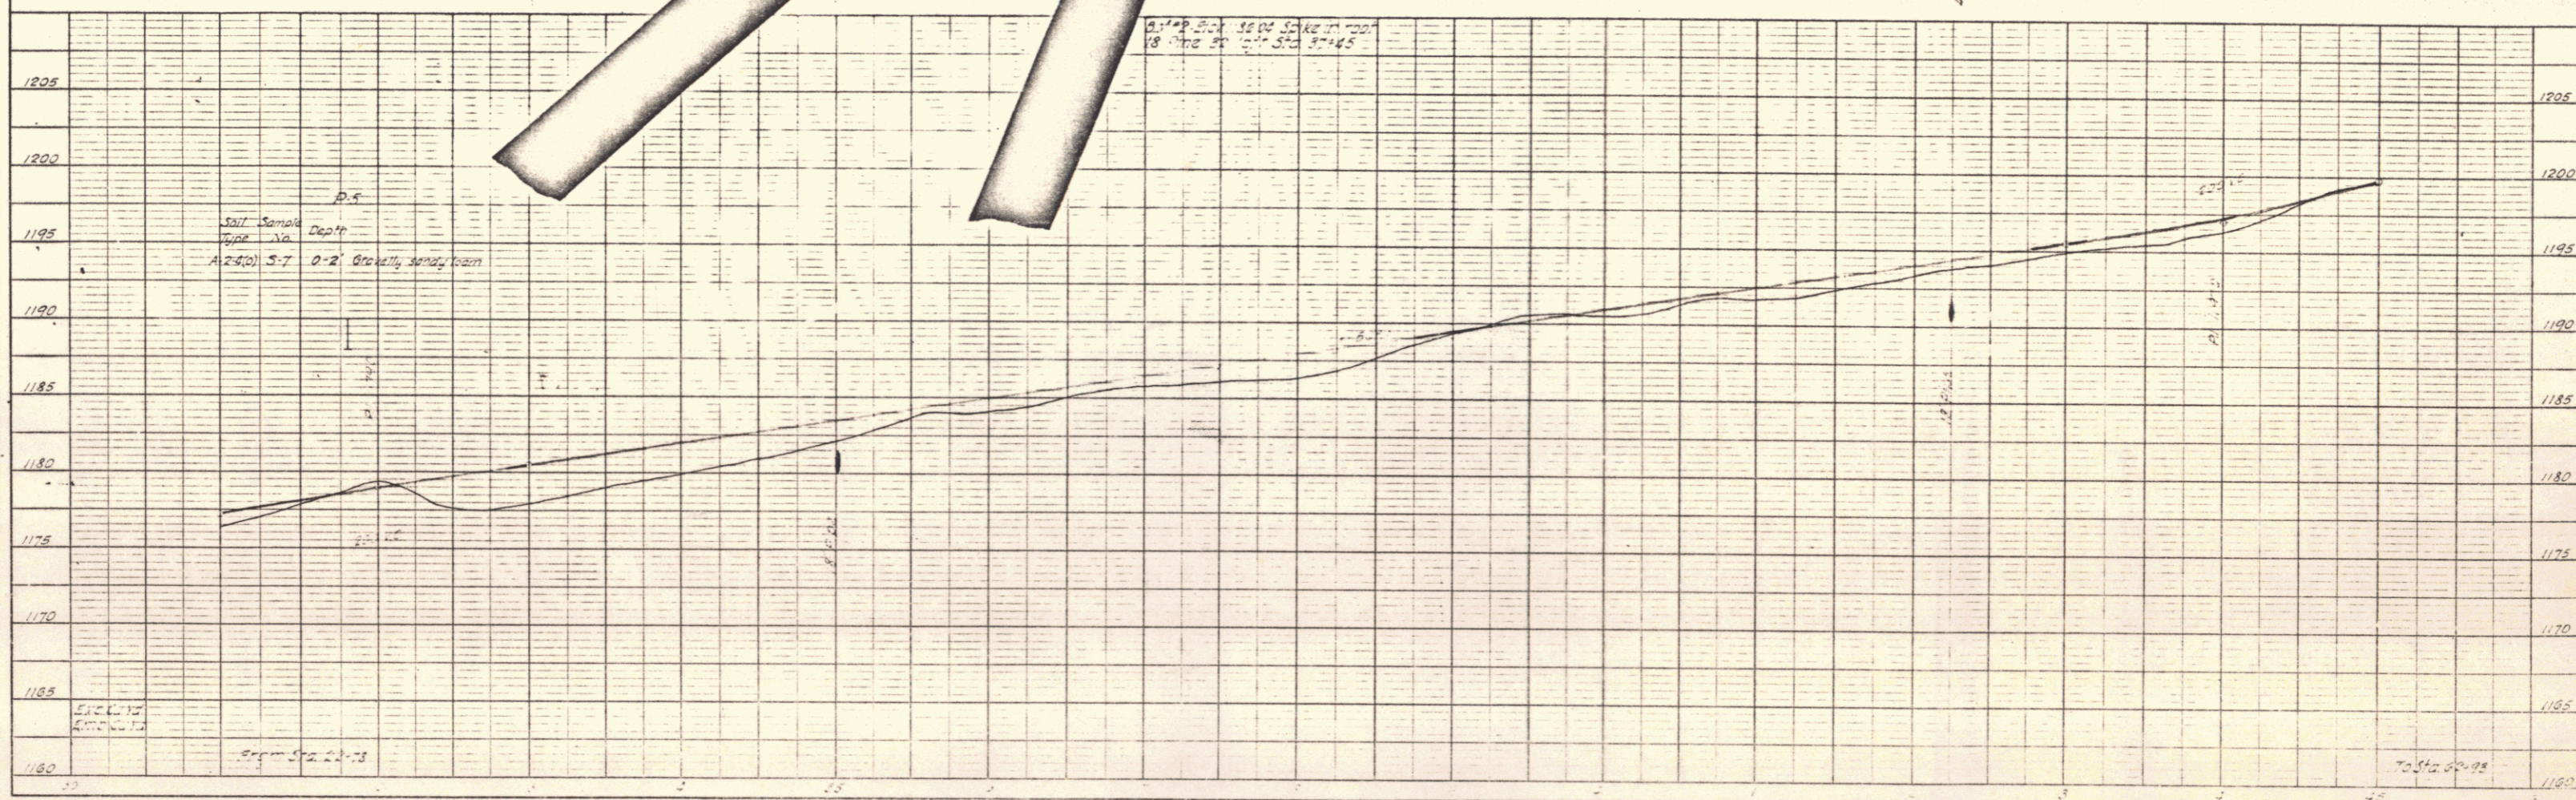


PLATE 1-PLAN-PROFILE OF ROAD STANDARD
 KEUFFEL & ESSER CO., NEW YORK