


POOK ORIGINAL 99FT

PLAN

DATE	
BY	
REVISIONS	
APPROVED	
DATE	
BY	
NOTE BOOK	
NO.	
DATE	
BY	
REVISIONS	
APPROVED	
DATE	
BY	
NOTE BOOK	
NO.	
DATE	
BY	
REVISIONS	
APPROVED	
DATE	
BY	

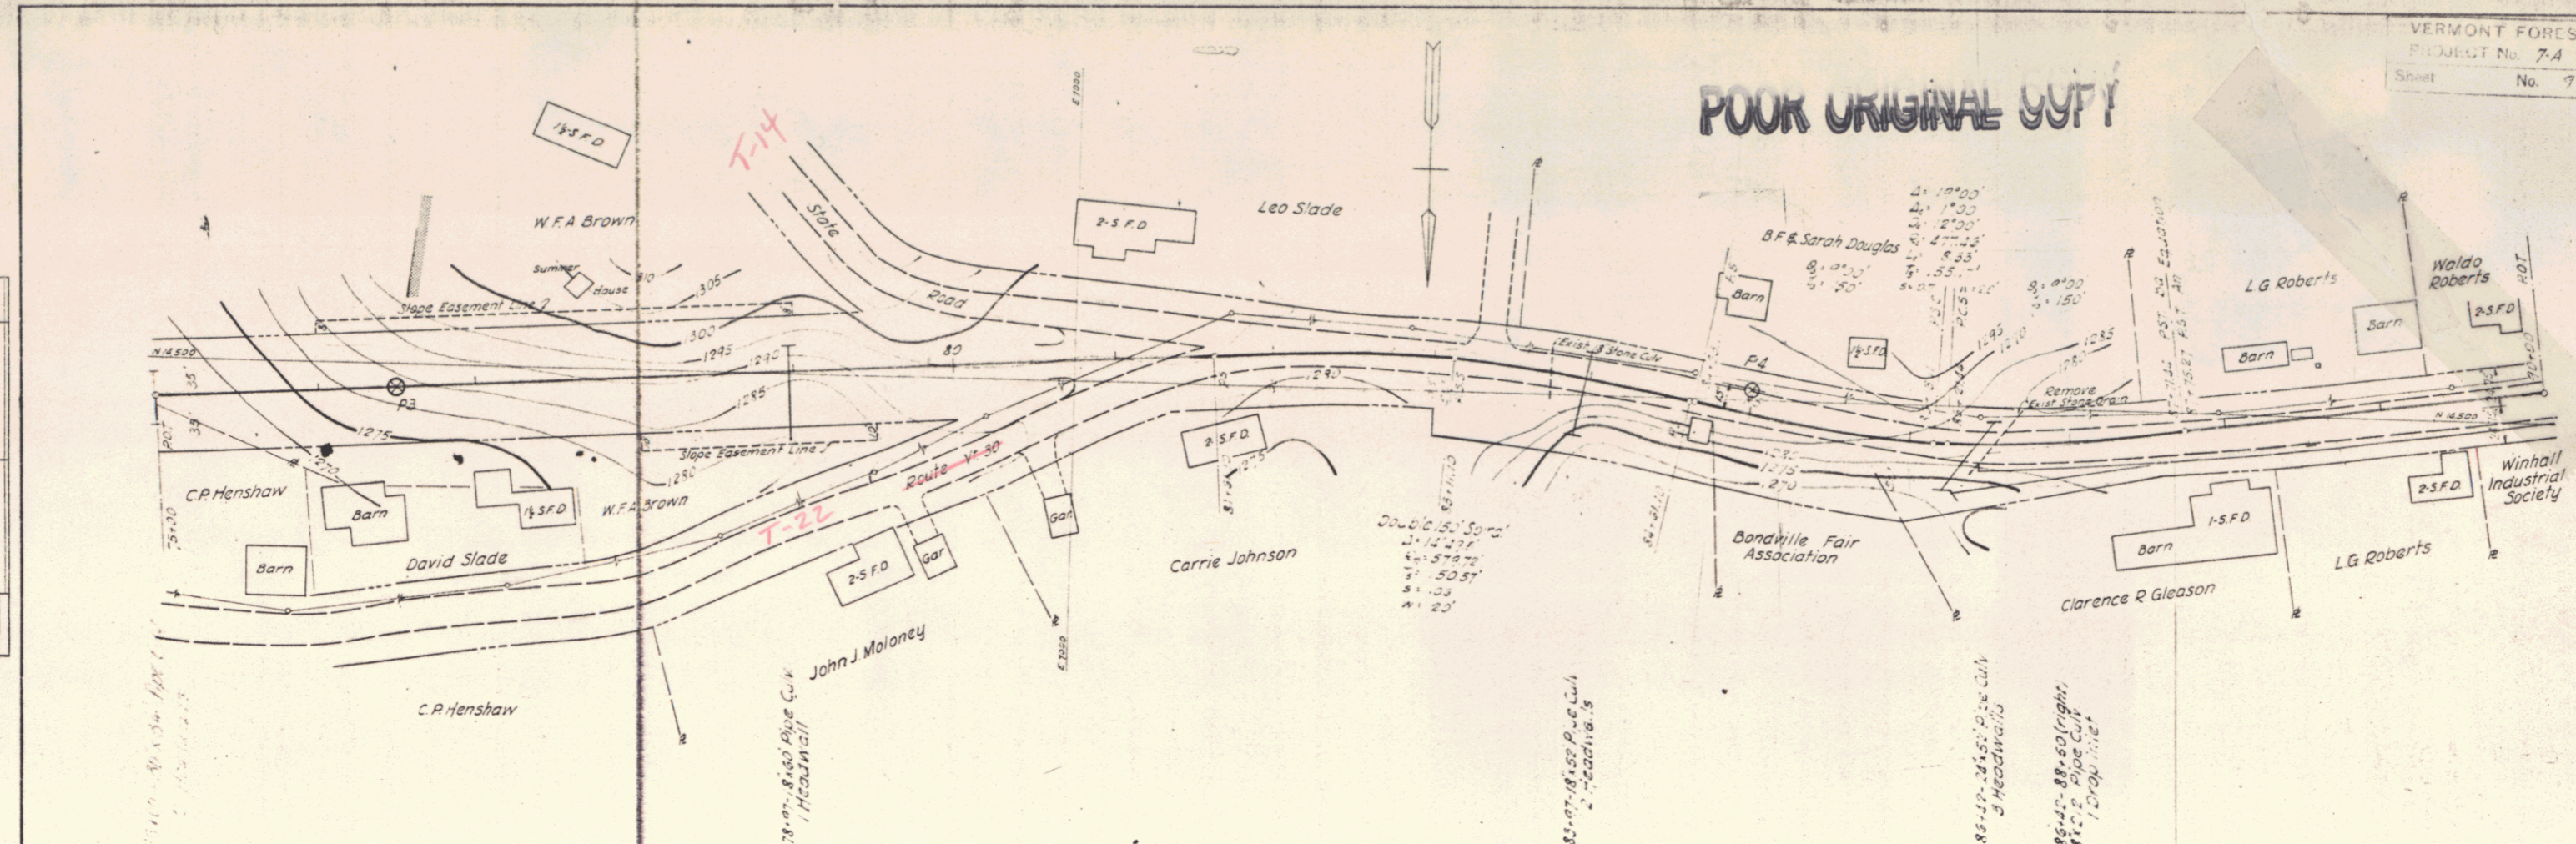

PROFILE

DATE	
BY	
REVISIONS	
APPROVED	
DATE	
BY	
NOTE BOOK	
NO.	
DATE	
BY	
REVISIONS	
APPROVED	
DATE	
BY	

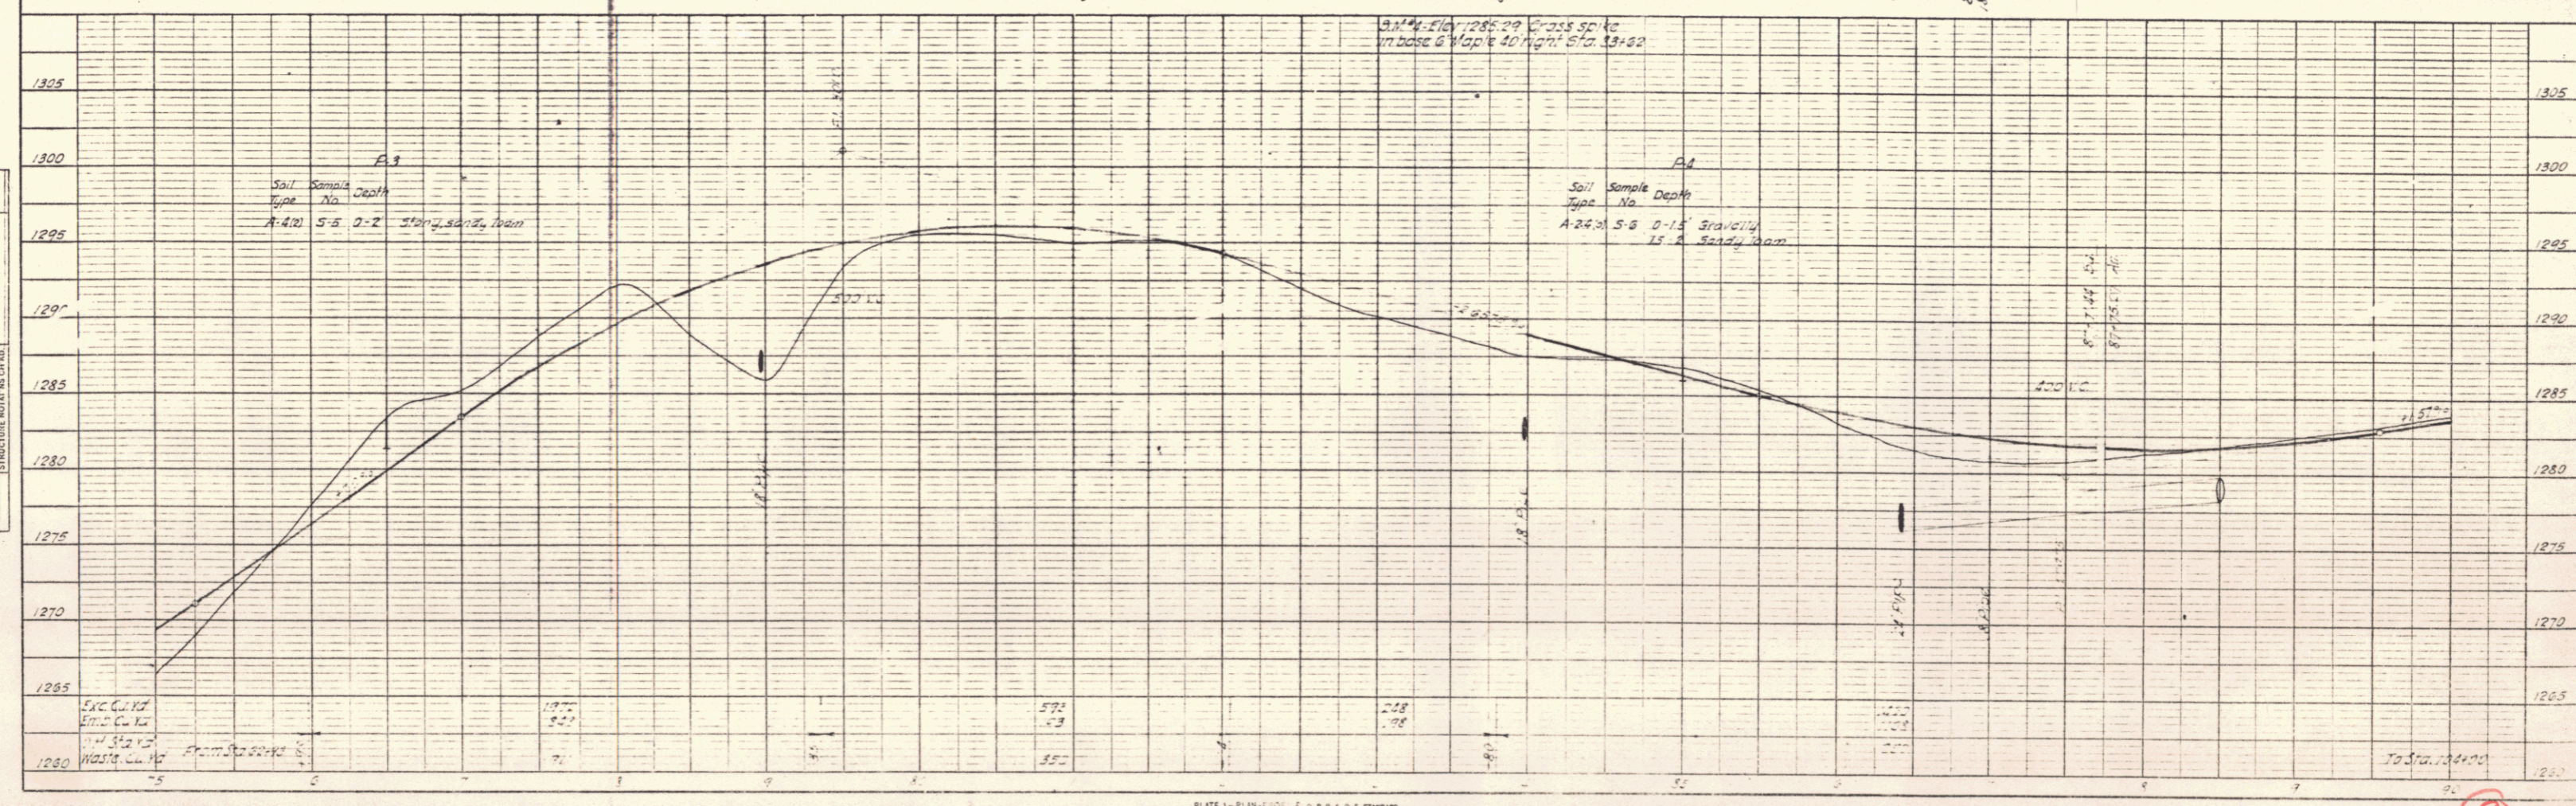


PLATE 11 - PLAN & PROFILE OF POK ORIGINAL 99 FT HIGHWAY