


POOR ORIGINAL COPY

VERMONT FOREST HIGHWAY
PROJECT No. 7-4
Sheet No. 10 of 20

PLAN
DATE
BY
CHECKED
DATE
NO.

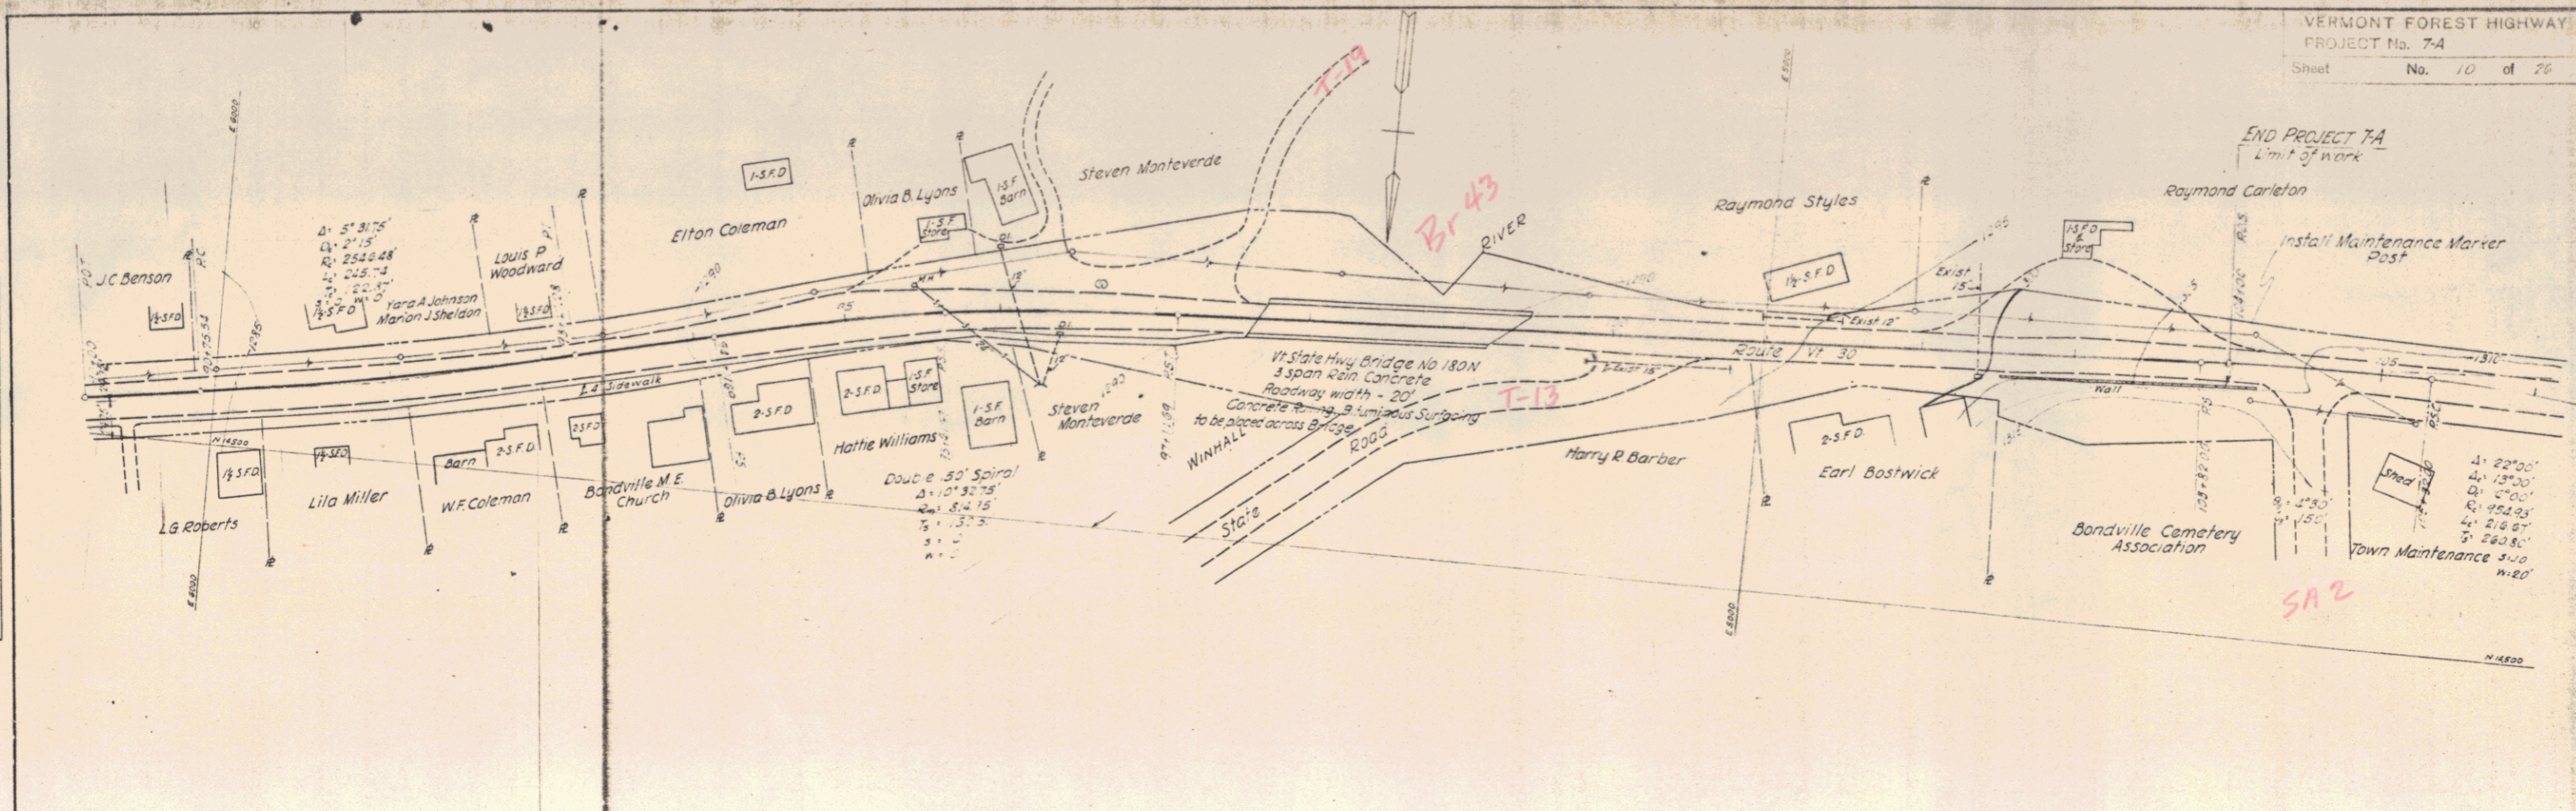

PROFILE
DATE
BY
CHECKED
DATE
NO.

