

INDEX OF SHEETS

SHEET NO. 1 TITLE PAGE
 2 TYPICAL CROSS-SECTION OF IMPROVEMENT Grading, Base, Drains & Guard Rail with Double Top Coat of Refined Tar
 3 BANKING AND WIDENING TABLES
 4 PLAN AND PROFILE
 16 Superstructure Details - 51B26-15'Skew
 17 Details of Abutments
 18 Curb Rolling SB-52
 19 Barricades, Signs & Lights SB-11
 20 SB-20 - Details C.E.K.L. & General Notes
 21 320 Standard Structure Sheet (Pipe Culverts)
 22 329 (Box Culverts)
 23 Detail 3'x3' Box Culvert @ Sta 689+05
 24 4'x4' 793+08
 25 330 Standard Structure Sheet (Guard Rail)
 26 531 (Boundary Markers)
 27 340 (Rounding of Slopes)
 28 341 Barricades, Signs, Lights etc
 29-101 Cross Sections

STATE OF VERMONT
 STATE HIGHWAY DEPARTMENT

PLAN AND PROFILE OF PROPOSED
 STATE HIGHWAY

FEDERAL AID PROJECT

TOWNS OF TOWNSHEND & JAMAICA

JAMAICA - TOWNSHEND ROAD


BEGINNING AT A POINT 4399 FT. N. EASTERLY
 FROM THE JAMAICA TOWNSHEND TOWN LINE &
 EXTENDING 2.759 MI. N. WESTERLY TO THE
 BRIDGE ACROSS THE WEST RIVER.

LENGTH OF ROADWAY 14485.6 FEET = 2.743 MILES


LENGTH OF BRIDGE 84.0 FEET = 0.016 MILES

TOTAL LENGTH OF PROJECT 14569.6 FT. = 2.759 MILES

STANDARD STRUCTURE SHEETS APPROVED
 BY THE CHIEF ENGINEER
 528 4529 JULY 11, 1933
 530 AUGUST 15, 1934
 531 JULY 24, 1934

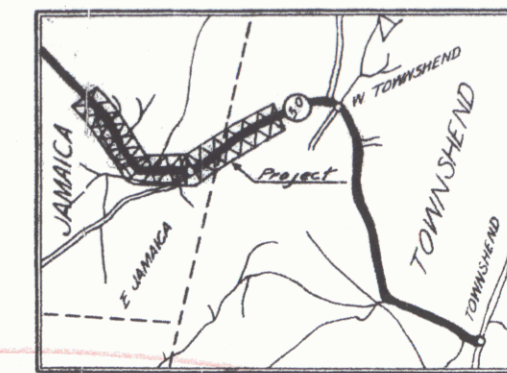

Project 1594M
 Route VT 30
 Begin Town: Townshend Ending Town: Jamaica
 Pin: 00R 337
 Date: 12/29/1937

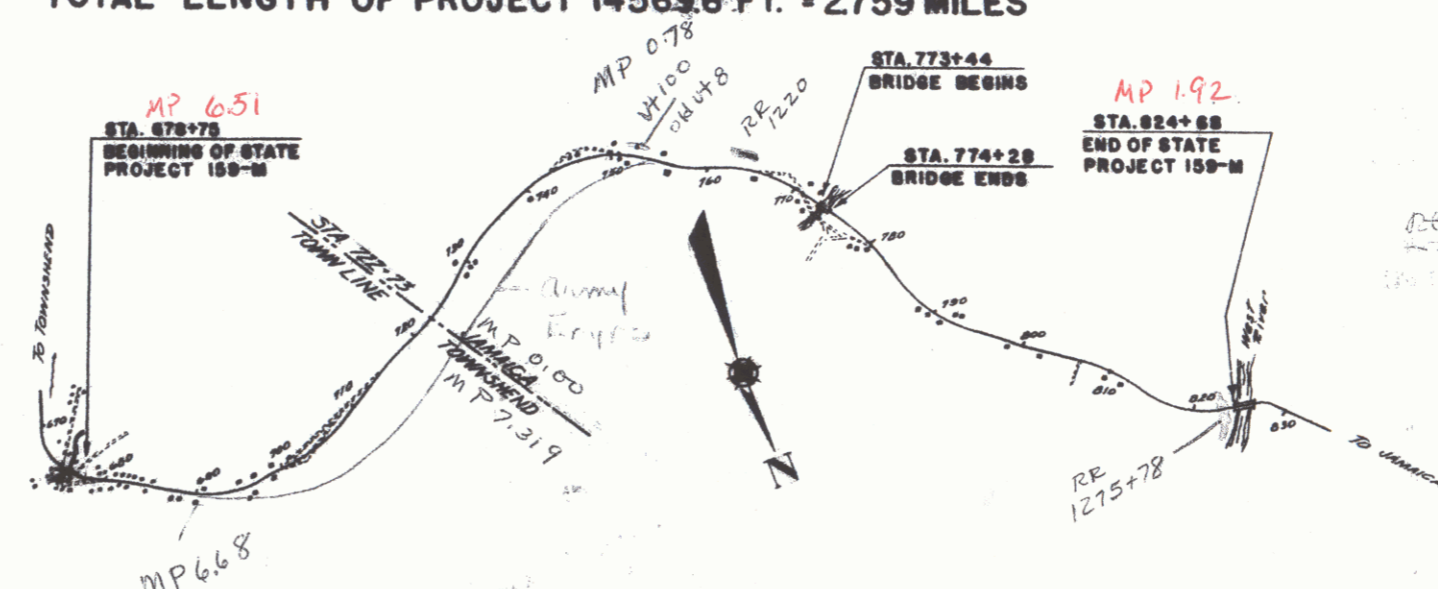

These plans are subject to such revisions as may be required by the Bureau of Public Roads or the Commissioner of Highways. Construction is to be carried on in accordance with the plans and Standard Road and Bridge

APPROVED: DEC 29, 1937
 Commissioner of Highways

RECOMMENDED FOR APPROVAL