


PARCEL	INSTRUMENT	DATE	GRANTOR	GRANTEE	RECORDED	TOWNSHIP	REMARKS
A-B-C	W.D.	1-2-30	SUSIE BURDETTE ESTATE	ST OF VT.	BOOK 31	PAGE 241-E	1-29-30
A'	R.C.D.	6-3-39	LESLIE C. RICHMOND	ST OF VT.	BOOK 31	PAGE 420	6-3-39 / CULV.

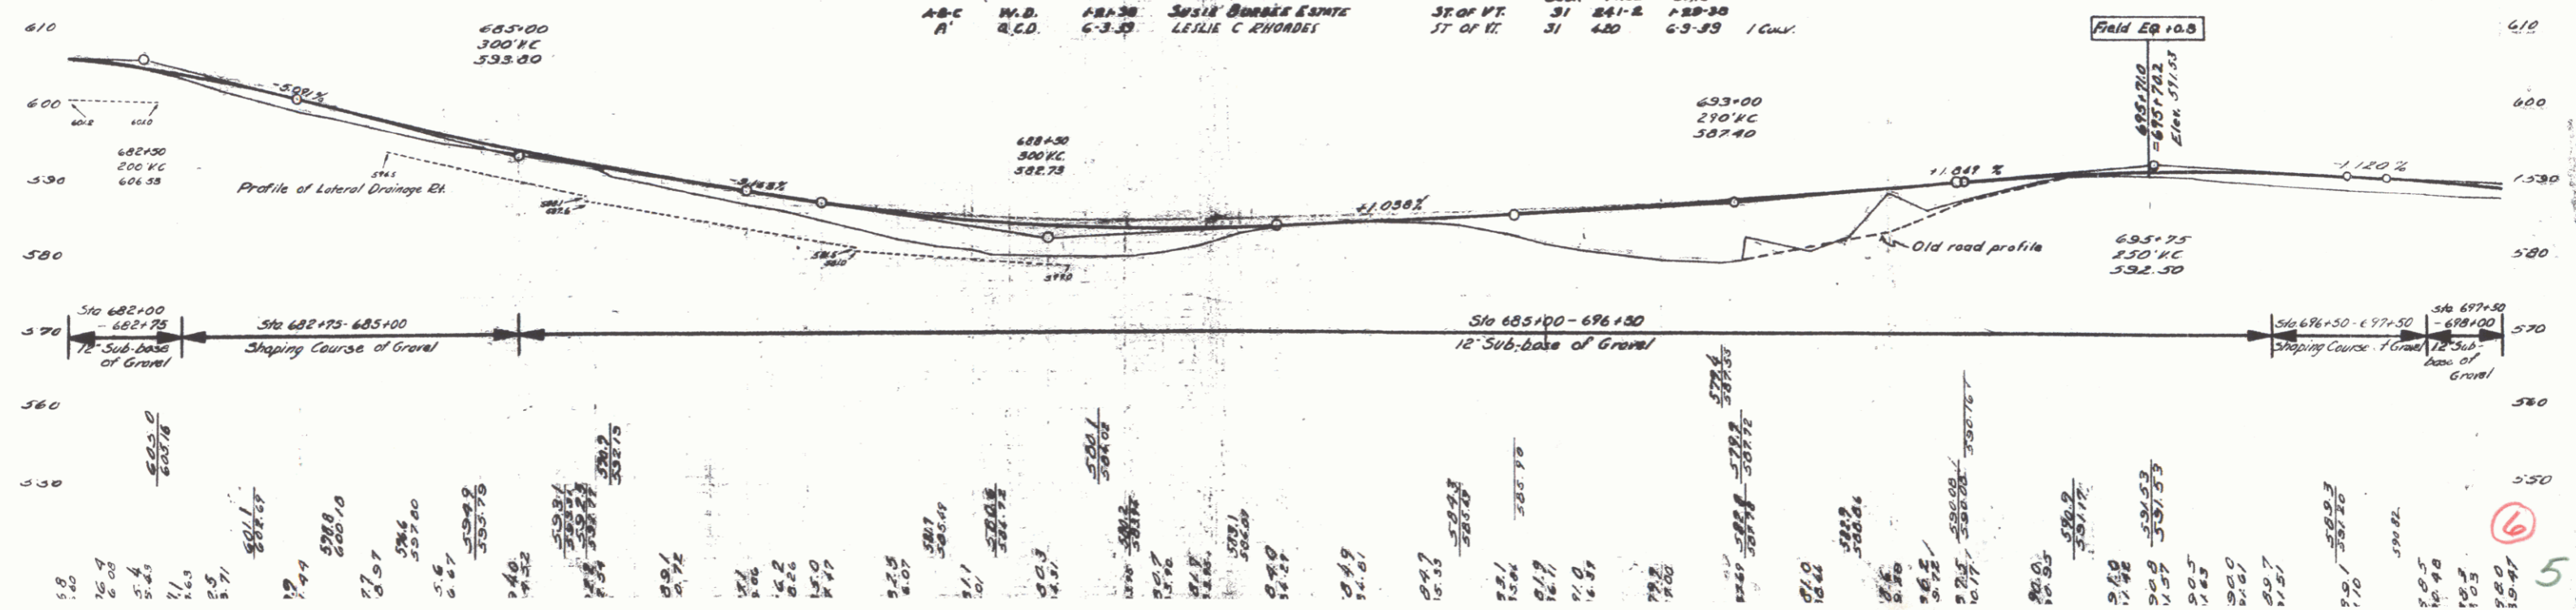

STATION	ELEVATION	REMARKS
682+00	582.73	Sub-base of Gravel
682+75	587.40	Sub-base of Gravel
685+00	587.75	Sub-base of Gravel
686+00	587.75	Sub-base of Gravel
