



SITE
158.19.222 @ 101

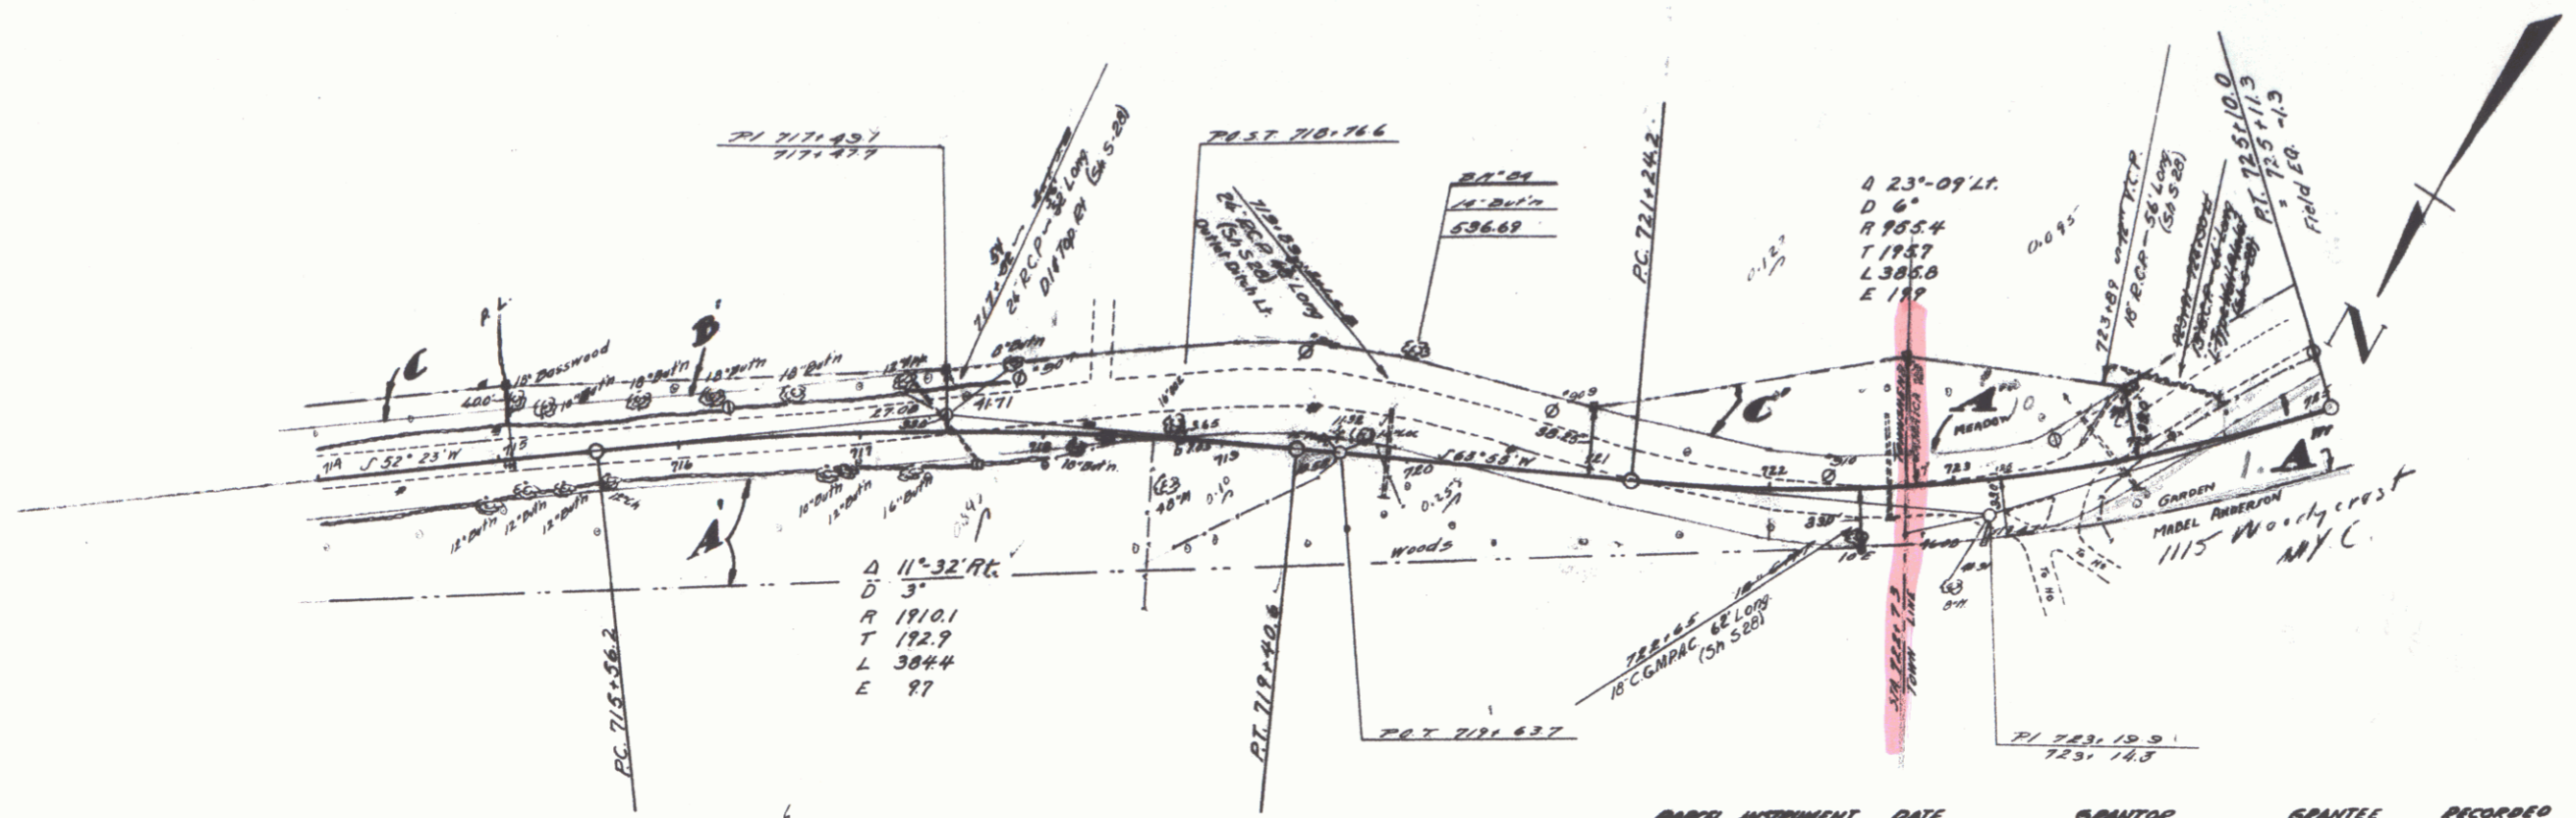

PARCEL	INSTRUMENT	DATE	GRANTOR	GRANTEE	RECORDED	TOWNSHIP	REMARKS
A-B-C	N.D.	1-21-30	SUSIE BURGES EDWARDS	STAR 17	BOOK 207	PAGE 124	1-21-30
A-B-C	G.C.D.	1-5-30	ALBRO T. HIGBARD	"	31	234-5	1-21-30
A"	G.C.D.	1-18-30	G. H. GLEASON	"	30	245	1-21-30
A"	G.C.D.	2-19-30	MABEL ANDERSON	"	30	269	2-23-30

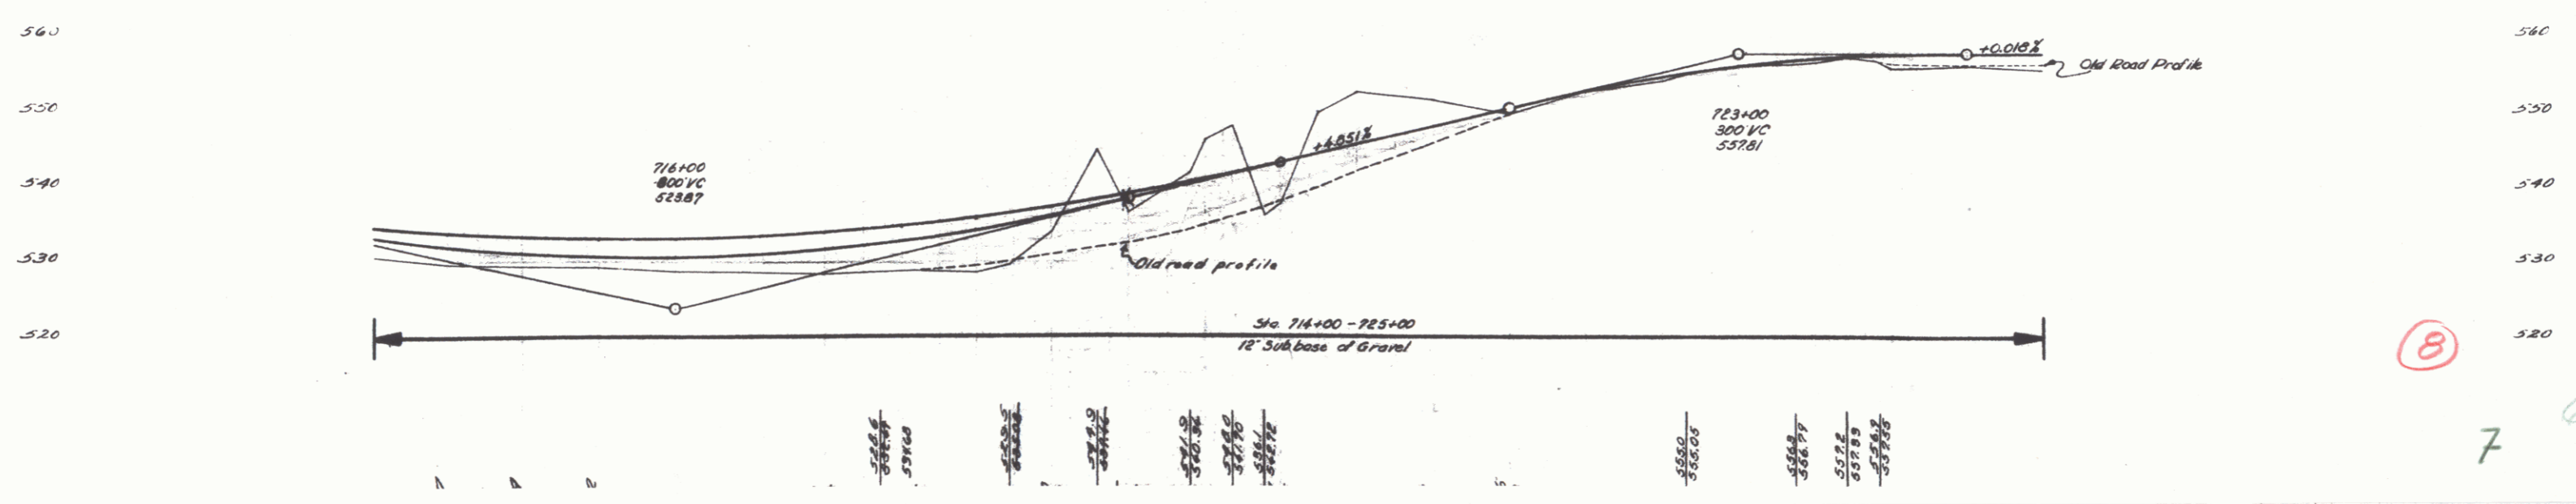

7 6