


Quitclaim Deed from State to Edward C. & Lila C. Deikamper dated Jan. 25, 1952 Book 33, Pg 38.

STATE
1597 1938 10 101

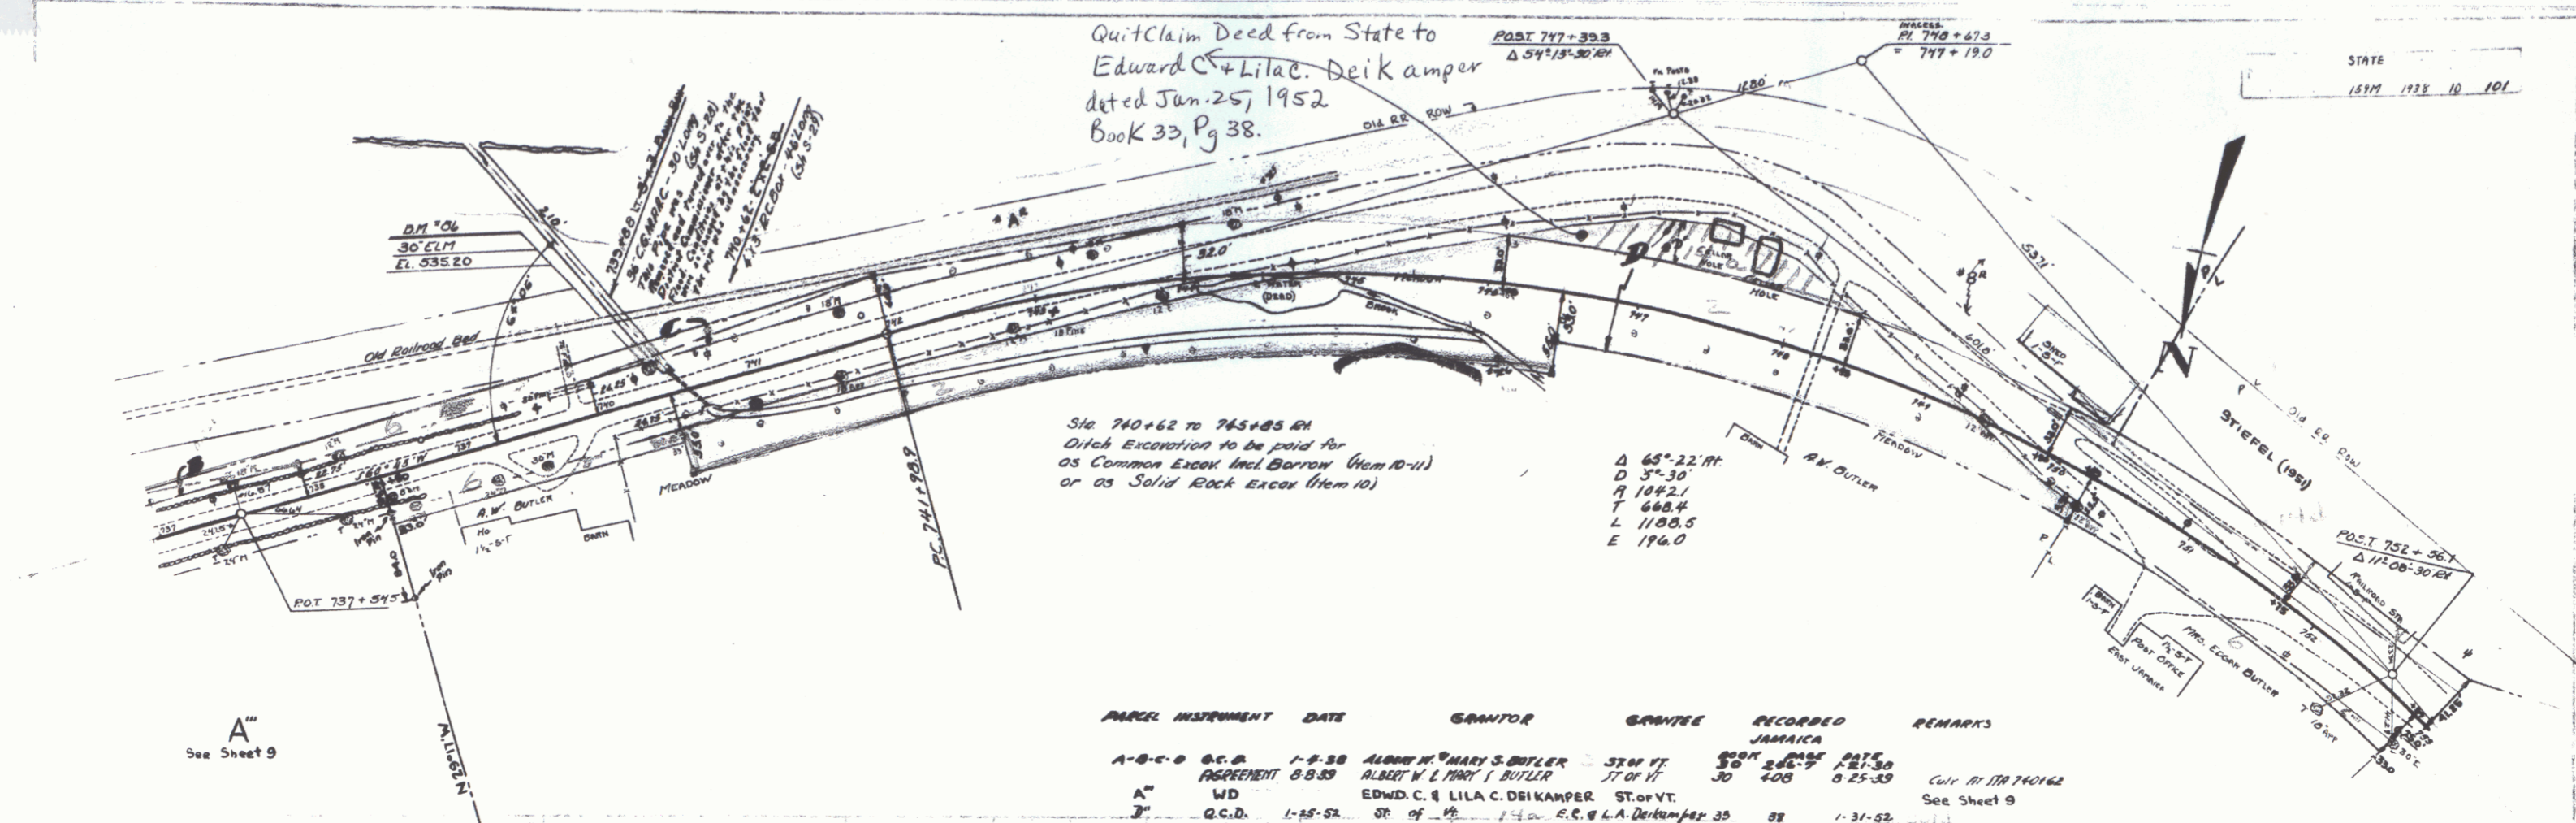

PARCEL	INSTRUMENT	DATE	GRANTOR	GRANTEE	RECORDED	REMARKS
A-B-C-D	Q.C.D.	1-4-52	ALBERT W. & MARY S. BUTLER	ST. OF VT.	BOOK 30 PAGE 408	Calc. by TRA 740162
A	WD	8-8-52	ALBERT W. & MARY S. BUTLER	ST. OF VT.	BOOK 30 PAGE 408	See Sheet 9
B	Q.C.D.	1-15-52	EDWARD C. & LILA C. DEIKAMPER	ST. OF VT.	BOOK 33 PAGE 38	See Sheet 9

