
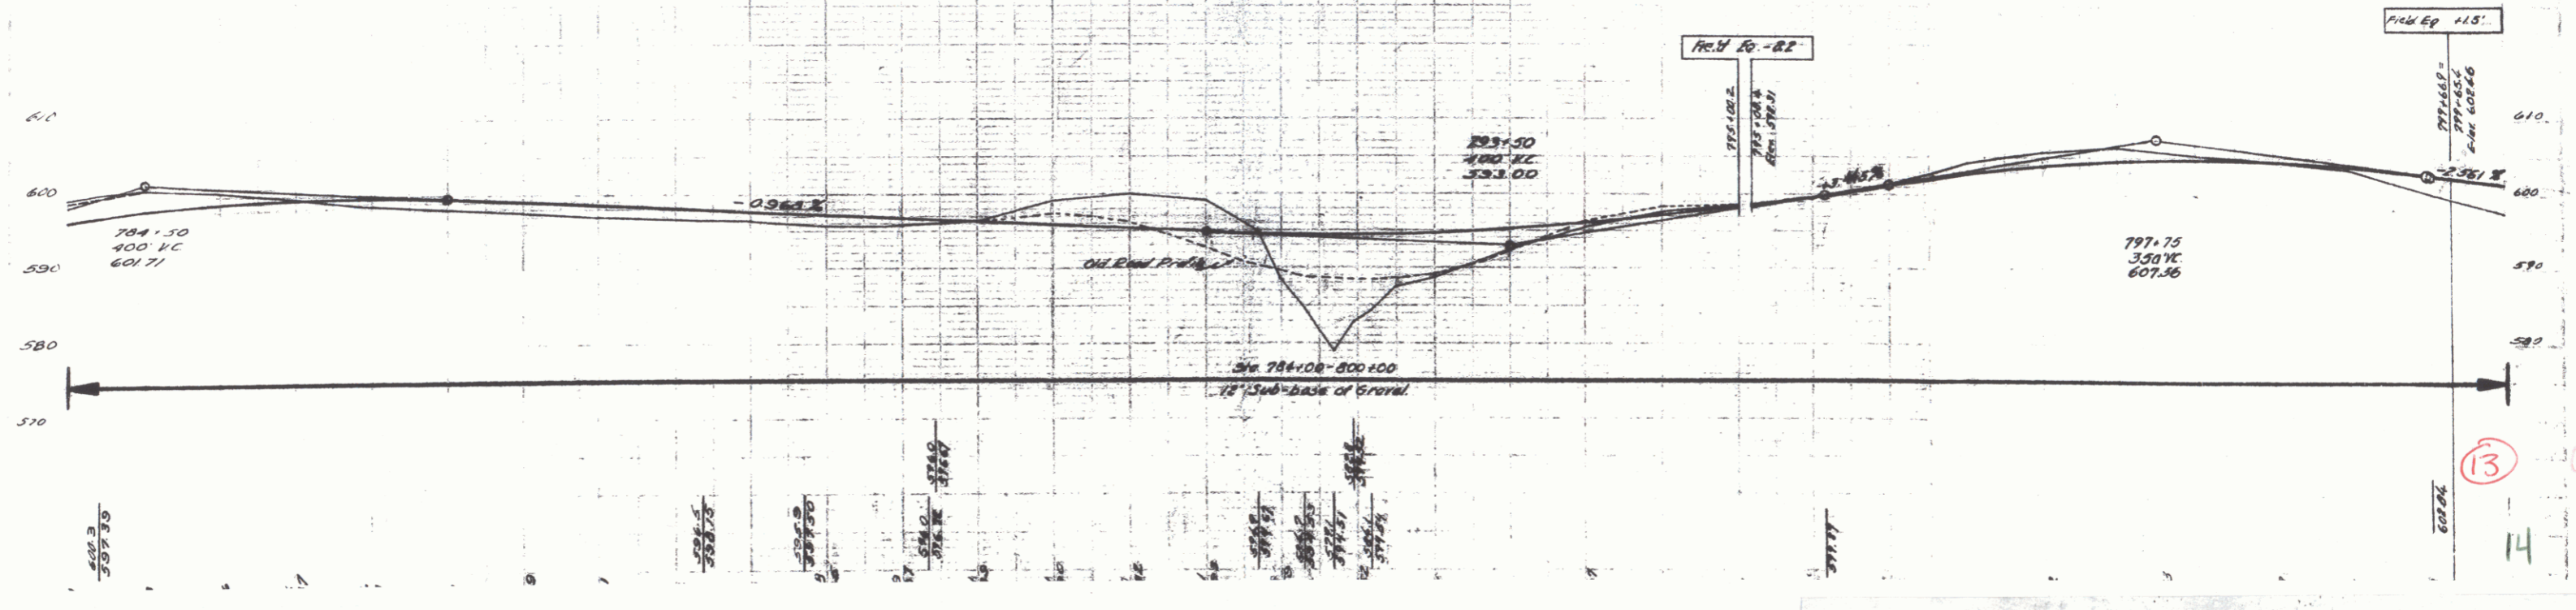


POOR ORIGINAL COPY

STATE
1947 1937 13 101

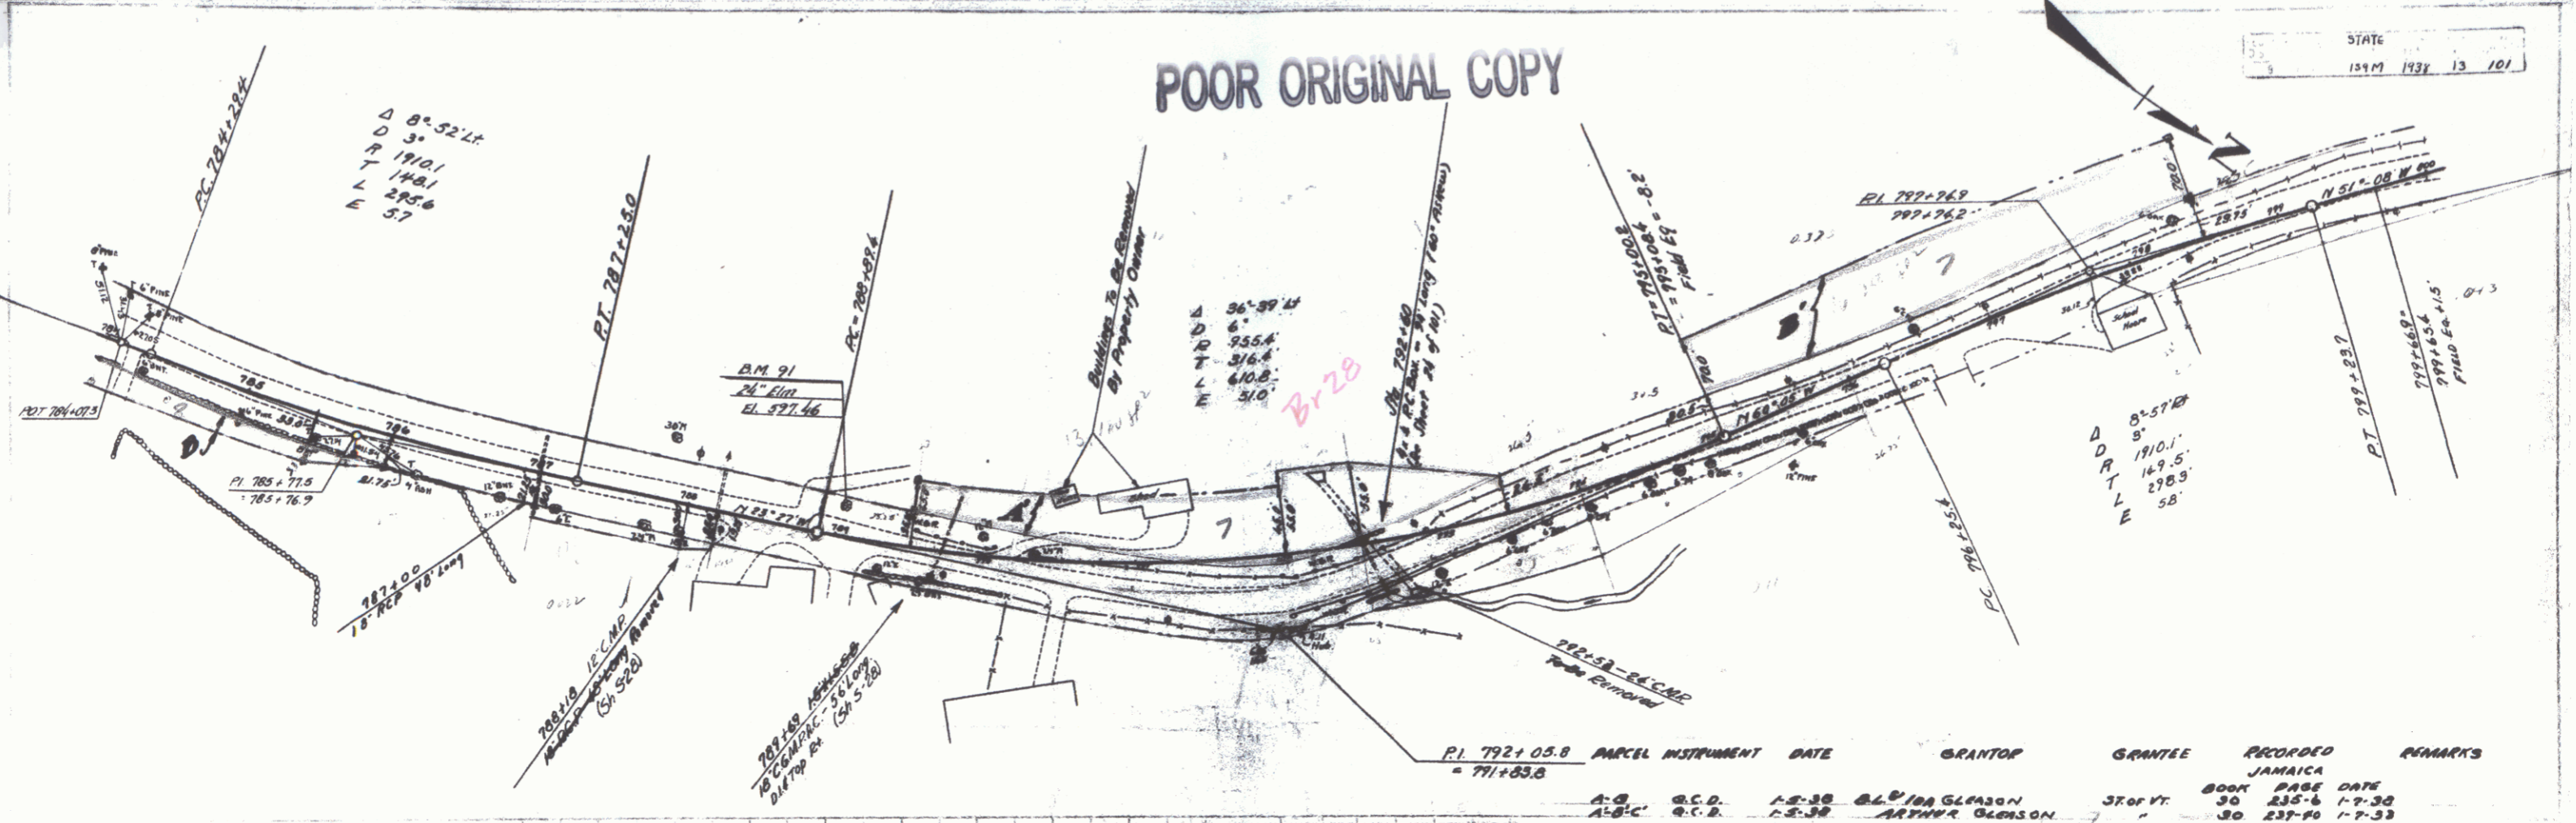

13
14