



DATE 6/15/36
SCALE 1/32
THREE
DATE 6/15/36
SCALE 1/32

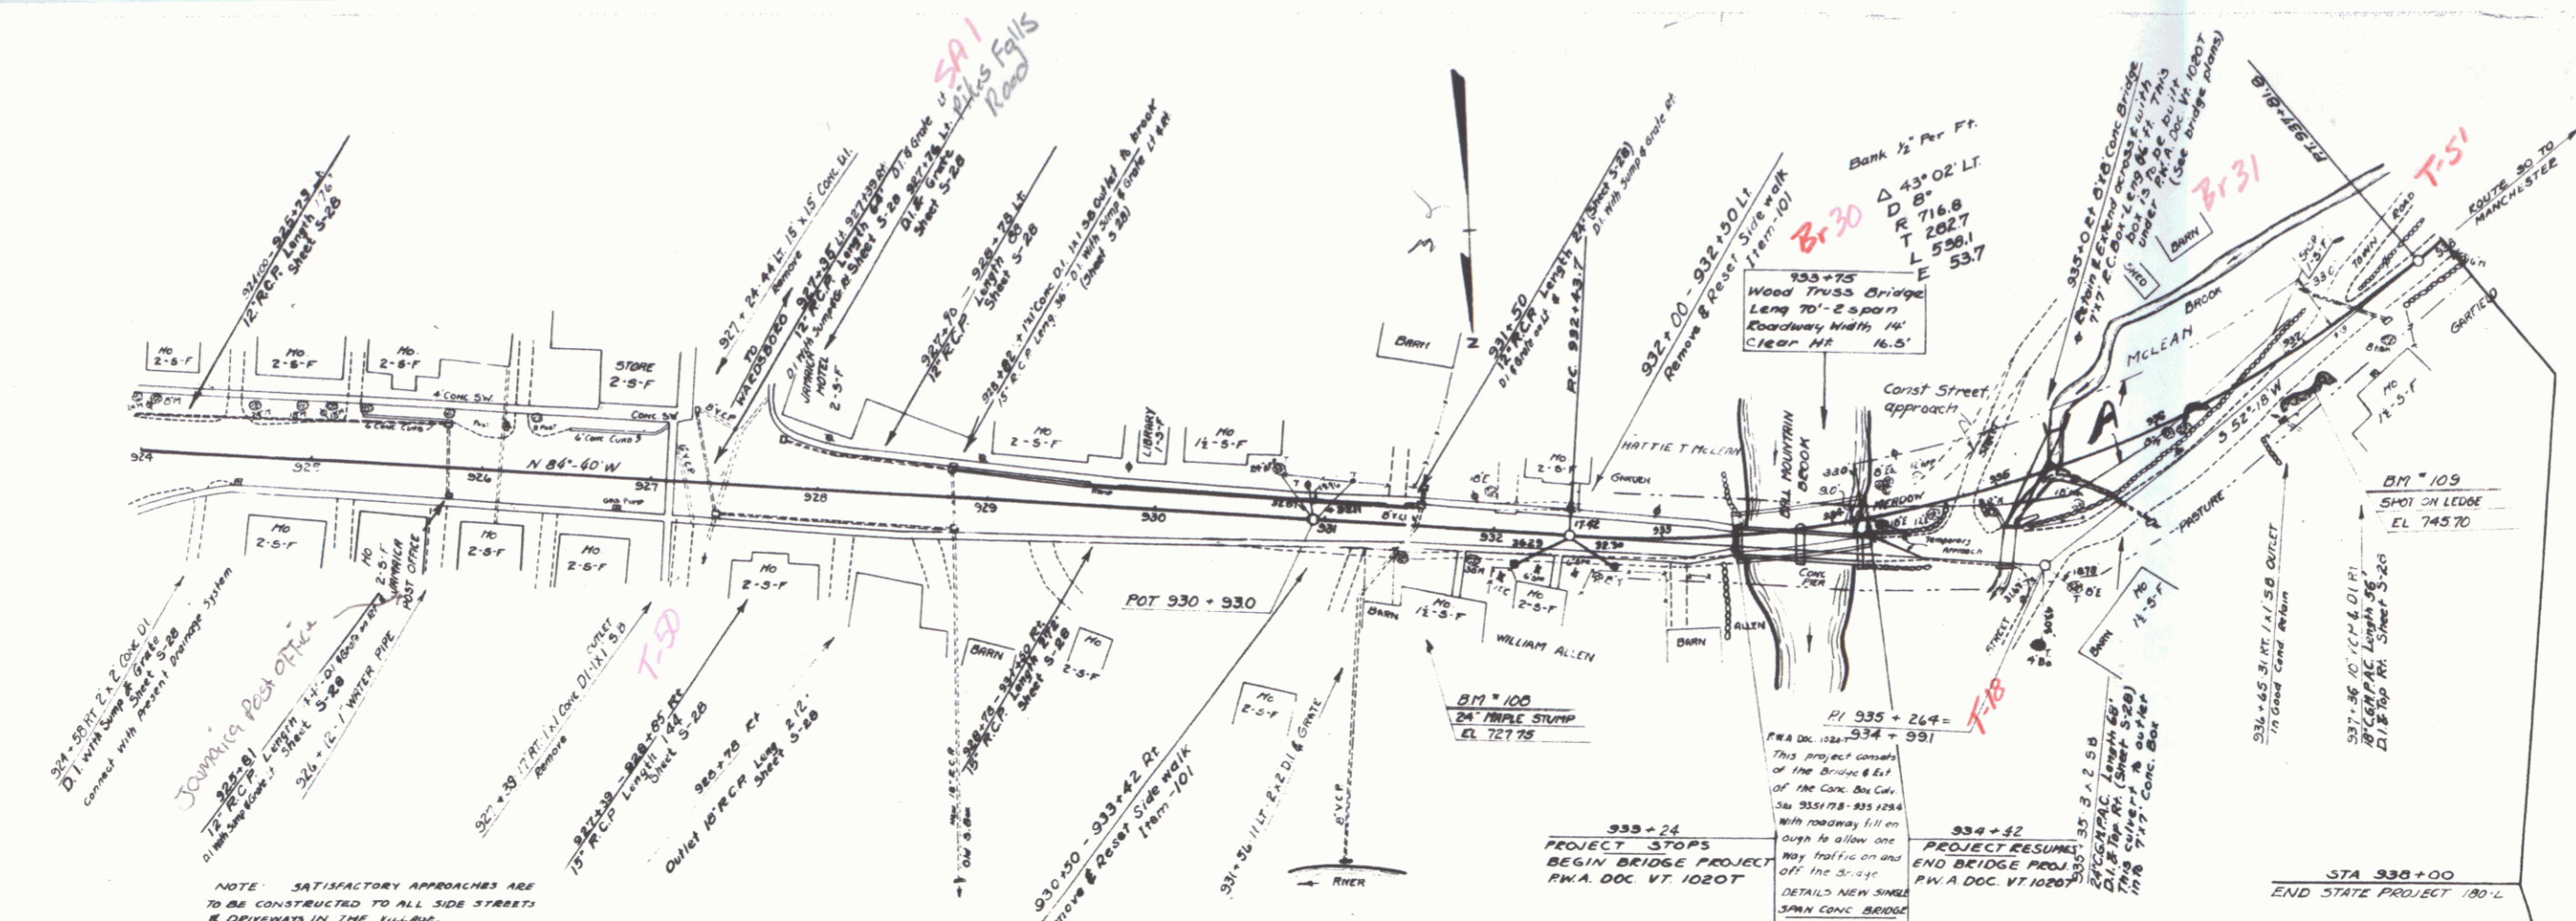

NOTE: SATISFACTORY APPROACHES ARE TO BE CONSTRUCTED TO ALL SIDE STREETS & DRIVEWAYS IN THE FILLAGE.

Parced With of Date of Grantor Cranks Recorded Remarks
Instrument Book Page Date
A G.C.D. 6-15-36 Henry A. McLean Staff No. 30 68 6-15-36

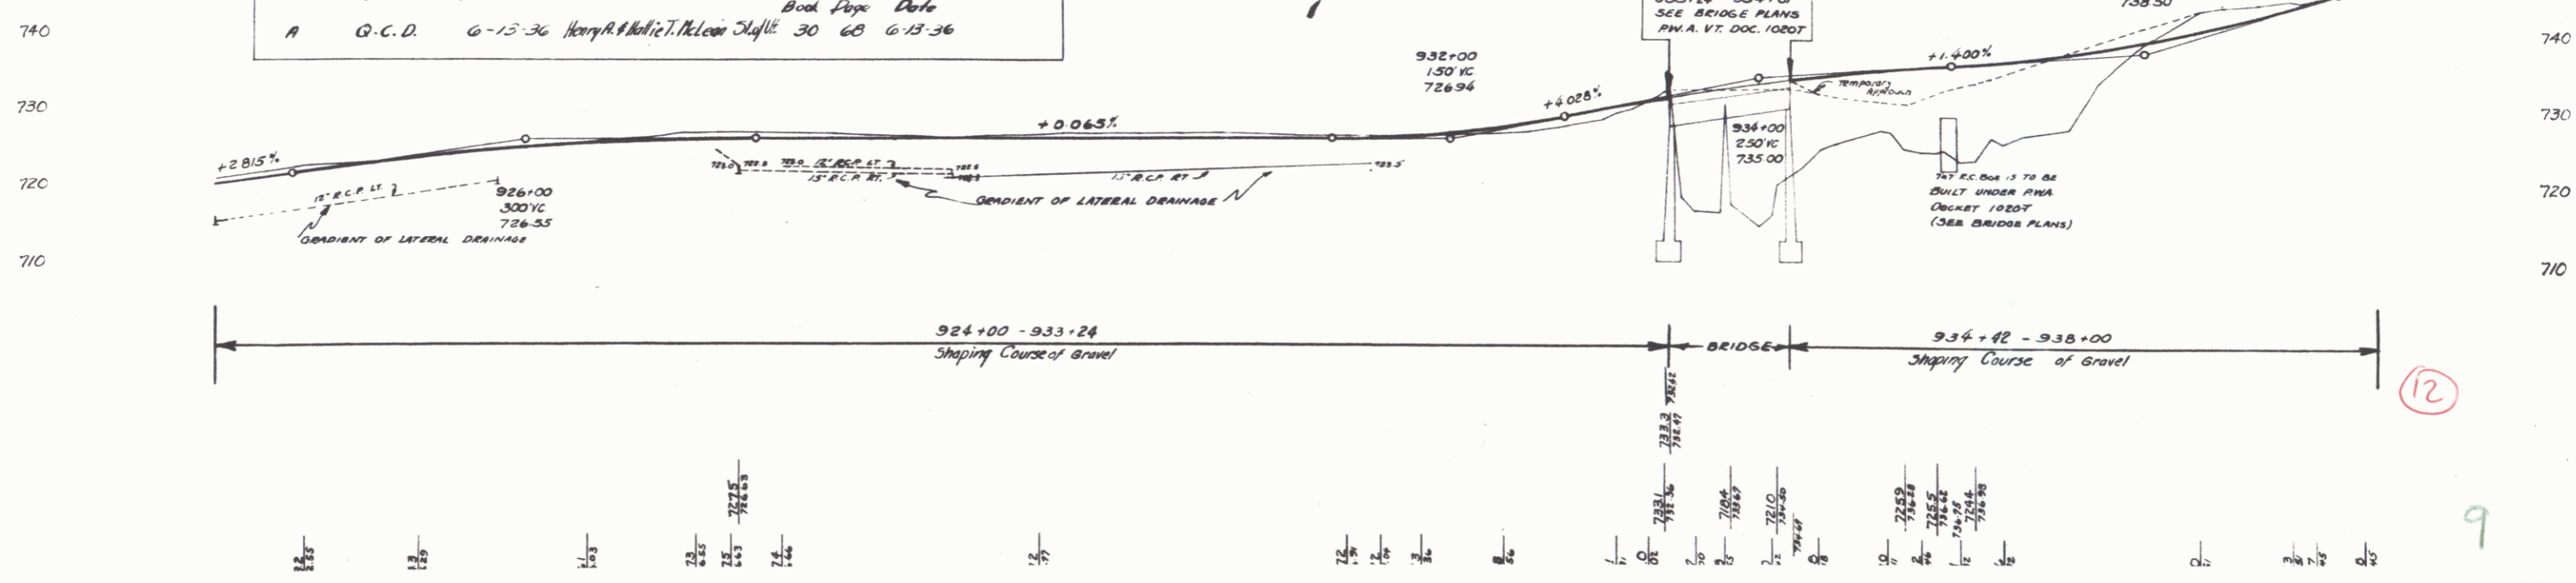

12

9