
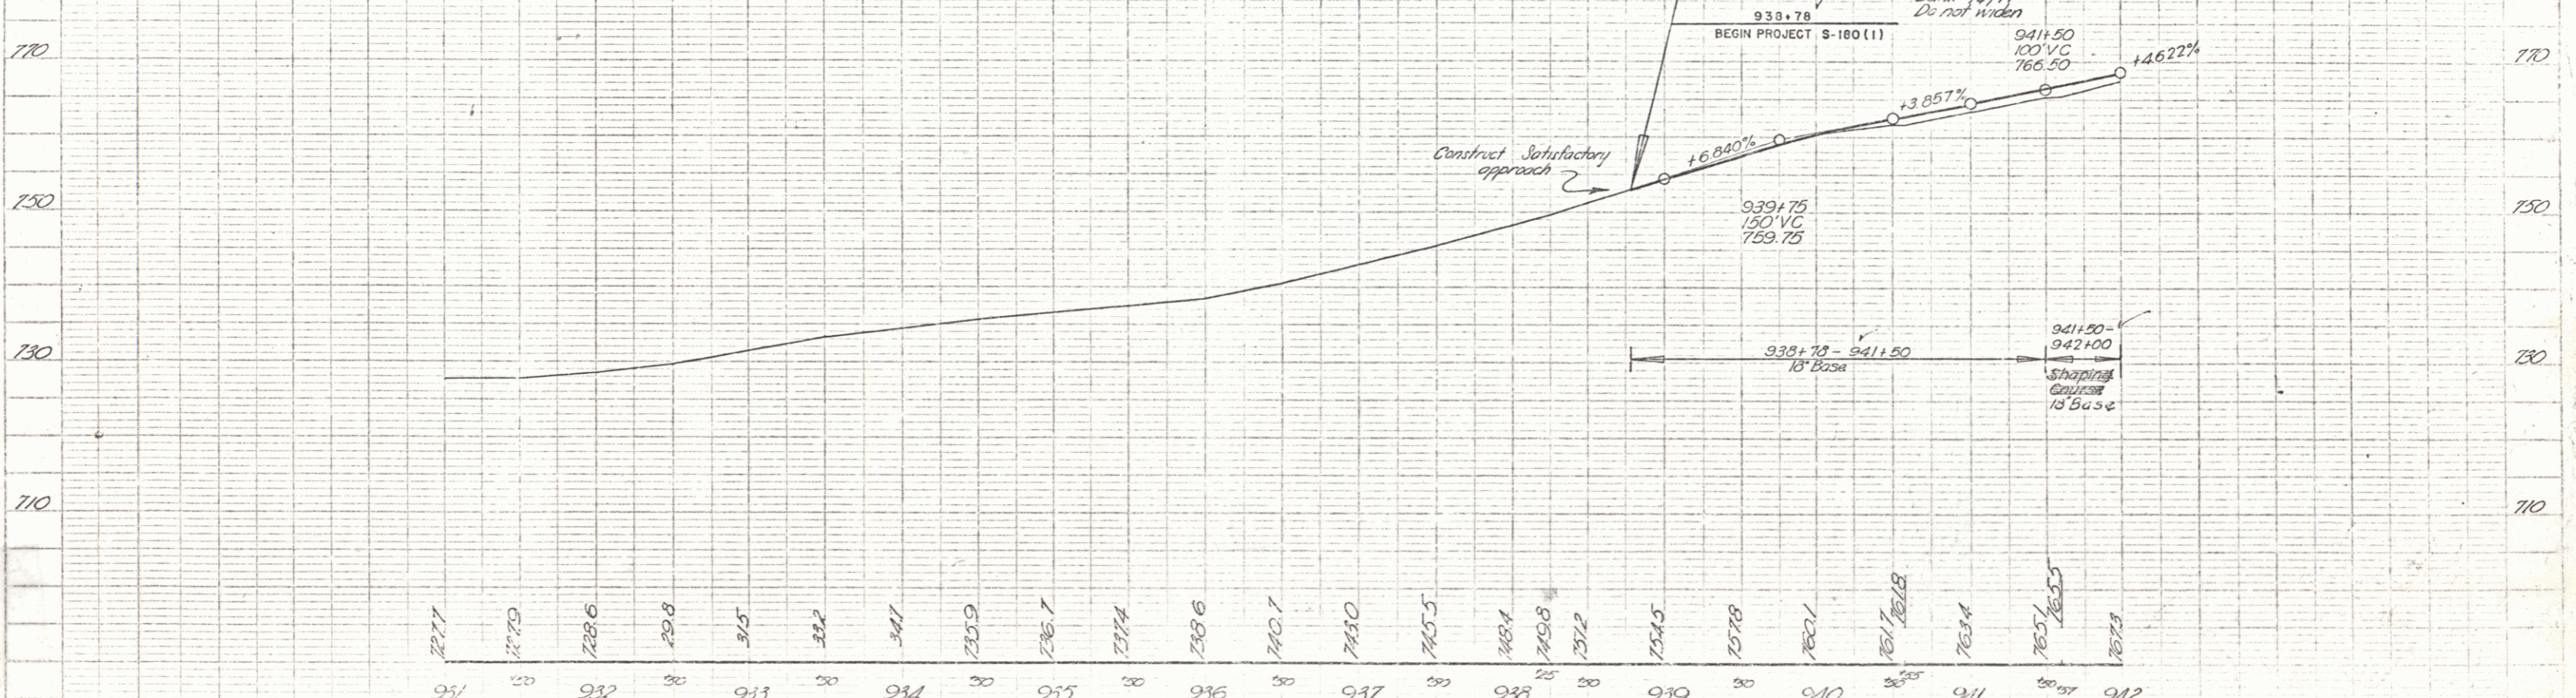


PLAN
 DATE
 SHEET NO. 10-48
 TOTAL SHEETS 10-49

PLAN
 DATE
 SHEET NO. 10-48
 TOTAL SHEETS 10-49

PARCEL INSTRUMENT # 1A
 DATE M.D.O.E. 6-9-49
 GRANTEE WALLACE W. & VERA E. CROWNSHIELD
 GRANTEE ST. OF VT.
 RECORDED JAMAICA
 BOOK 32
 PAGE 367
 DATE 6-18-49
 REMARKS:-

WJD GUIDE POSTS
 LT RT NO.
 91+00 1

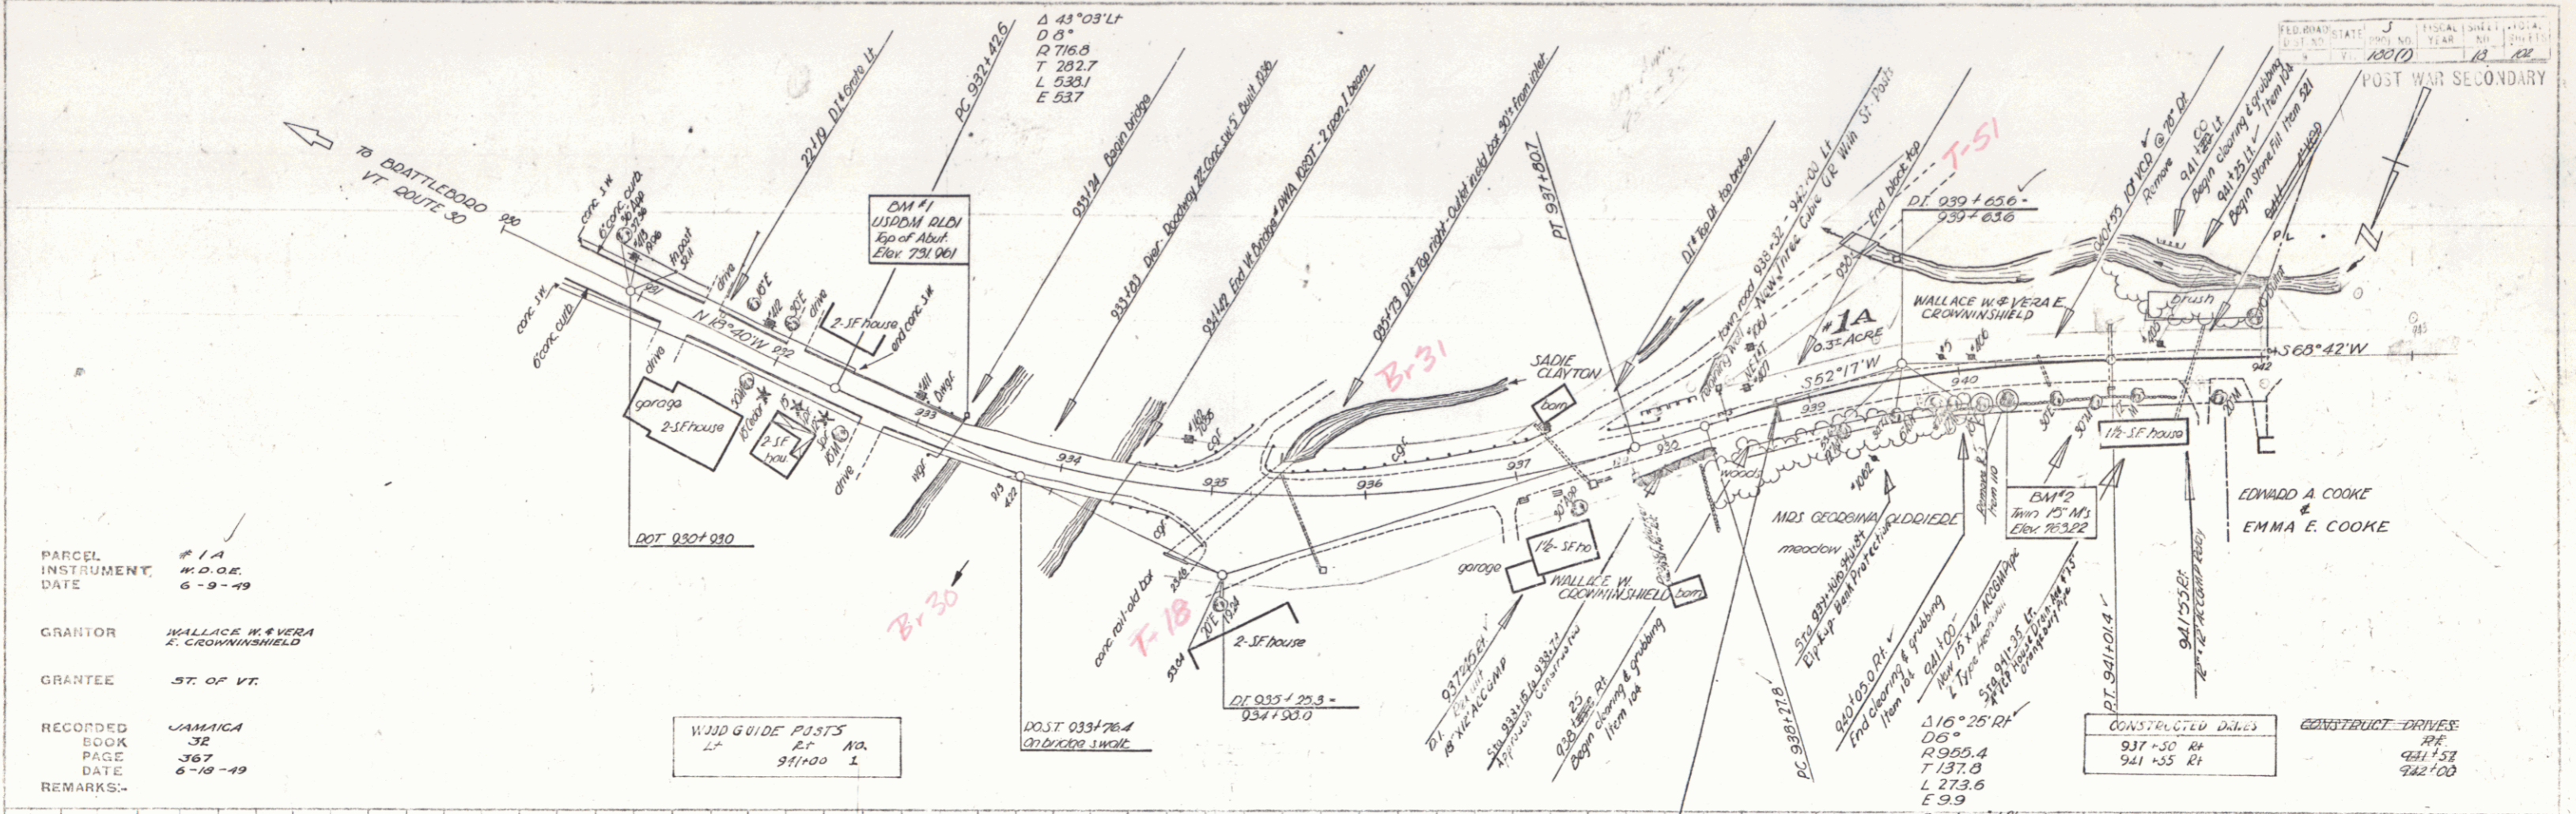

951
 B.M. #1 Bronze tablet R.L.B. #1 (1942) SW corner bridge abut 135' Lt sta 933+25 elev. 731.961
 B.M. #2 S.I.R. twin 15' M 11' Rt sta 940+20 elev. 763.22

JAMAICA
 Series 1 No 120 (1)
 Sheet 10 of 10 Sheets