
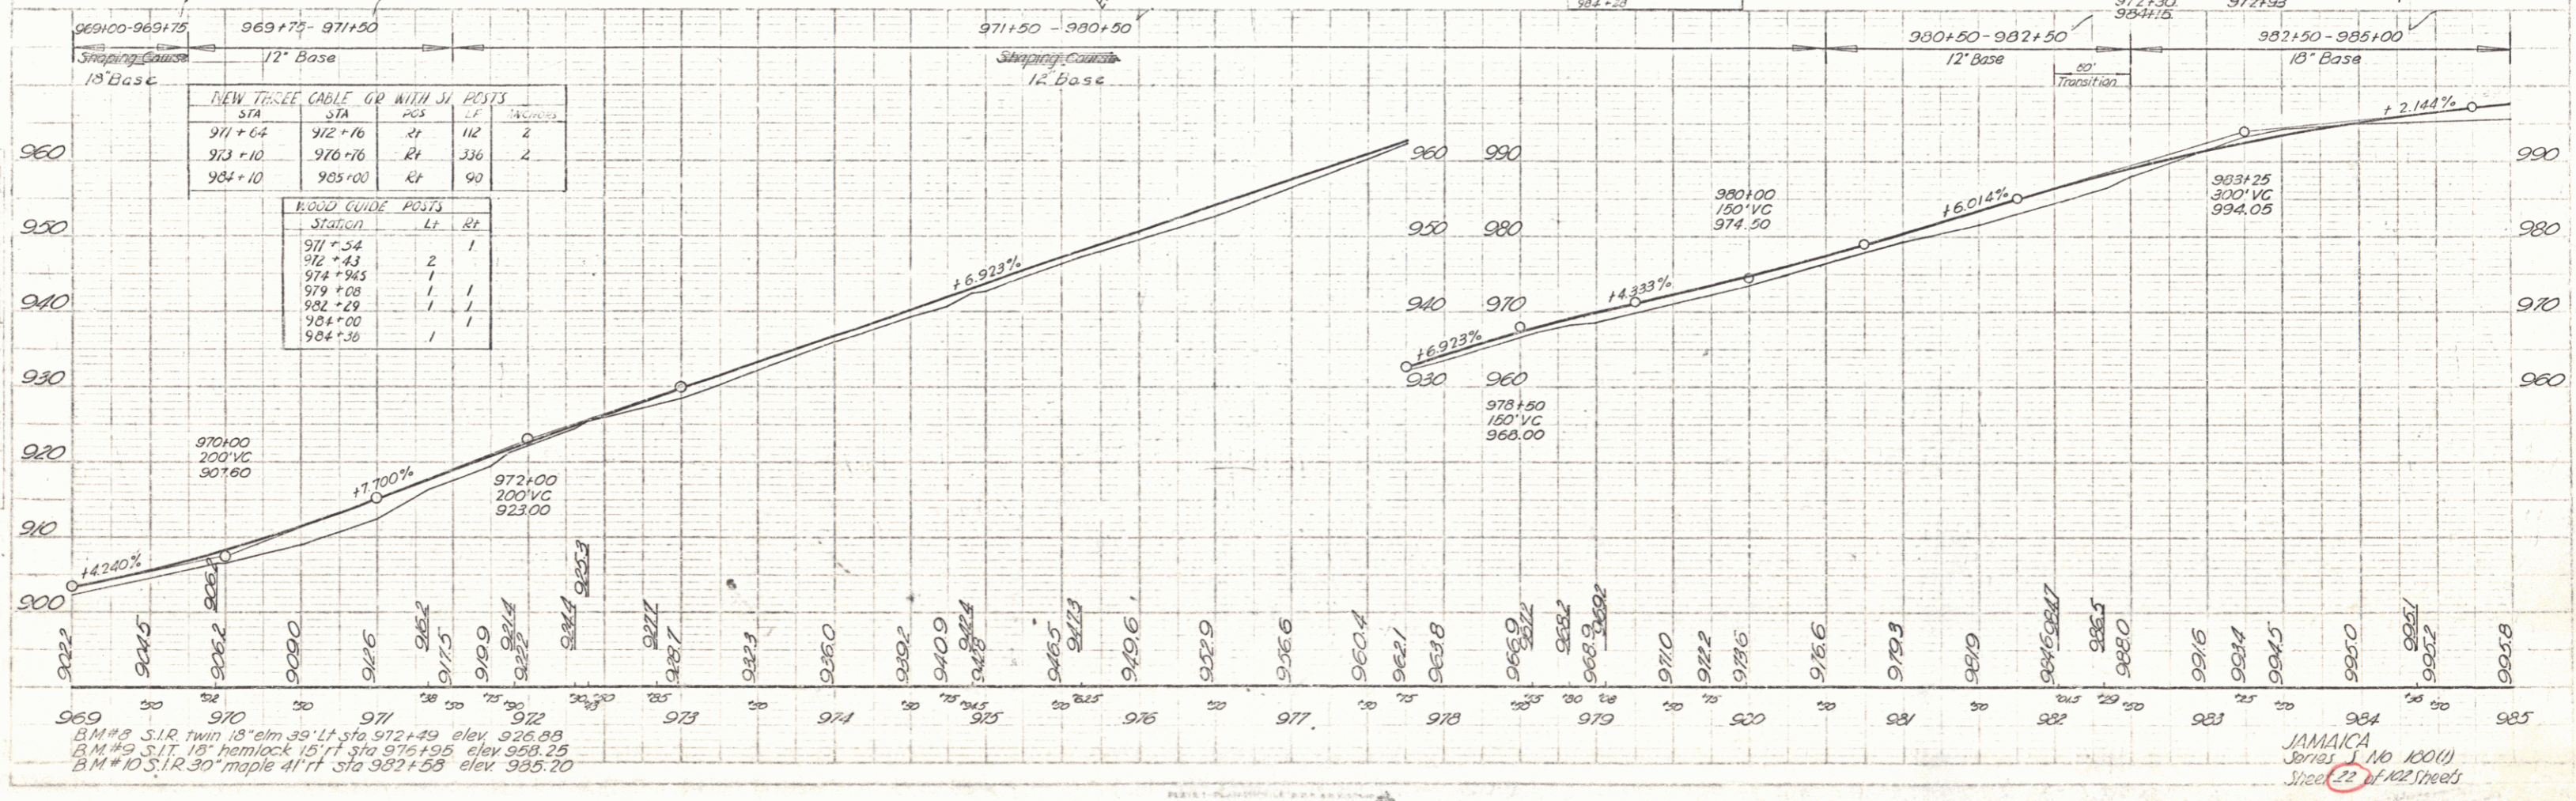


PARCEL INSTRUMENT # 10 A, B, C
 DATE W. D. E. 6-10-49
 GRANTOR ALBERT H. & LILLIANE A. EBELING
 GRANTEE ST. OF VT.
 RECORDED JAMAICA
 EOOK PAGE 389
 DATE 6-22-49
 REMARKS #10 C ON SHEET 23

POST WAR SECONDARY

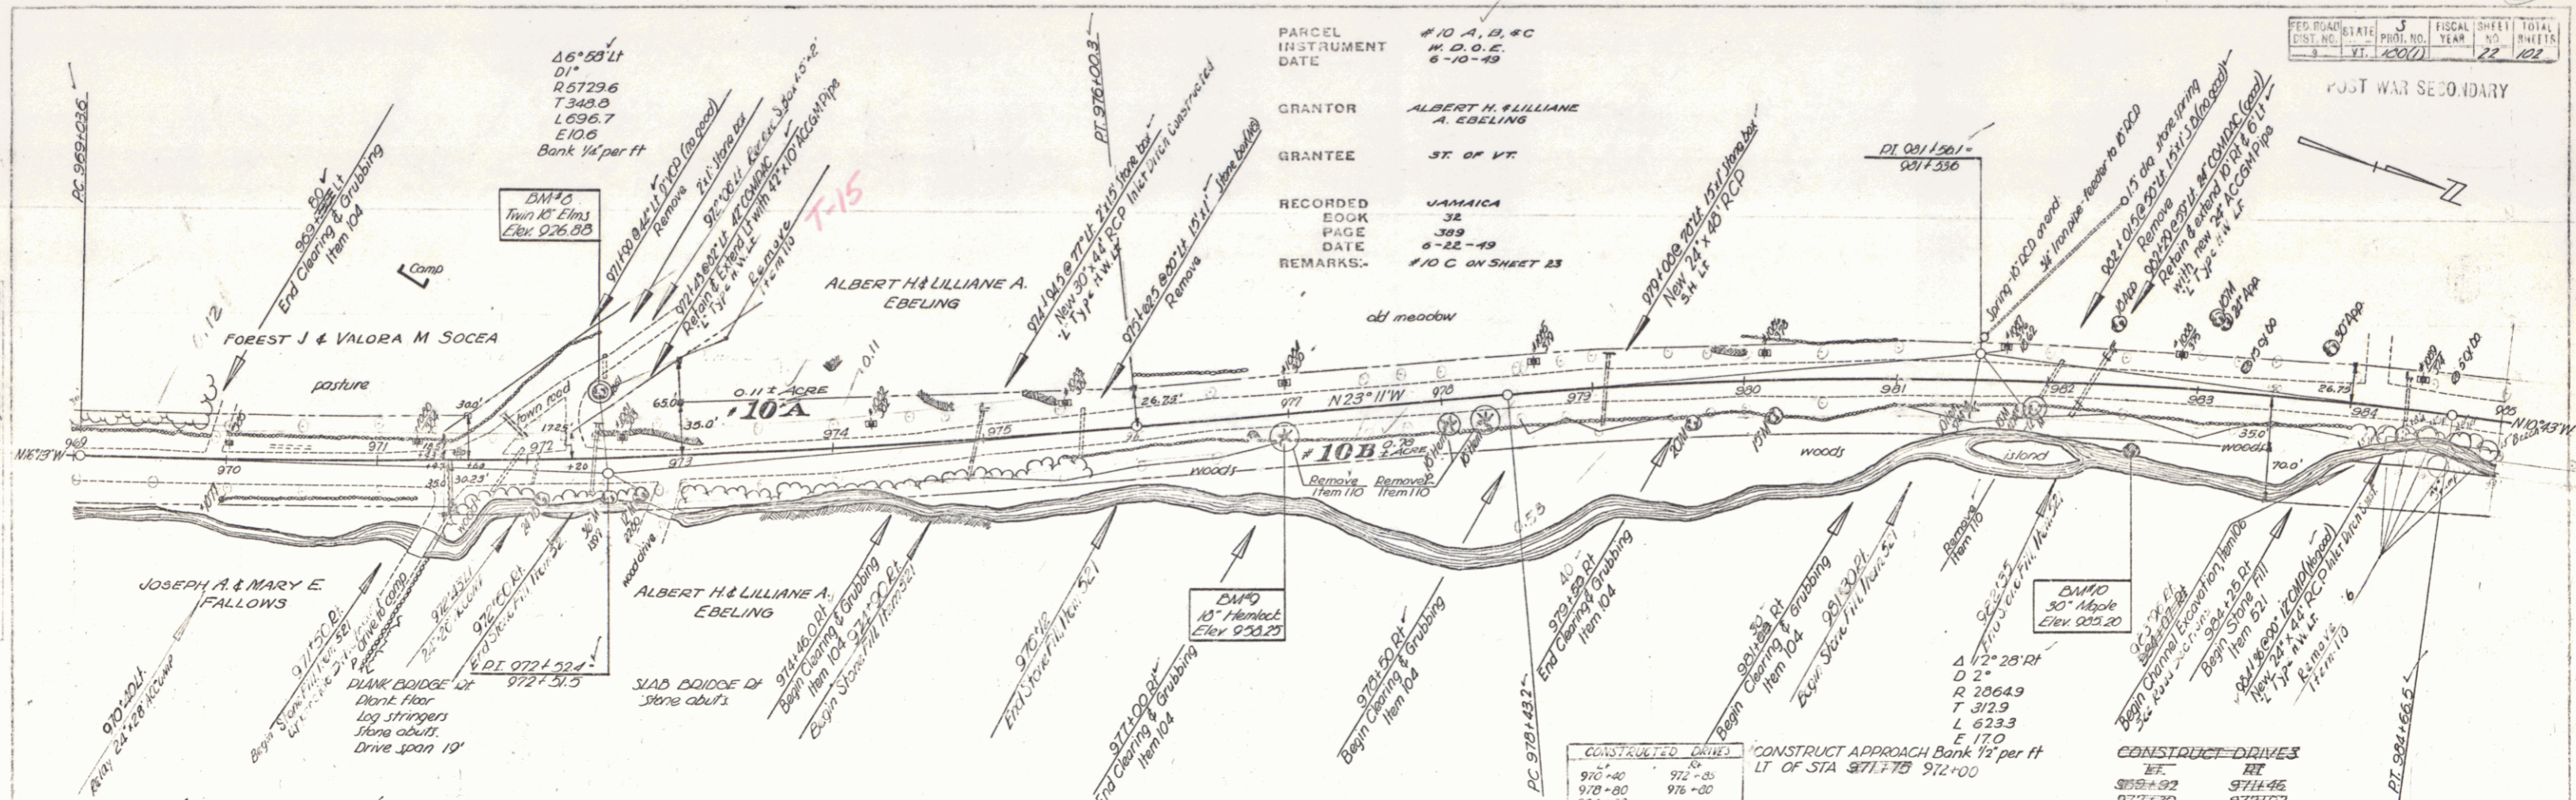

B.M. # 8 S.I.R. twin 18" elm 39' lt. sta. 972+49 elev. 926.88
 B.M. # 9 S.I.T. 18" hemlock 15' lt. sta. 976+55 elev. 928.25
 B.M. # 10 S.I.R. 30" maple 41' lt. sta. 982+58 elev. 935.20

JAMAICA Series No. 100(1)
 Sheet 22 of 102 Sheets