


STATION	LF	RF
1001+74.5	1	1
1002+58	1	1
1003+26	1	1
1003+59	1	1
1003+60	1	1
1006+39	1	1
1009+76	1	1

STATION	POS	LF	ANCHORS
1002+60	1003+96	RF	120
1004+09	1005+21	RF	112
1007+28	1011+00	RF	372

CONSTRUCTED DIVES	LF	RF
1004+35	1003+60	
1004+75	1006+45	

PARCEL	#13 A	#14 A+B	#15 A, B, C
INSTRUMENT	W.D.O.E.	W.D.O.E.	W.D.O.E.
DATE	6-17-49	6-25-49	4-25-50
GRANTOR	R. H. LANQUETTE	HELEN HANFORD	OTIS R. HEFFLON, ADMR. OF OSCAR V. HEFFLON ESTATE
GRANTEE	ST. OF VT.	ST. OF VT.	ST. OF VT.
RECORDED BOOK	JAMAICA 32	JAMAICA 32	JAMAICA 32
PAGE	391	400	195
DATE	6-22-49	6-30-49	4-29-50
REMARKS	1010+75 300' VC 1152.50 1010+75 300' VC 1152.50 1010+75 300' VC 1152.50 1010+75 300' VC 1152.50		

VERMONT STATE GRID SYSTEM  
COORDINATES N 22.815 N  
STA. 0100 E 420.218 87

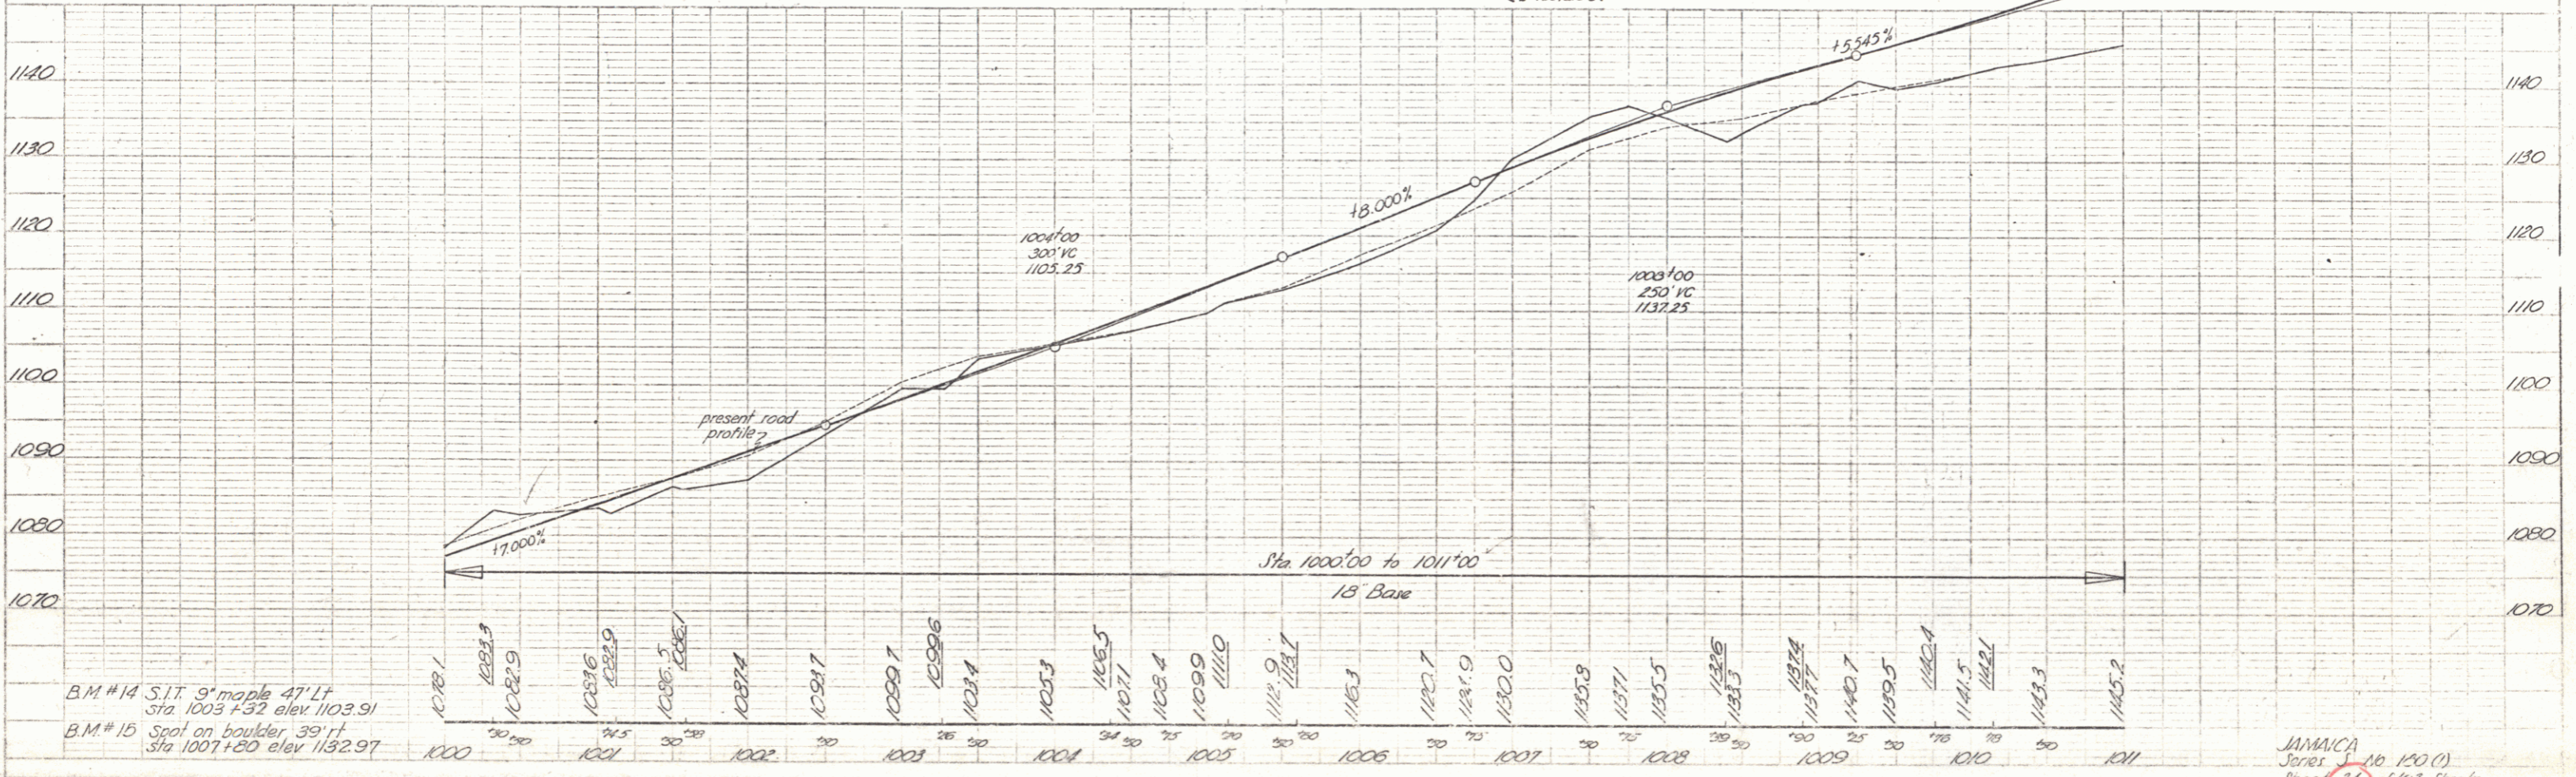

B.M. #14 S.T. 9" maple 47' LF  
Sta. 1003+32 elev. 1103.91  
B.M. #15 Spot on boulder 39' LF  
Sta. 1007+80 elev. 1132.97

JAMAICA Series No. 100(1) Sheet 24 of 102 Sheets