


PARCEL #16 A  
 INSTRUMENT W.D.O.E.  
 DATE 6-9-49  
 GRANTOR CLIFTON C. LANDMAN  
 GRANTEE ST OF VT.  
 RECORDED JAMAICA  
 BOOK 373  
 DATE 6-18-49  
 REMARKS-

STA	S/A	P33	L/F	AVG	POSTS
1040+50	1041+05	LT	144	2	WOOD GUIDE POSTS
1040+84	1040+34	RT	573	2	574 LT 1
1041+27	1030+25	RT	203	2	1040+77 1
1042+21	1030+23	LT	59	2	1042+05 1
					1047+27 1
					1050+33 1

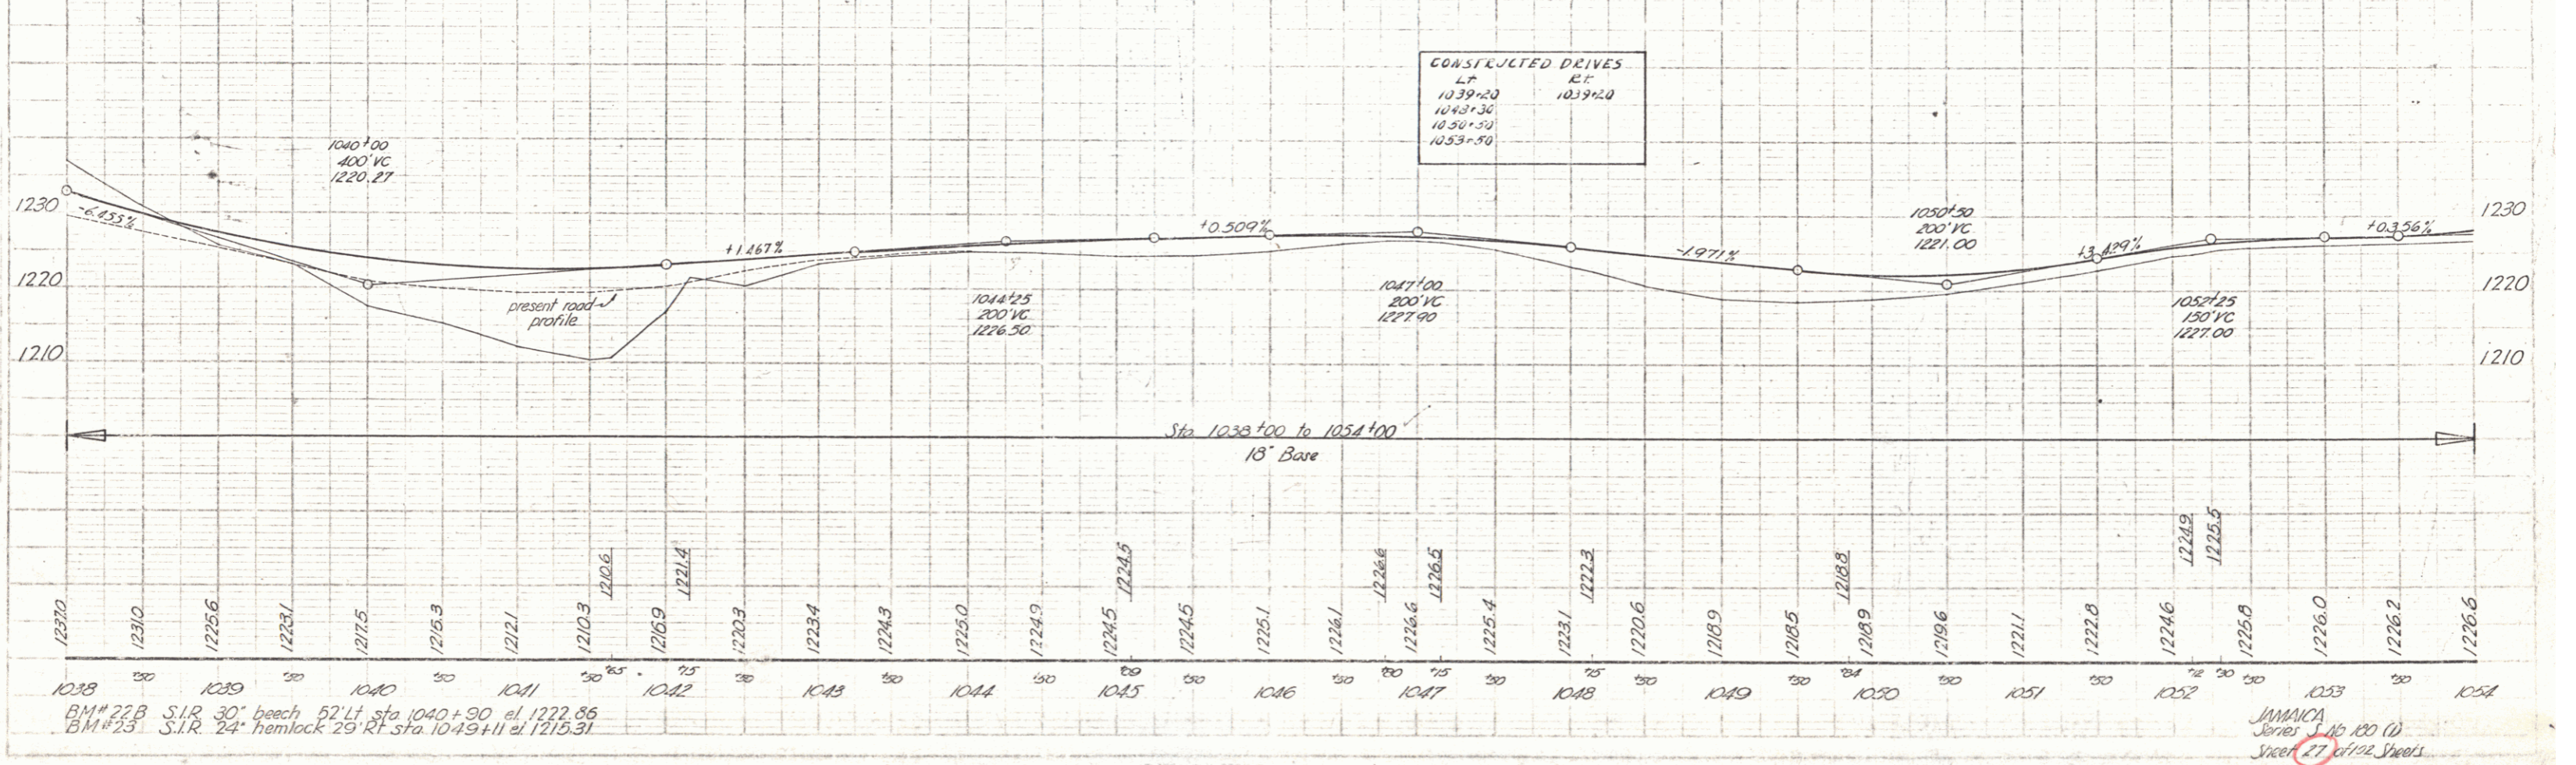

BM# 22B S.I.R. 30' beech 52' lt sta 1040+30 el 1222.86  
 BM# 23 S.I.R. 24' hemlock 29' rt sta 1049+11 el 1215.31

JAMAICA  
 Street 10 100 (D)  
 Street 27 1012 Street