



PARCEL # 13 183 # 17 A
 INSTRUMENT W.D.O.E. W.D.O.E.
 DATE 8-8-49 6-10-49
 GRANTOR WM. GEORGE & FLORENCE M. DISSET BERNARD H. & LUCILLE D. PARSONS
 GRANTEE ST. OF VT. ST. OF VT.
 RECORDED JAMAICA JAMAICA
 BOOK 3E 3E
 PAGE 486 378
 DATE 8-12-49 6-18-49
 REMARKS: BURNED H. & LUCILLE D. PARSONS

DIST. NO. 3 FISCAL YEAR 1950 SHEET NO. 25 TOTAL SHEETS 102
 POST WAR SECONDARY

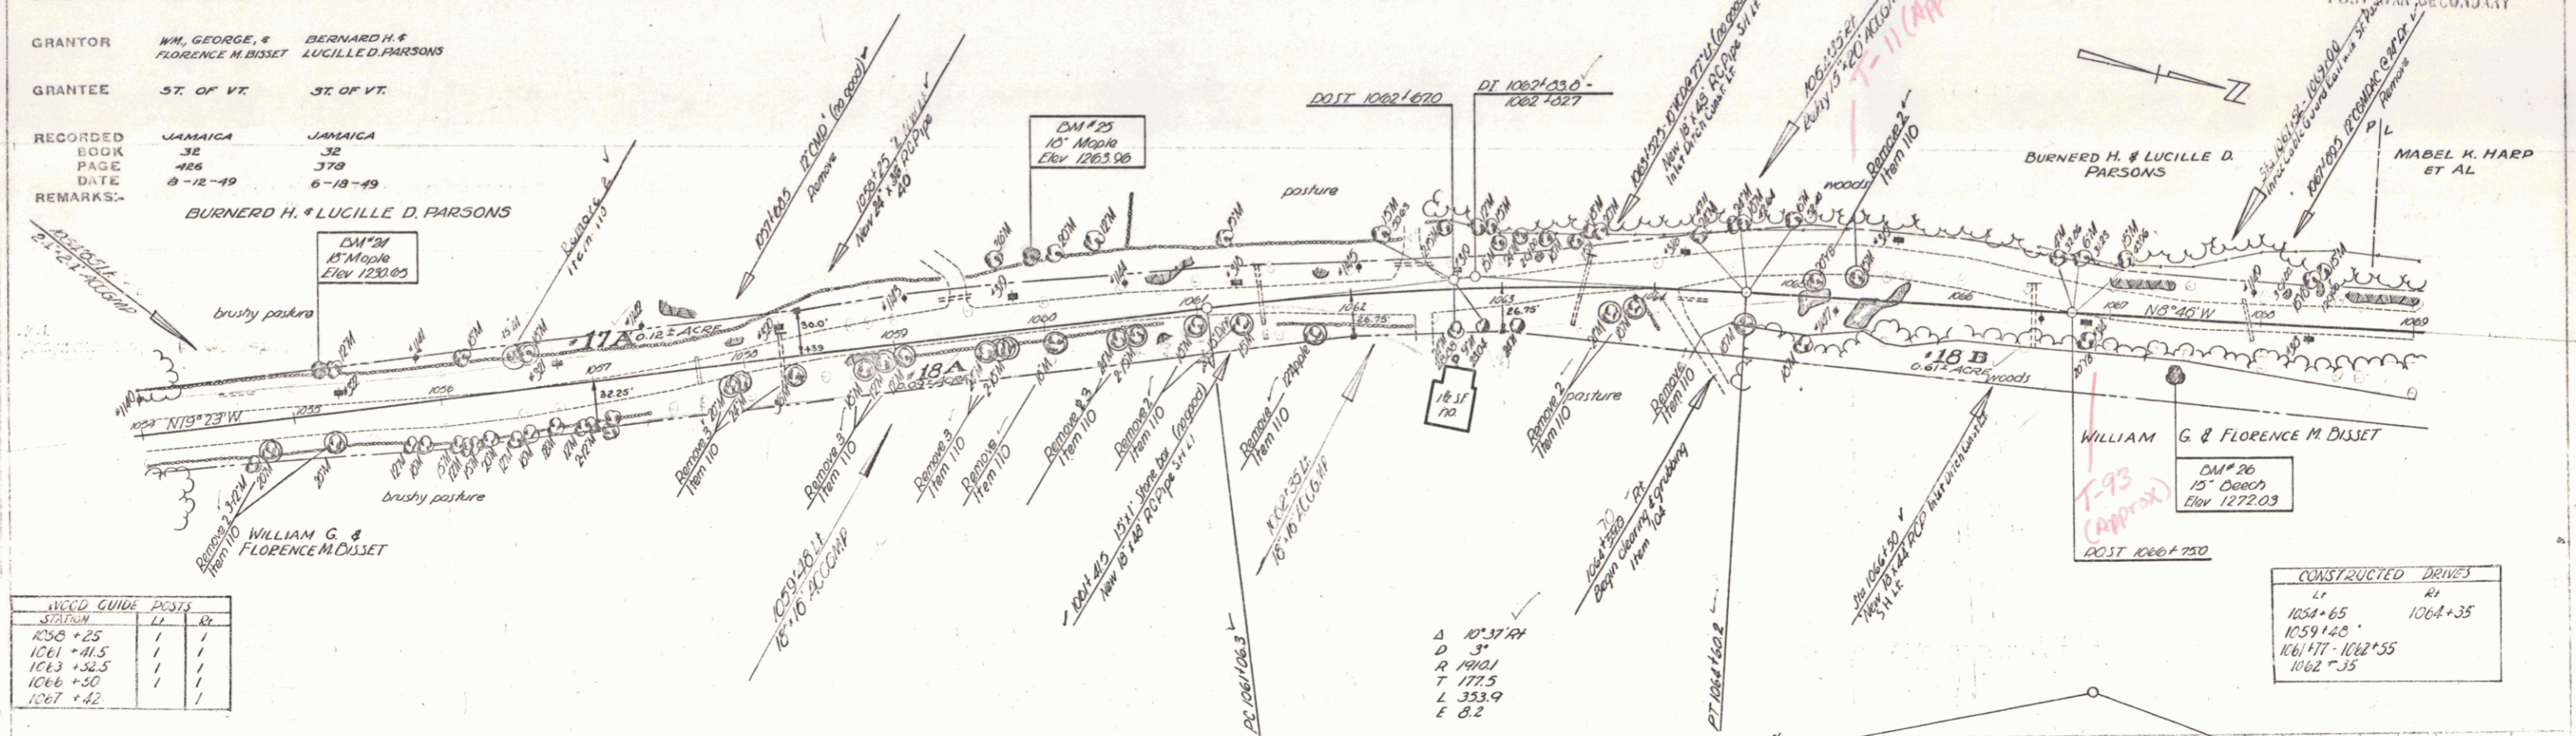

WOOD GUIDE	POSTS
1056 + 25	1
1061 + 41.5	1
1063 + 32.5	1
1066 + 50	1
1067 + 42	1

CONSTRUCTED DRIVES	
1058 + 65	1064 + 35
1059 + 40	
1061 + 17	1062 + 55
1062 + 55	

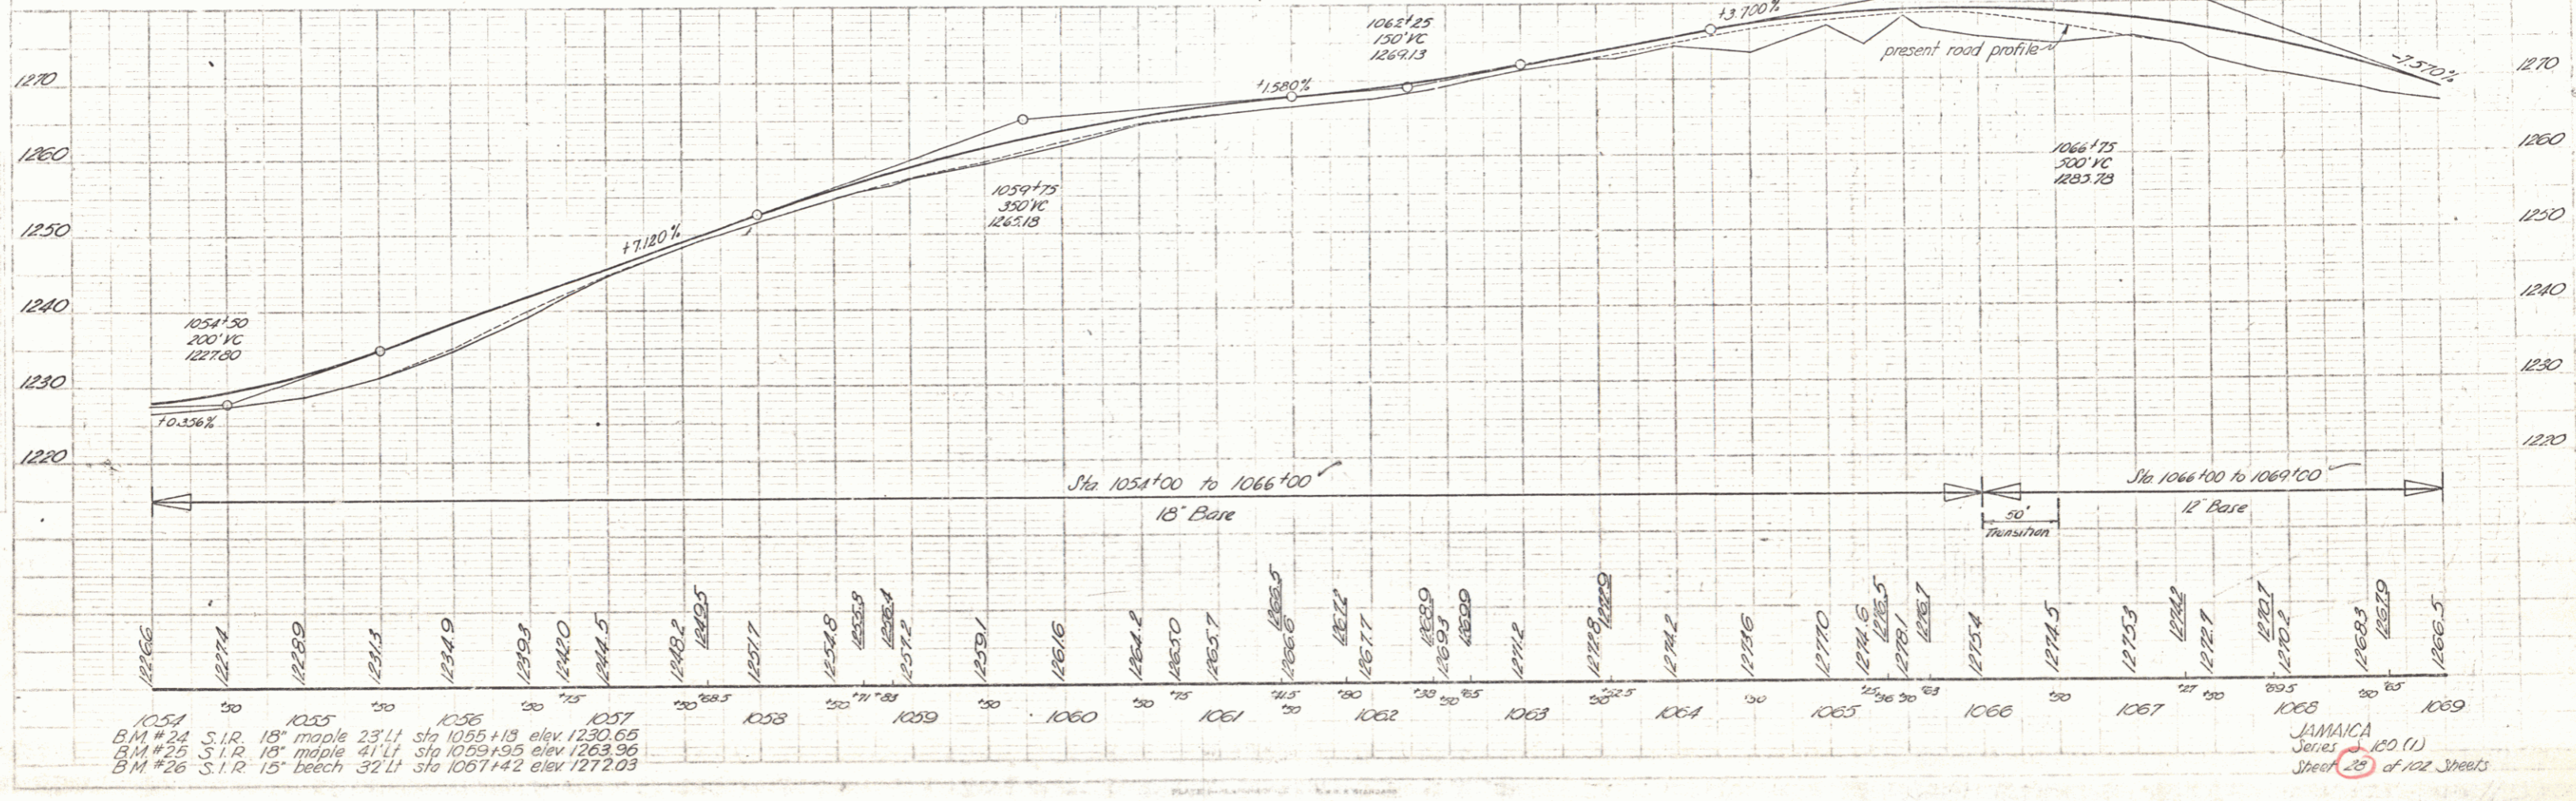

1054 B.M. #24 S.I.R. 18" maple 23' 11" stp 1055+13 elev 1230.65
 1055 B.M. #25 S.I.R. 18" maple 41' 11" stp 1059+95 elev 1263.96
 1056 B.M. #26 S.I.R. 15" beech 32' 11" stp 1067+42 elev 1272.03

JAMAICA
 Sheet # 100 (1)
 Sheet 25 of 102 Sheets