


WOOD GUIDE POSTS			CONSTRUCTED DRIVES	
STA	LT	RT	LT	RT
1113+39	/	/	1119+13	/
1115+00	/	/	1120+23	/
1116+00	/	/	1121+25	/
1118+19.5	/	/	1122+100	/
1121+16	/	/		
1123+40	/	/		
1126+66	/	/		

PARCEL # 27 A & B
 INSTRUMENT W.D.O.E.
 DATE 6-9-49
 GRANTOR MARY H. REDMOND
 GRANTEE ST. OF VT.
 RECORDED JAMAICA
 BOOK 38
 PAGE 368
 DATE 6-18-49
 REMARKS:

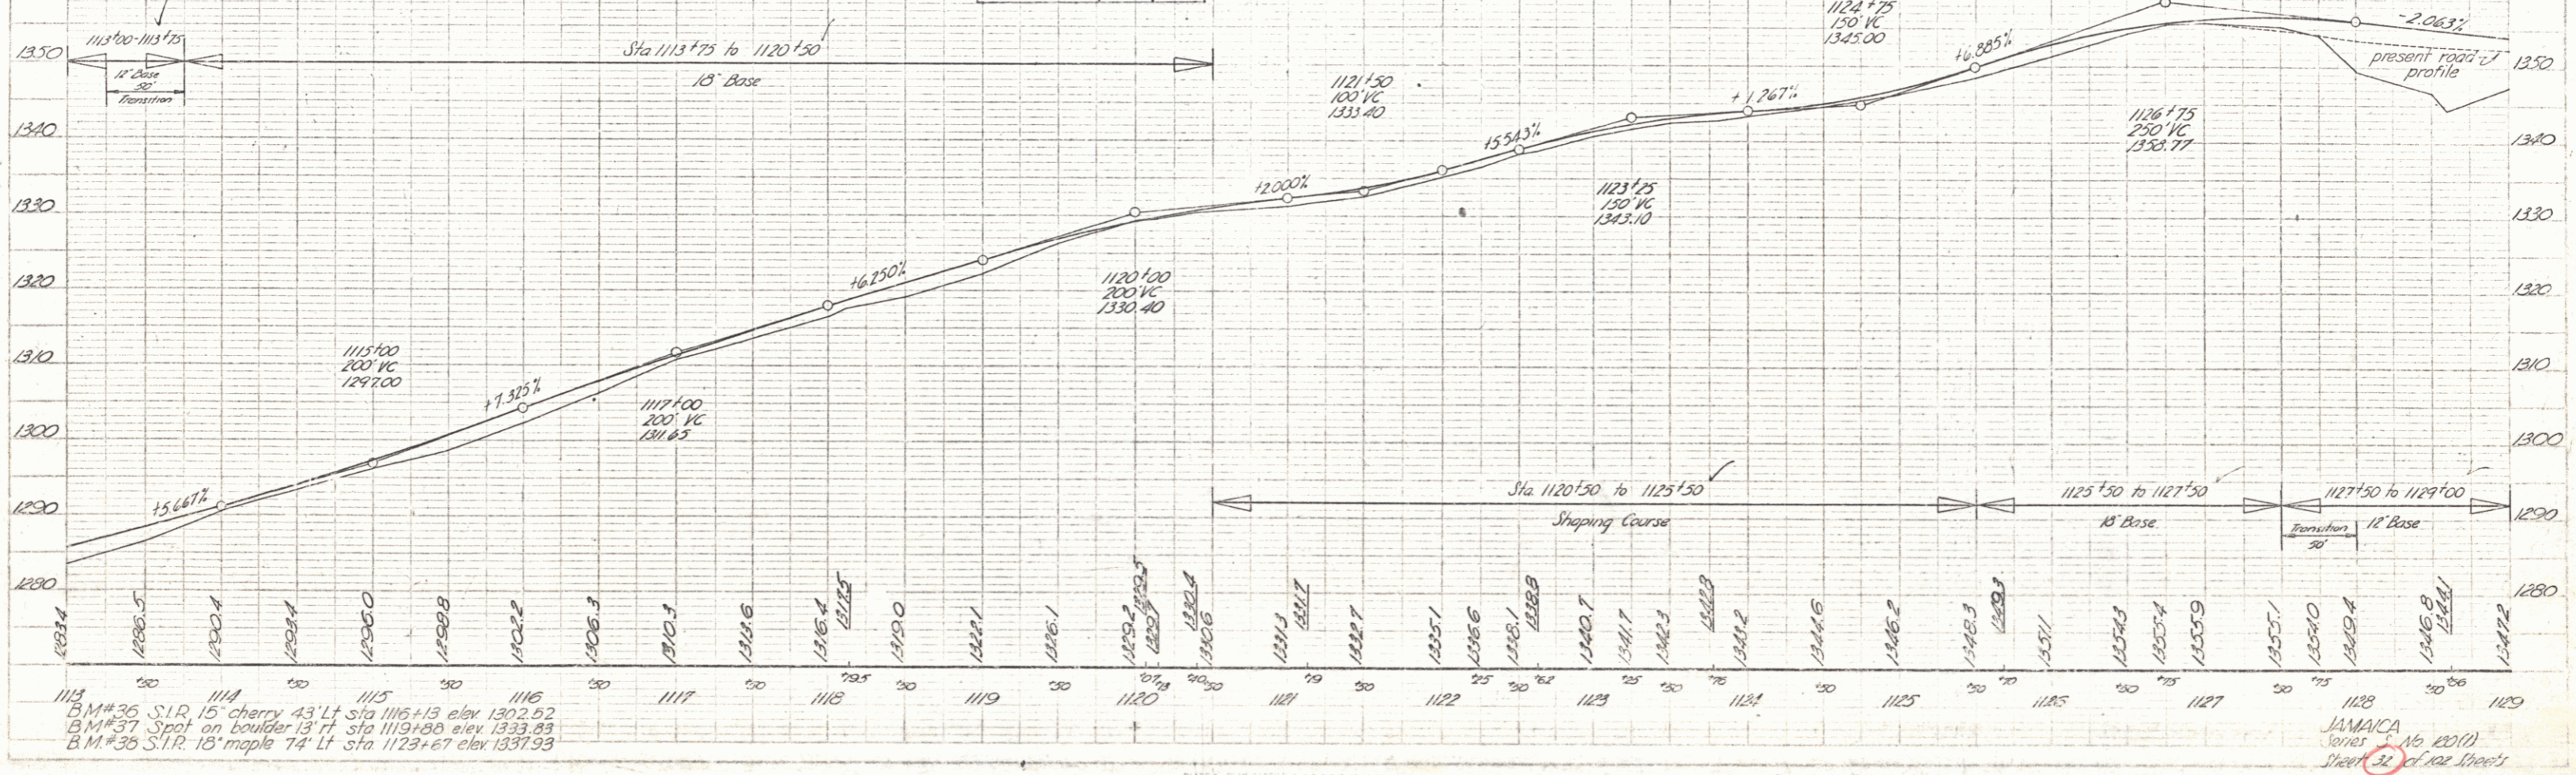

1113 B.M. #35 S.I.R. 15' cherry 43' Lt sta 1116+13 elev 1302.52
 1114 B.M. #37 Spot on boulder 13' Lt sta 1119+80 elev 1333.83
 1115 B.M. #38 S.I.R. 10' maple 74' Lt sta 1123+67 elev 1337.93

JAMAICA
 Jones No. 20(1)
 Street 31 of 102 Street