



THREE CABLE GUARD RAIL WITH STEEL POSTS
 LT RT
 104+05-114+99 105+40-105+72
 109+72-111+20 RP 105+72-105+72
 104+21-104+21 104+21-104+21

STEEL GUIDE POSTS - SPACED 16' +/-
 109+72-111+20 RP
 110+10-110+10 RT
 115+40-116+00 RT

REMOVAL AND DISPOSAL OF PRES. GUARD RAIL
 105+30-109+00 105+45-105+60
 113+52-114+82 106+27-106+47
 115+23-115+53 109+08-113+52

CONSTRUCT DRIVE
 105+88 RT ✓
 CONSTRUCT APPROACH
 104+75 RT ✓

DATE	7/24
BY	MILLER
CHECKED	
SCALE	
PROJECT	
TRACED	

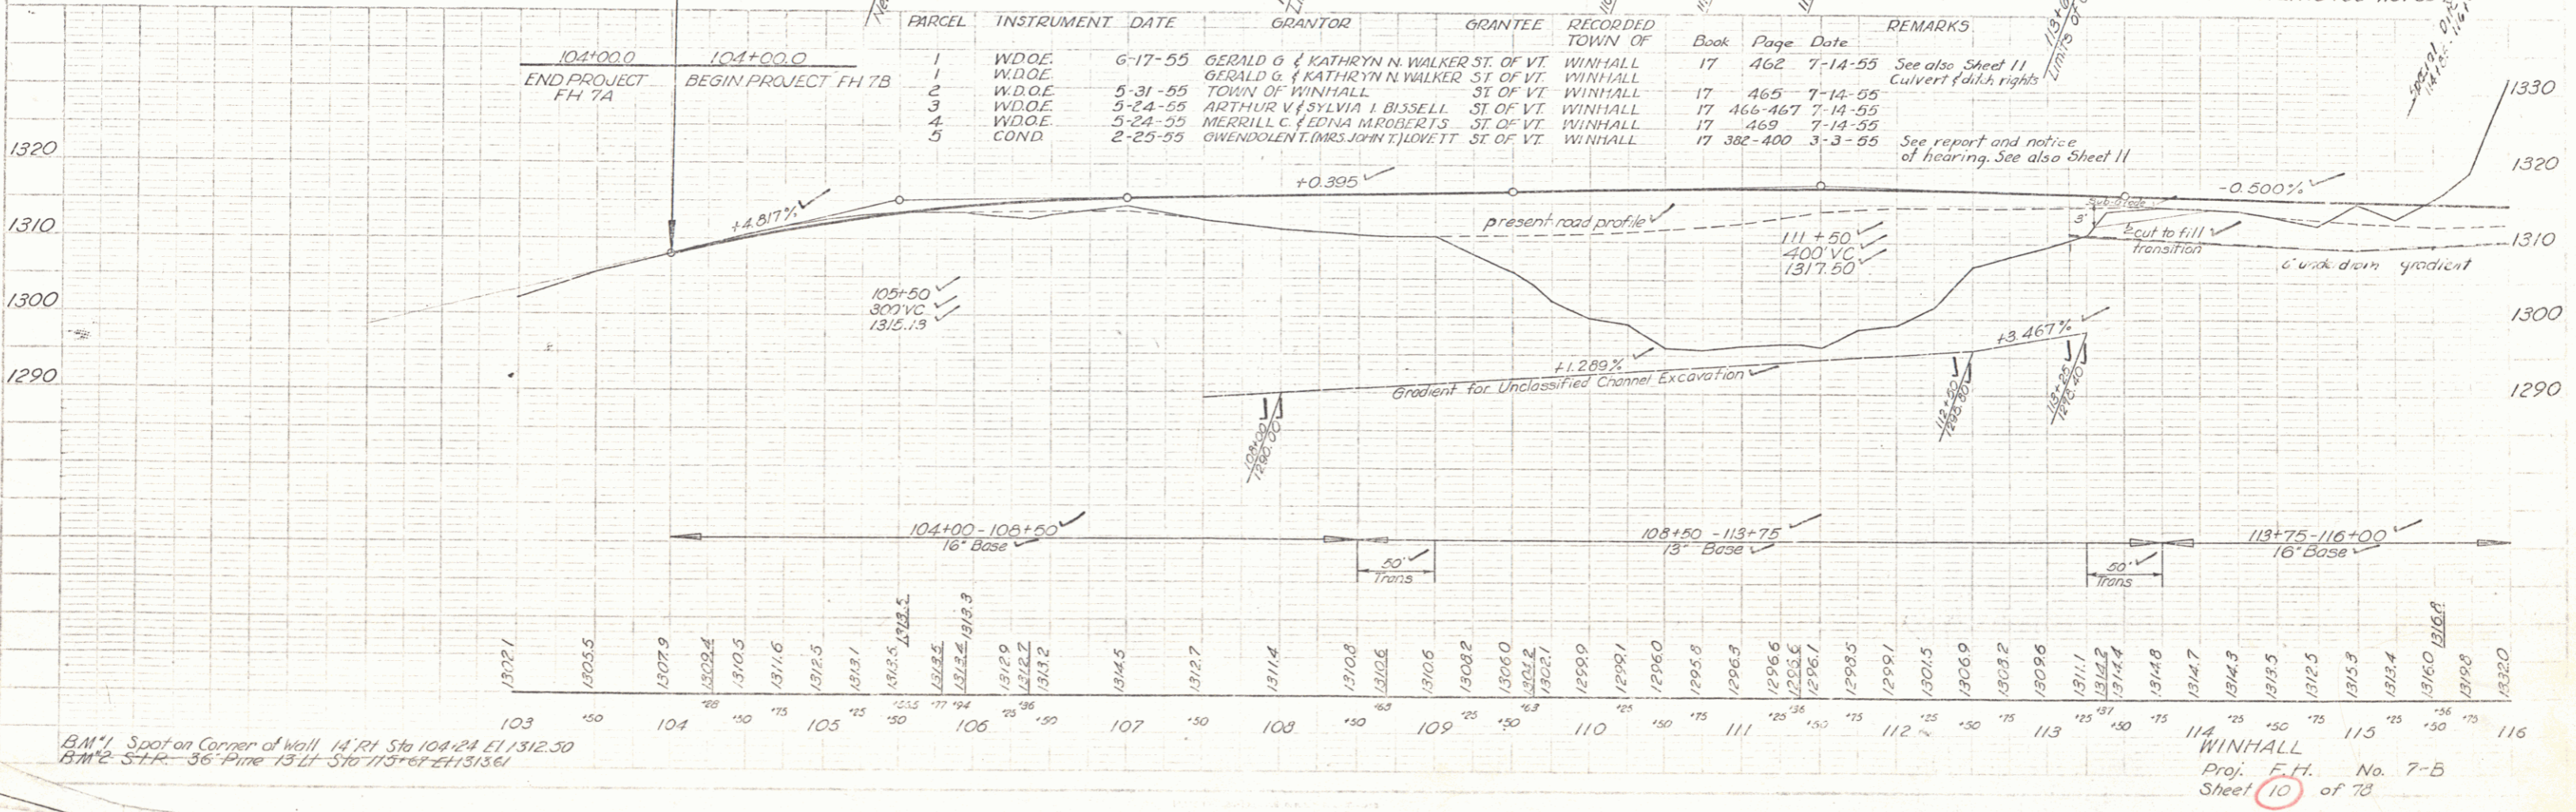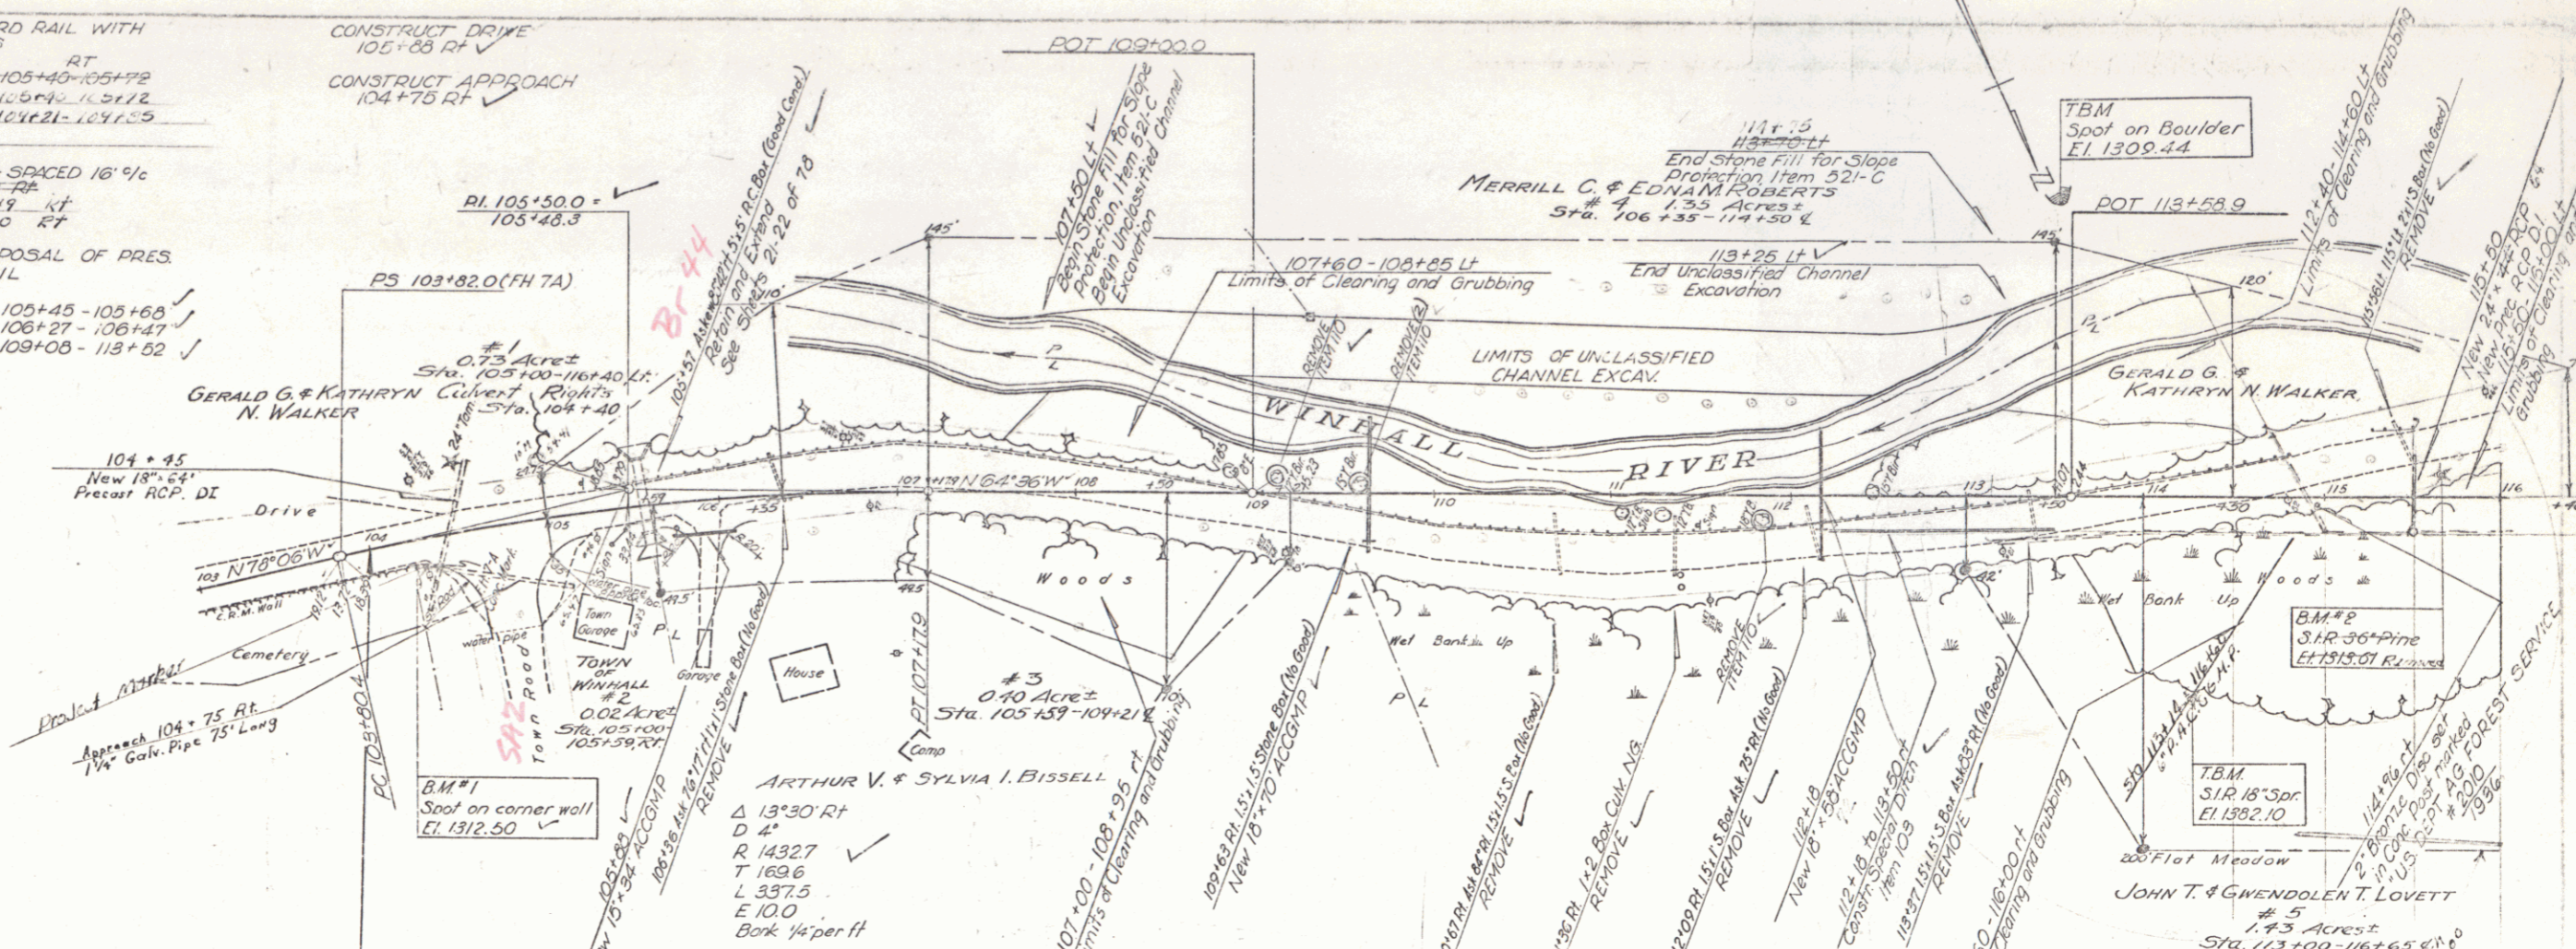

B.M. #1 Spot on corner of well 14' RT Sta 104+24 El 1312.50
 B.M. #2 Sta 114-36 Pine 1311.75 Sta 113+61 El 1313.61

WINHALL
 Proj. F.T. No. 7-B
 Sheet 10 of 73