

CONSTRUCT DRIVES
 142+00-143+25 RT
 143+25-145+00 LT
 145+00-150+00 LT


CONSTRUCT APPROACH
 144+50 RT
 150+00 LT

Center of section of old highway
 between station 141+00 - 60' RT
 and station 144+50 - 60' RT
 Replaced with new date
 141+00-144+50 E-30-57

USGS Marker #245
 TT 14 PDK 1942
 Lat 43° 02' 43.17"
 Long 72° 53' 48.93"
 (Withdrawn to scale)

PARCEL	INSTRUMENT	DATE	GRANTOR	GRANTEE	RECORDED TOWN OF	Book	Page	Date	REMARKS
13	W.D.O.E.	5-25-55	WILLIAM F. & INA L. COLEMAN	ST. OF VT.	WINHALL	17	476-477	7-14-55	See also Sheet 12
14	W.D.O.E.	5-24-55	ARCHIE W. & VERA MAGOON	ST. OF VT.	WINHALL	17	478-479	7-14-55	
15	W.D.O.E.	5-24-55	CARROLL R. & MAUDIE E. SLADE	ST. OF VT.	WINHALL	17	480-481	7-14-55	
16A,B,C	W.D.O.E.	5-24-55	WILLIAM J. & RUTH I. LIGHTFOOT	ST. OF VT.	WINHALL	17	481-482-483	7-14-55	See also Sheet 20 this project and Sheet 13 of 14 Project 543(2)
17A,B	W.D.O.E.	5-24-55	HAROLD & ELEANOR J. LEFURGY	ST. OF VT.	WINHALL	17	485-487	7-14-55	See also Sheet 15
18	W.D.O.E.	5-24-55	ERNEST O. & FLORENCE M. ALLEN	ST. OF VT.	WINHALL	17	488-489	7-14-55	See also Sheet 15

BRIDGE DATA
 Conc. Slab Bridge (Abut's NG)
 Overall Span 222'
 Clear Span 160'
 I-Span 148'
 Clear Height 4.5'
 Clear Roadway 18.0'

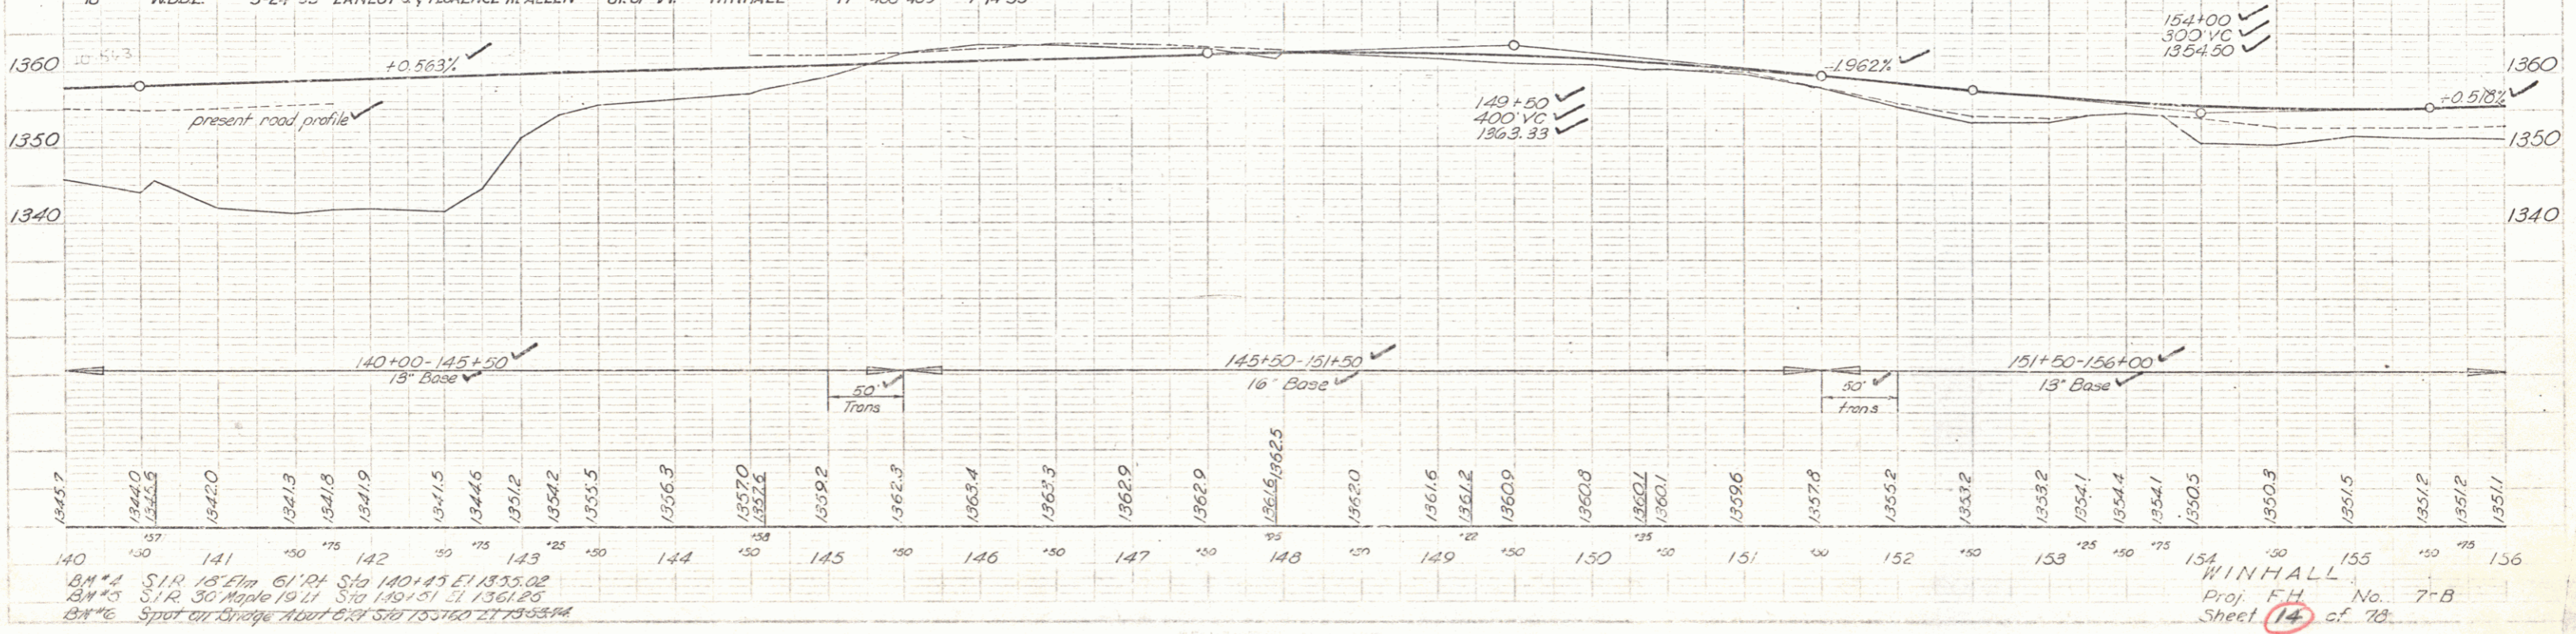

Station	Elevation
1345.7	1345.7
1346.0	1346.0
1346.5	1346.5
1347.0	1347.0
1347.3	1347.3
1347.8	1347.8
1348.1	1348.1
1348.9	1348.9
1349.5	1349.5
1349.6	1349.6
1350.2	1350.2
1350.5	1350.5
1350.9	1350.9
1351.2	1351.2
1351.5	1351.5
1351.8	1351.8
1352.2	1352.2
1352.5	1352.5
1352.8	1352.8
1353.2	1353.2
1353.8	1353.8
1354.1	1354.1
1354.4	1354.4
1354.7	1354.7
1355.0	1355.0
1355.3	1355.3
1355.8	1355.8
1356.3	1356.3
1356.5	1356.5
1356.8	1356.8
1357.2	1357.2
1357.5	1357.5
1357.8	1357.8
1358.2	1358.2
1358.5	1358.5
1358.8	1358.8
1359.2	1359.2
1359.5	1359.5
1359.8	1359.8
1360.0	1360.0

BM #4 S.I.R. 18' Elm 61' RT Sta 140+45 El 1355.02
 BM #5 S.I.R. 30' Maple 19' LT Sta 149+51 El 1361.25
 BM #6 Spot on Bridge Abut 61' RT Sta 151+70 El 1353.74

WINHALL
 Proj. FH No. 7-B
 Sheet 14 of 28