


PARCEL INSTRUMENT DATE	GRANTOR	GRANTEE	RECORDED TOWN OR	Book	Page	Date	REMARKS
1410	23 W.DOE	5-24-55 HOWARD F. JR. & DOROTHY D. WHITNEY	SI OF VT. WINHALL	18	1-2	7-14-55	
	24 W.DOE	5-24-55 HANS & ANNA SALO	SI OF VT. WINHALL	18	3-4	7-14-55	
	25 W.DOE	6-16-55 ERO W. & DORIS LANE	SI OF VT. WINHALL	18	105 B	1-9-56	
	26 W.DOE	5-24-55 LOUIE A. LAJOIE	SI OF VT. WINHALL	18	5-6	7-14-55	See also Sheet 18
	27 W.DOE	5-31-55 HAROLD L. & HOPE STANKE ROBERTS	SI OF VT. WINHALL	18	7-8	7-14-55	See also Sheet 18

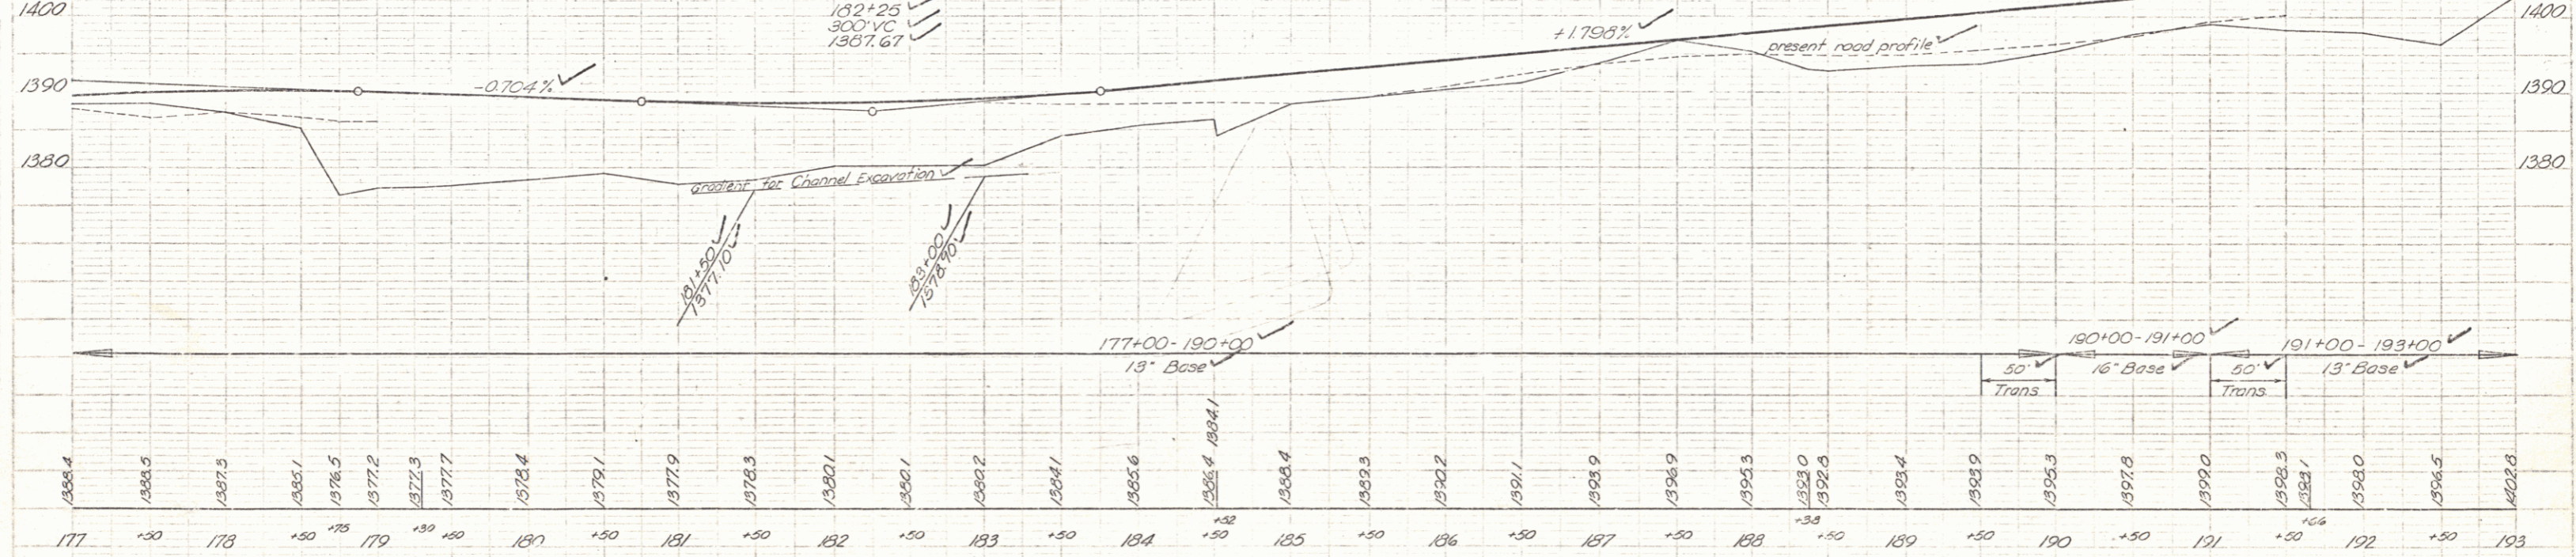

BM #8 S.I.R. 24' Stump Sta 177+53 37' Lt El 1390.33
 B.M. #9 Spot on Bridge Cor. Sta 191+78 72' Rt El 1399.16

WINHALL
 Proj. No. 78
 Sheet 17 of 78 Sheets