
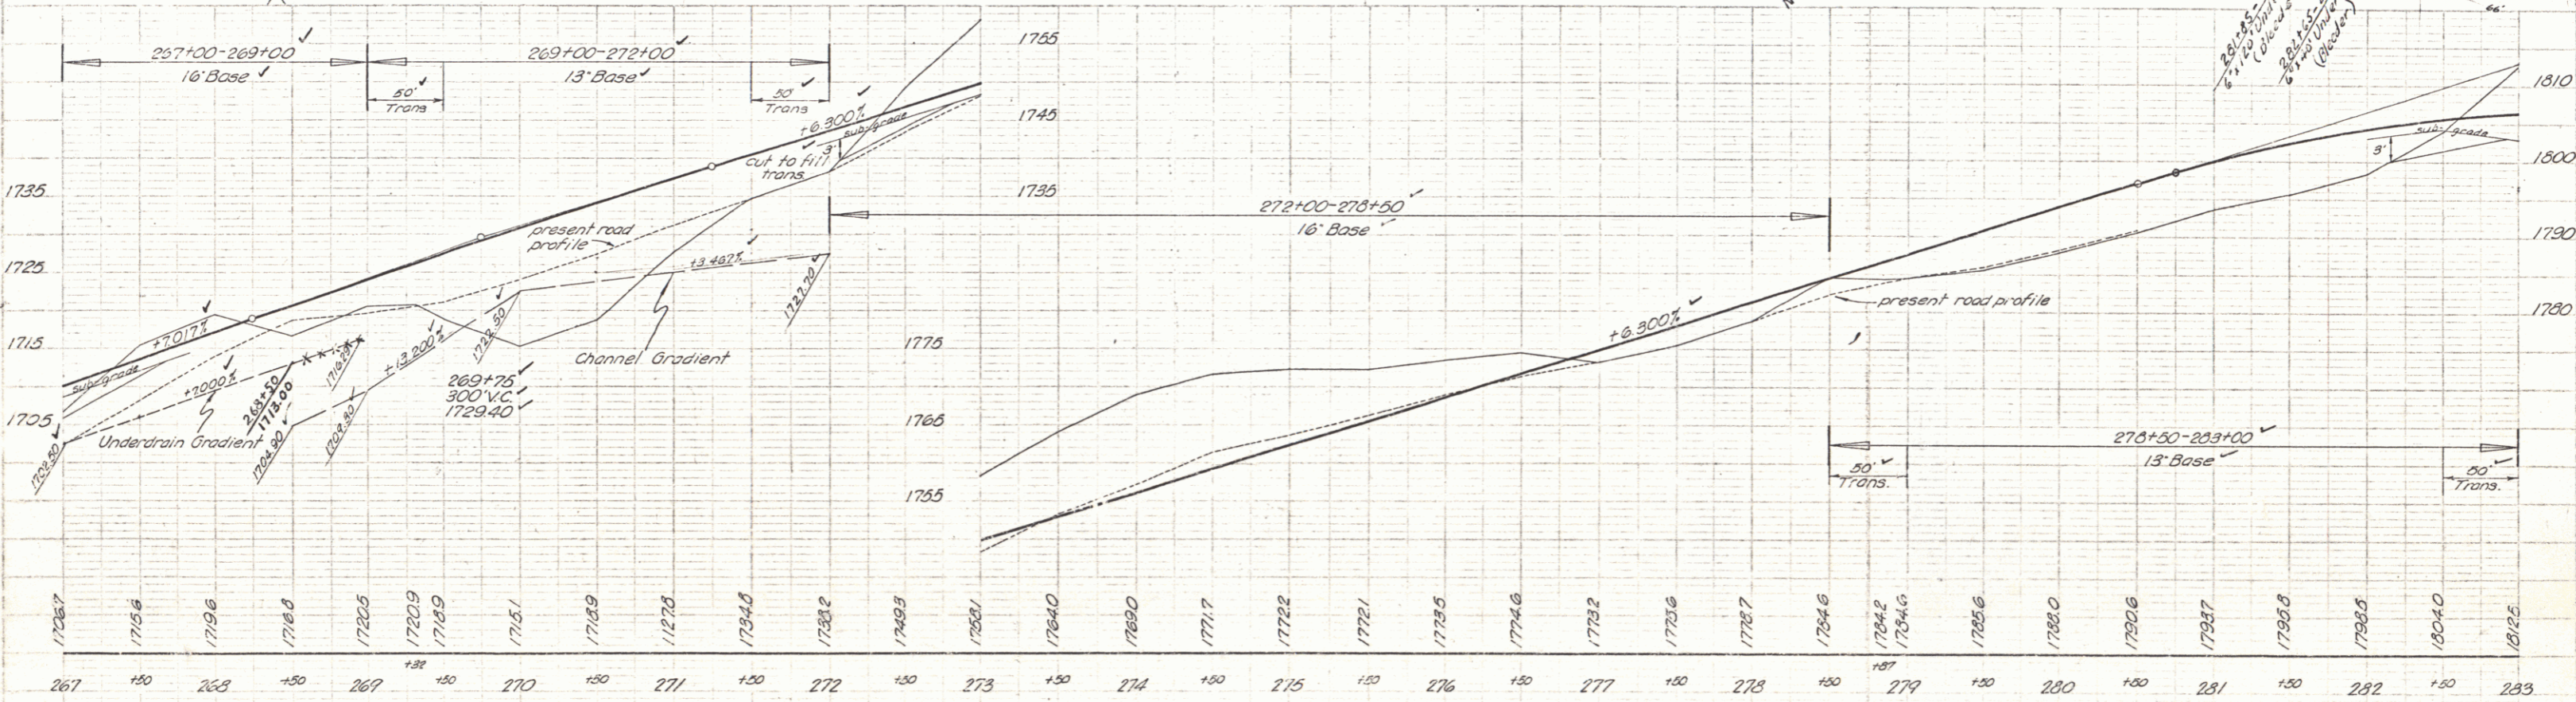


STEEL GUIDE POSTS
267+45-268+09 LT.

9-54
Abogar
M. Lencioni
12-50

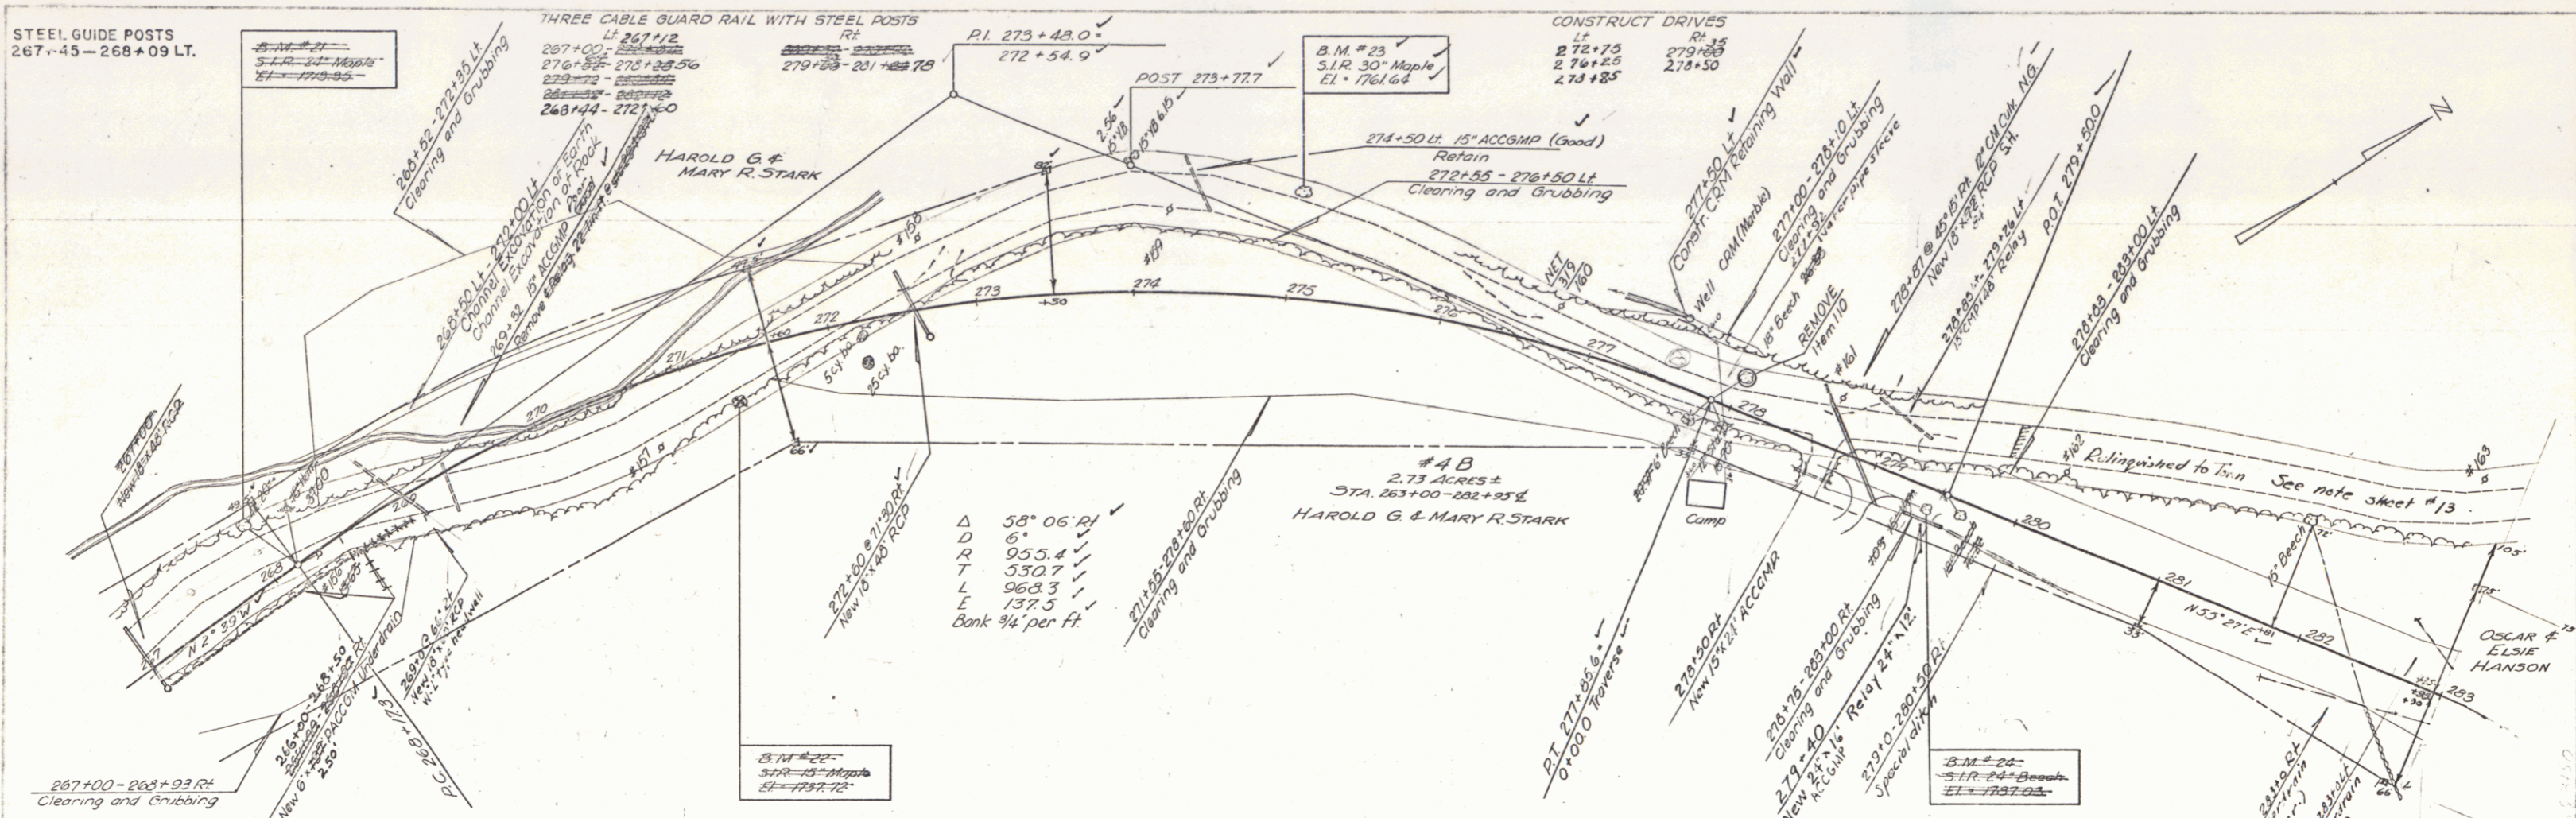

BM # 21 S1R 24 Maple Sta 267+04.41 Ht. 1713.55
 BM # 22 S1R 15 Maple Sta 271+31.30 Ht. 1731.72
 BM # 23 S1R 30 Maple Sta 275+04.72 Ht. 1761.64
 BM # 24 S1R 24 Maple Sta 277+40.14 Ht. 1761.03

WINHALL
Project 6119 23(1)
Sheet 17 of 120