
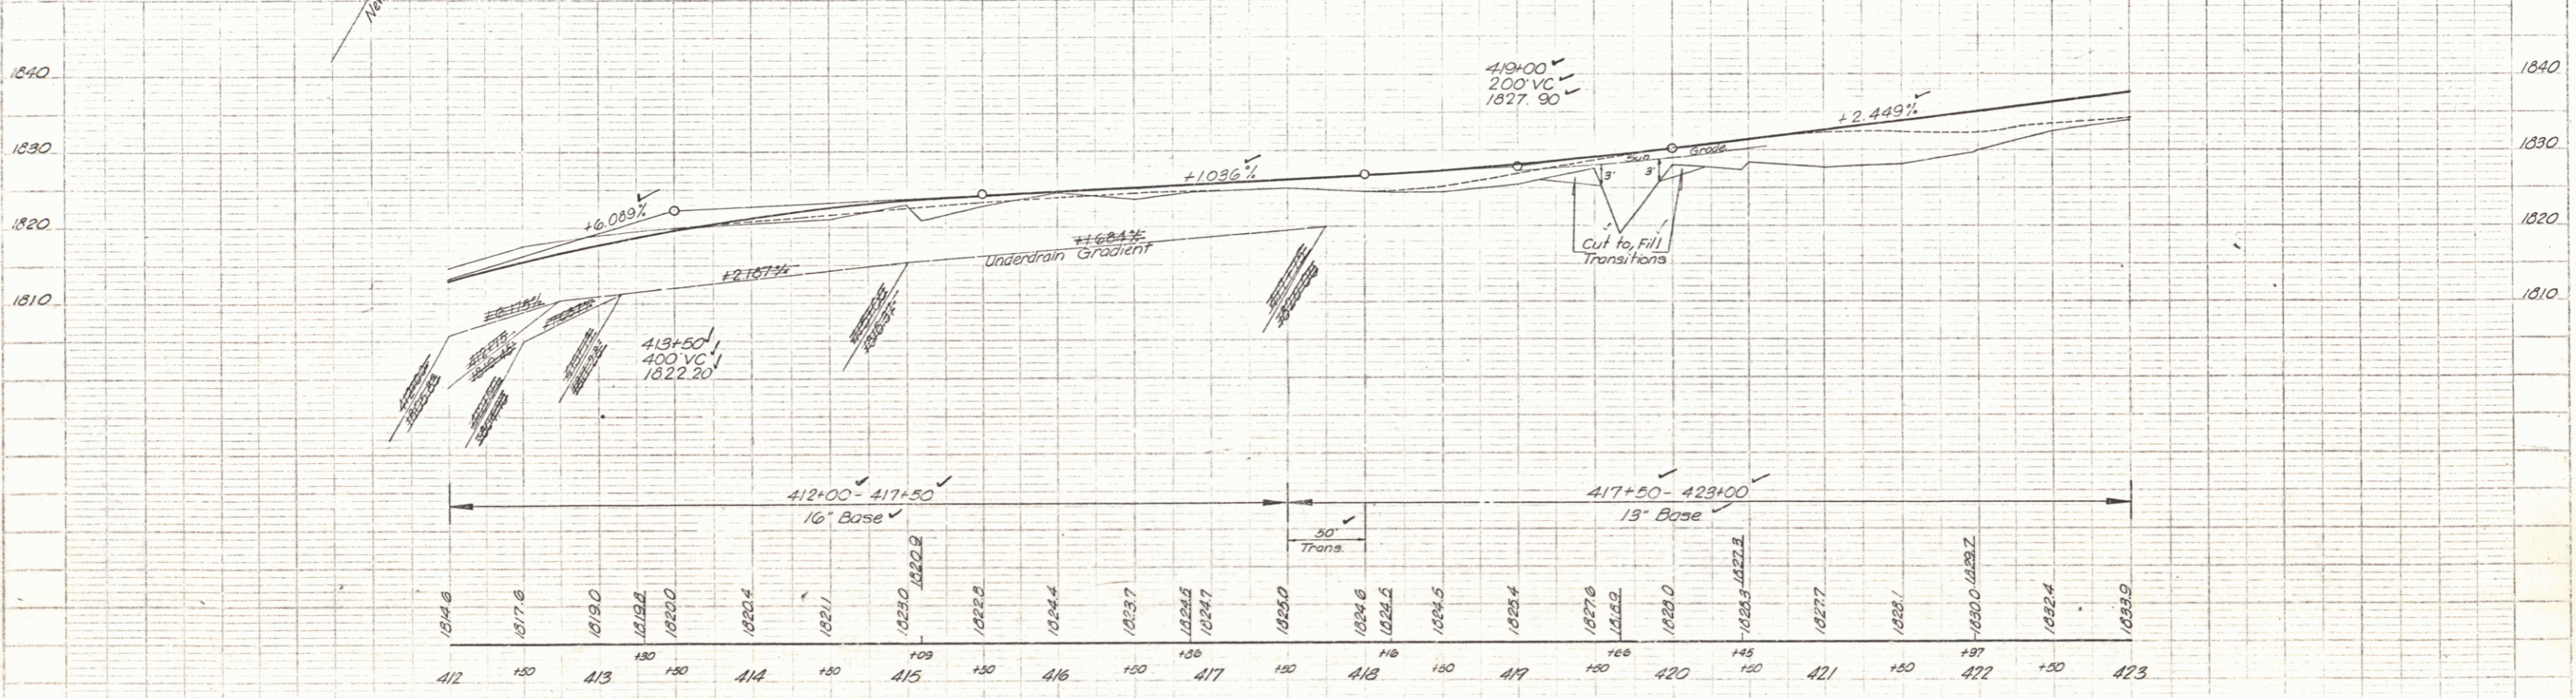


STEEL GUIDE POSTS  
 413+50 - 414+23 RT  
 THREE CABLE GUARD RAIL WITH STEEL POSTS  
 414+00 - 421+50 RT  
 Turnouts Constructed  
 414+0 RT  
 419+0 - 421+50 LT

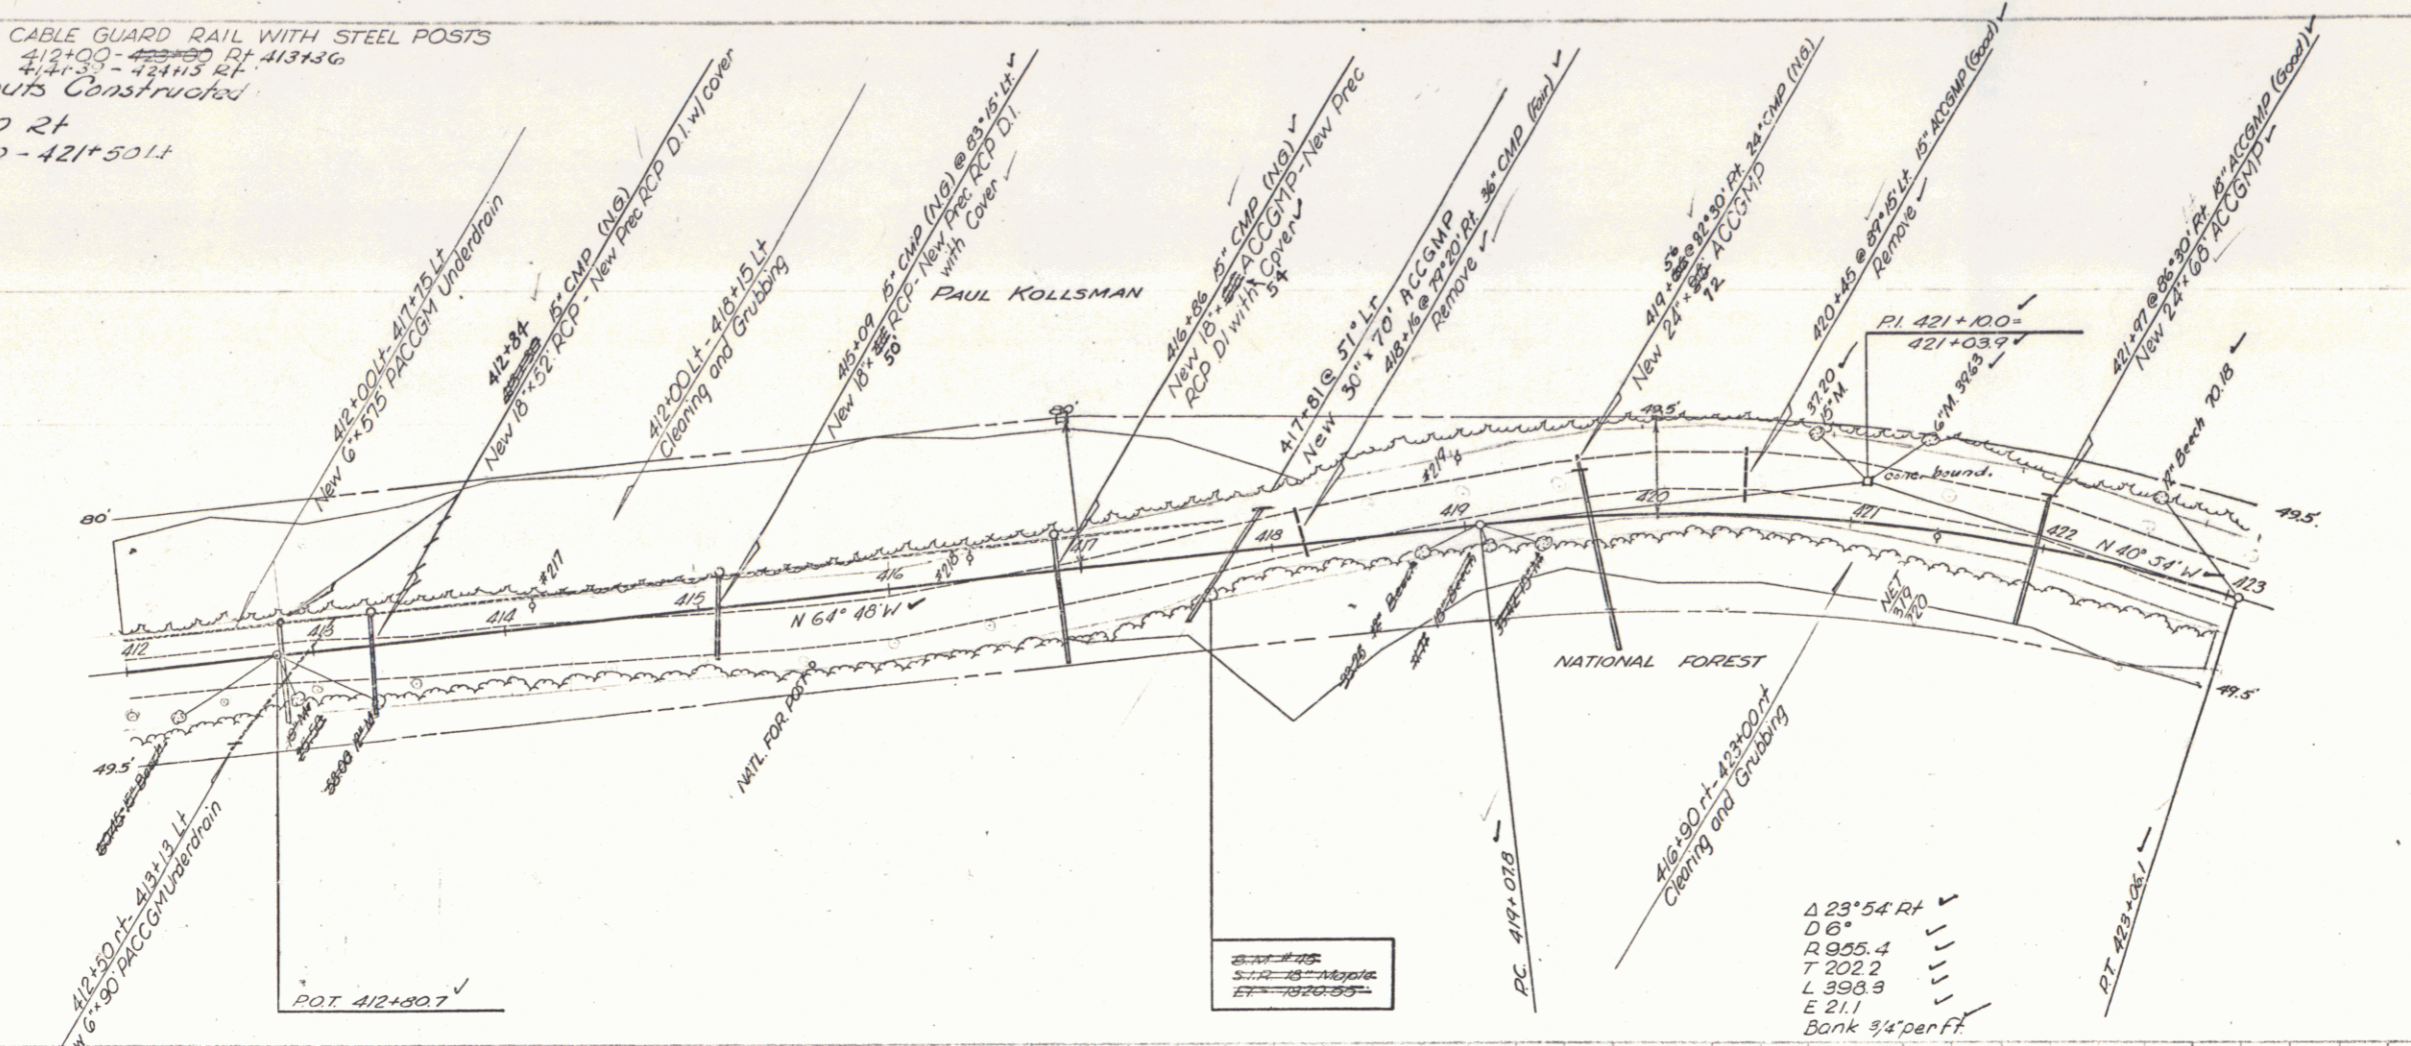

Project  
 Location  
 Date

Checked  
 Drawn  
 Date

412+50 RT 1814.6  
 413+00 RT 1817.6  
 413+50 RT 1819.0  
 414+00 RT 1820.0  
 414+50 RT 1820.4  
 415+00 RT 1821.1  
 415+50 RT 1822.0  
 416+00 RT 1822.8  
 416+50 RT 1824.4  
 417+00 RT 1825.7  
 417+50 RT 1826.5  
 418+00 RT 1827.1  
 418+50 RT 1828.0  
 419+00 RT 1828.6  
 419+50 RT 1829.5  
 420+00 RT 1829.4  
 420+50 RT 1827.6  
 421+00 RT 1827.0  
 421+50 RT 1828.5  
 422+00 RT 1827.7  
 422+50 RT 1828.1  
 423+00 RT 1829.0  
 423+50 RT 1829.4  
 424+00 RT 1829.9

WINHALL  
 Project 521043(L)  
 Sheet 30 of 100