


FED. ROAD DIST. NO.	STATE	F.S. NO.	F.S. YEAR	SHEET NO.	TOTAL SHEETS
	VT	437	1943	6	36

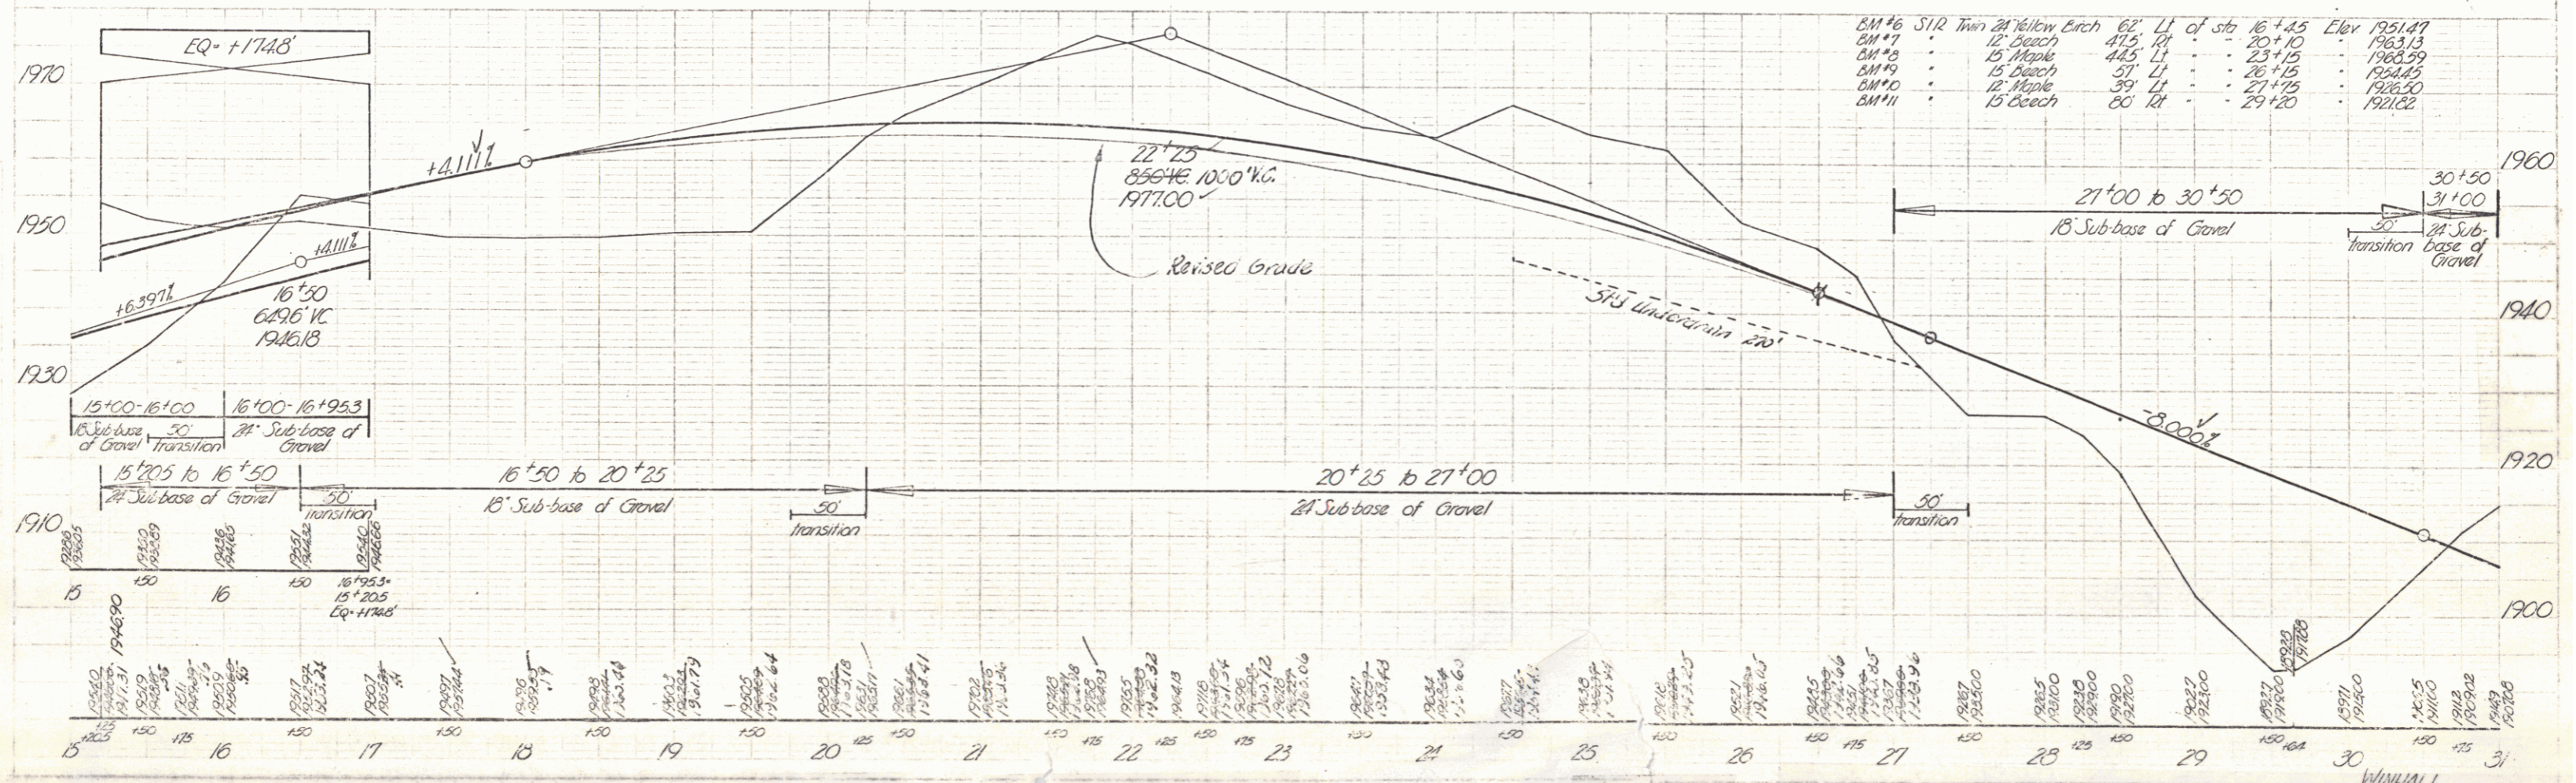

B.M. #6	SIR	Tree	24' Yellow Birch	62'	LI of sta	16+45	Elev	1951.47
B.M. #7			12' Beech	47.5'	TL	20+10		1963.13
B.M. #8			15' Maple	44.5'	LI	23+15		1968.59
B.M. #9			15' Beech	51'	LI	26+15		1964.45
B.M. #10			12' Maple	39'	LI	27+15		1968.30
B.M. #11			15' Beech	60'	TL	29+20		1921.82

WINNALL
SERIES 6AS NO. 43 (1)
Sheet 6 of 36 Sheets
3