

CONSTRUCT DIRT  
106+50

THREE CABLE GUARD RAIL  
WITH STEEL POSTS  
112+25-112+73


DRILLING AND BLASTING OF  
SOLID ROCK SUBGRADE  
104+75-105+75  
106+75-10+75  
115+00-115+00

DEMOLITION AND DISPOSAL  
OF BUILDING  
108+00-117+50

EXCAVATION AND REMOVAL OF  
ROAD SURFACE ON LEADWAY  
104+50-110+00

UNASSISTED CHANNEL FOUNDATION  
(East Side of the West River)  
116+50-115+00  
See sheets 124, 125 and 126 sheets


REMOVAL AND DISPOSAL  
OF PRESENT GUARD RAIL  
103+25-110+50  
112+10-112+00  
112+25-112+35  
113+60-115+00

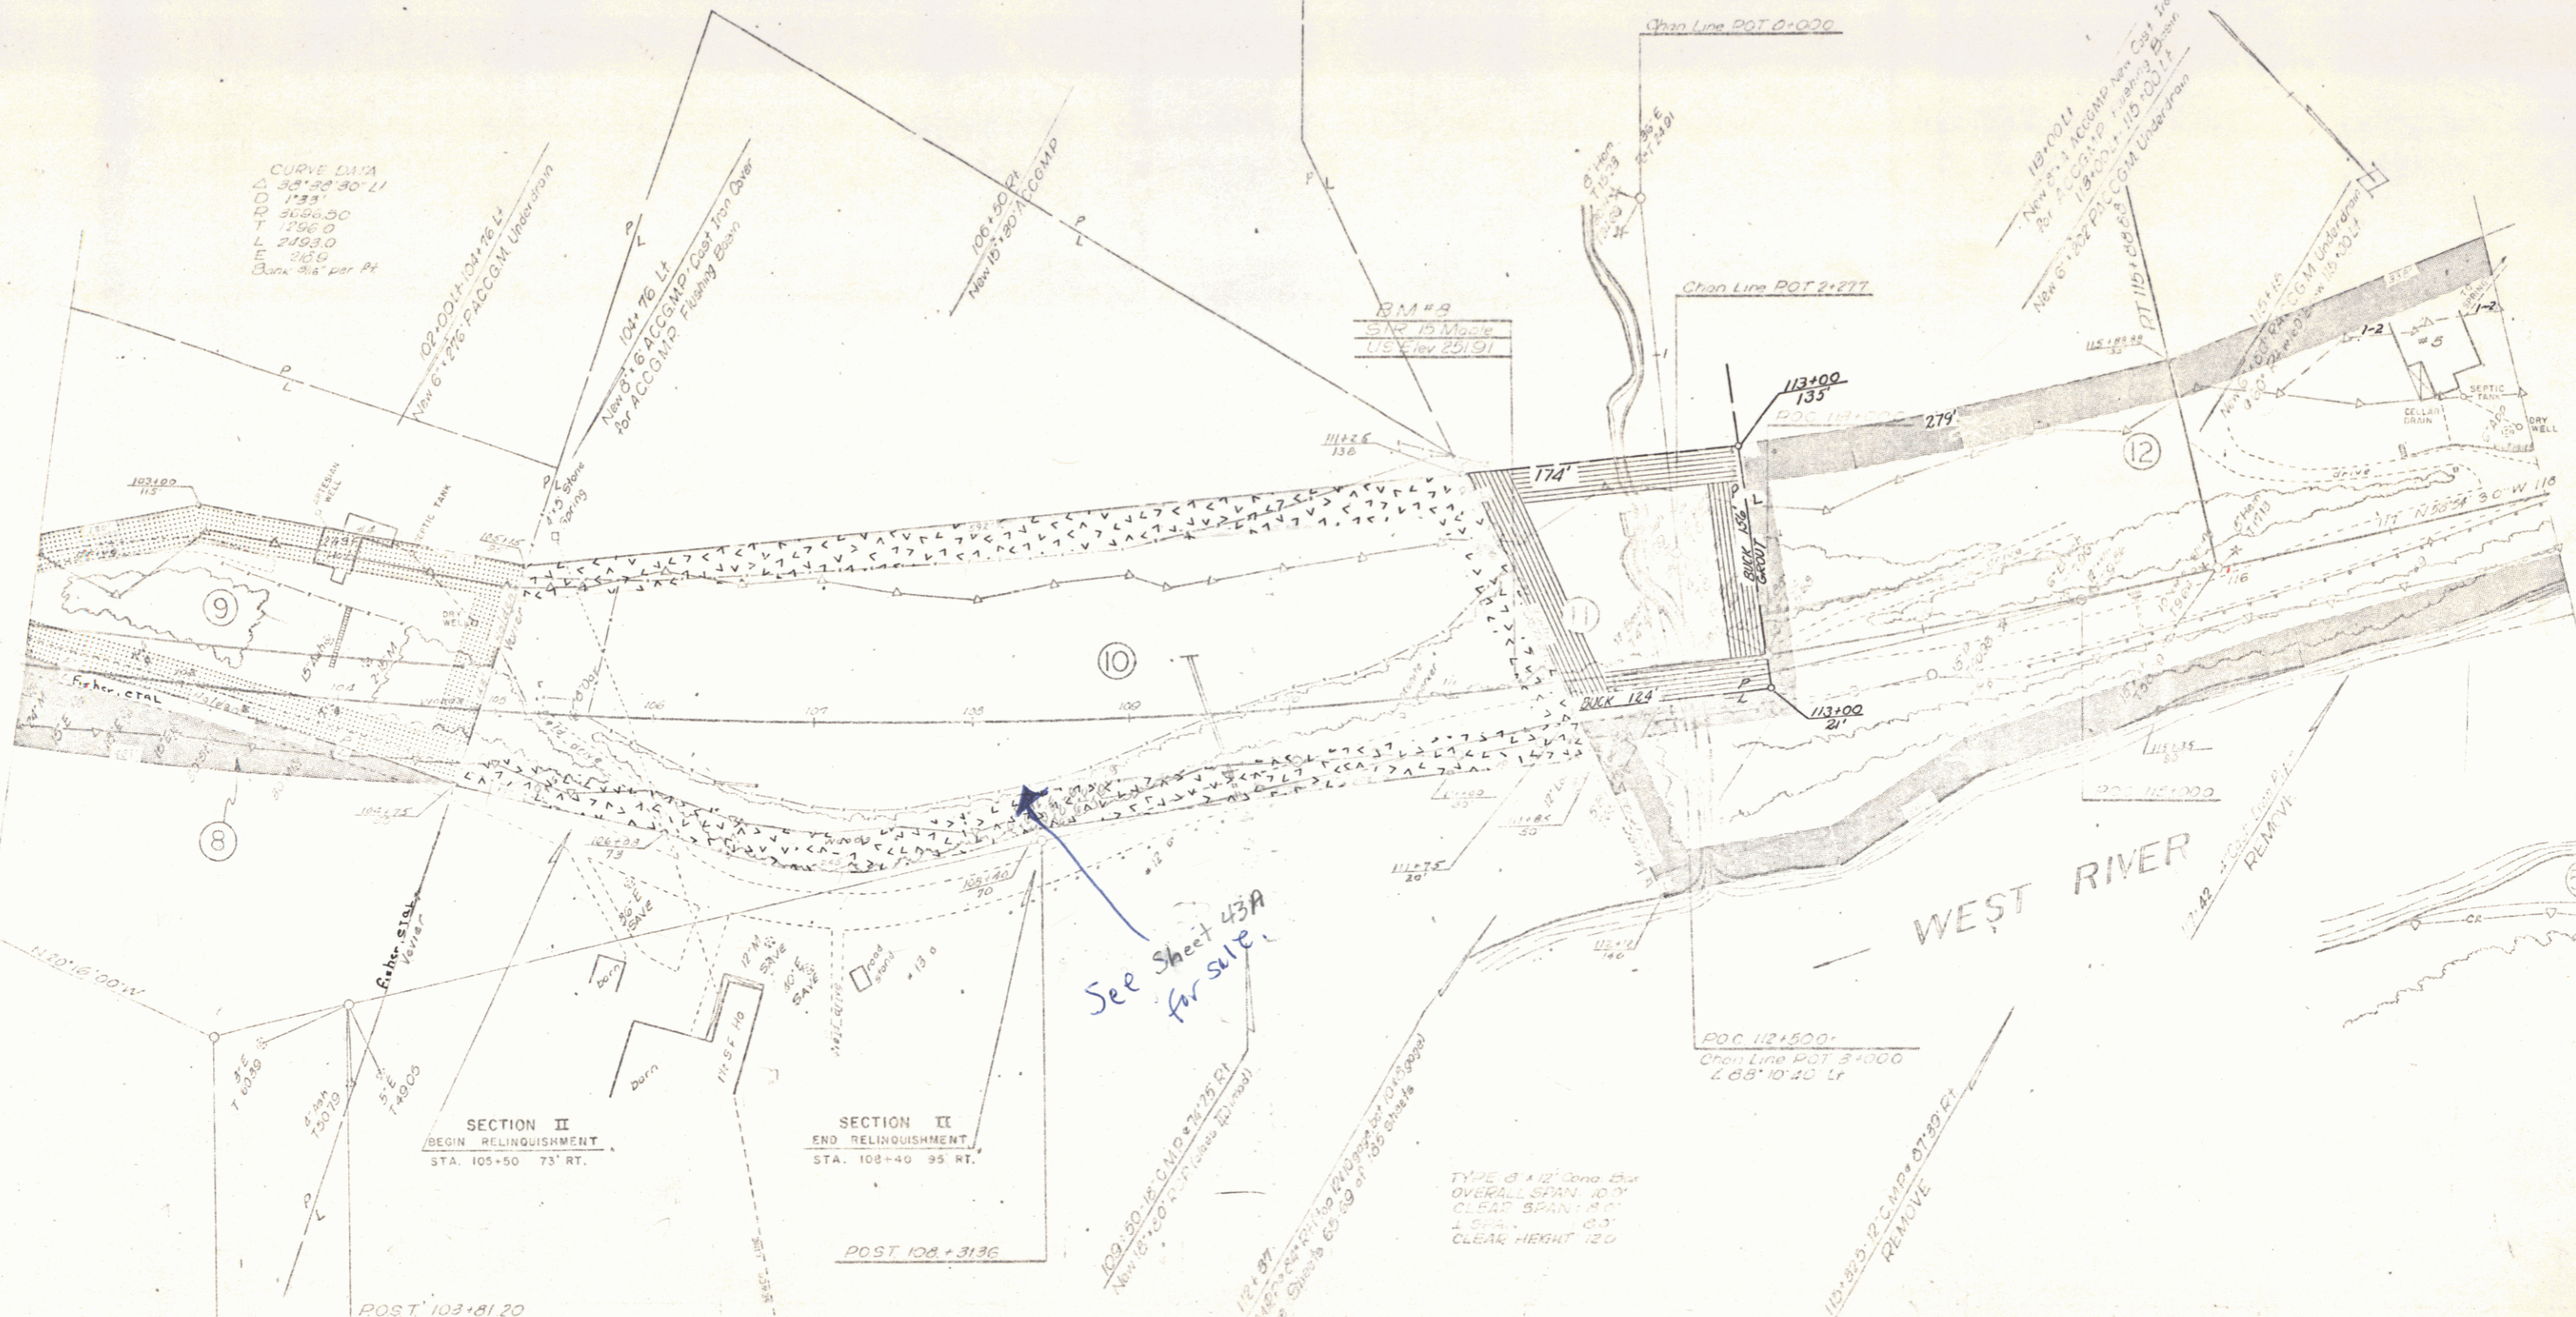

See Sheet 43A  
for sale

- LIST OF BRIDGE SHEETS
- Sheet 126a
  - Sheet 126b
  - Sheet 126c
  - Sheet 126d
  - Sheet 126e
  - Sheet 126f
  - Sheet 126g
  - Sheet 126h
  - Sheet 126i
  - Sheet 126j
  - Sheet 126k
  - Sheet 126l
  - Sheet 126m
  - Sheet 126n
  - Sheet 126o
  - Sheet 126p
  - Sheet 126q
  - Sheet 126r
  - Sheet 126s
  - Sheet 126t
  - Sheet 126u
  - Sheet 126v
  - Sheet 126w
  - Sheet 126x
  - Sheet 126y
  - Sheet 126z

POOR ORIGINAL COPY

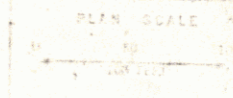

BRATTLEBORO DAMMERSION  
Project No. 43